


3901928P

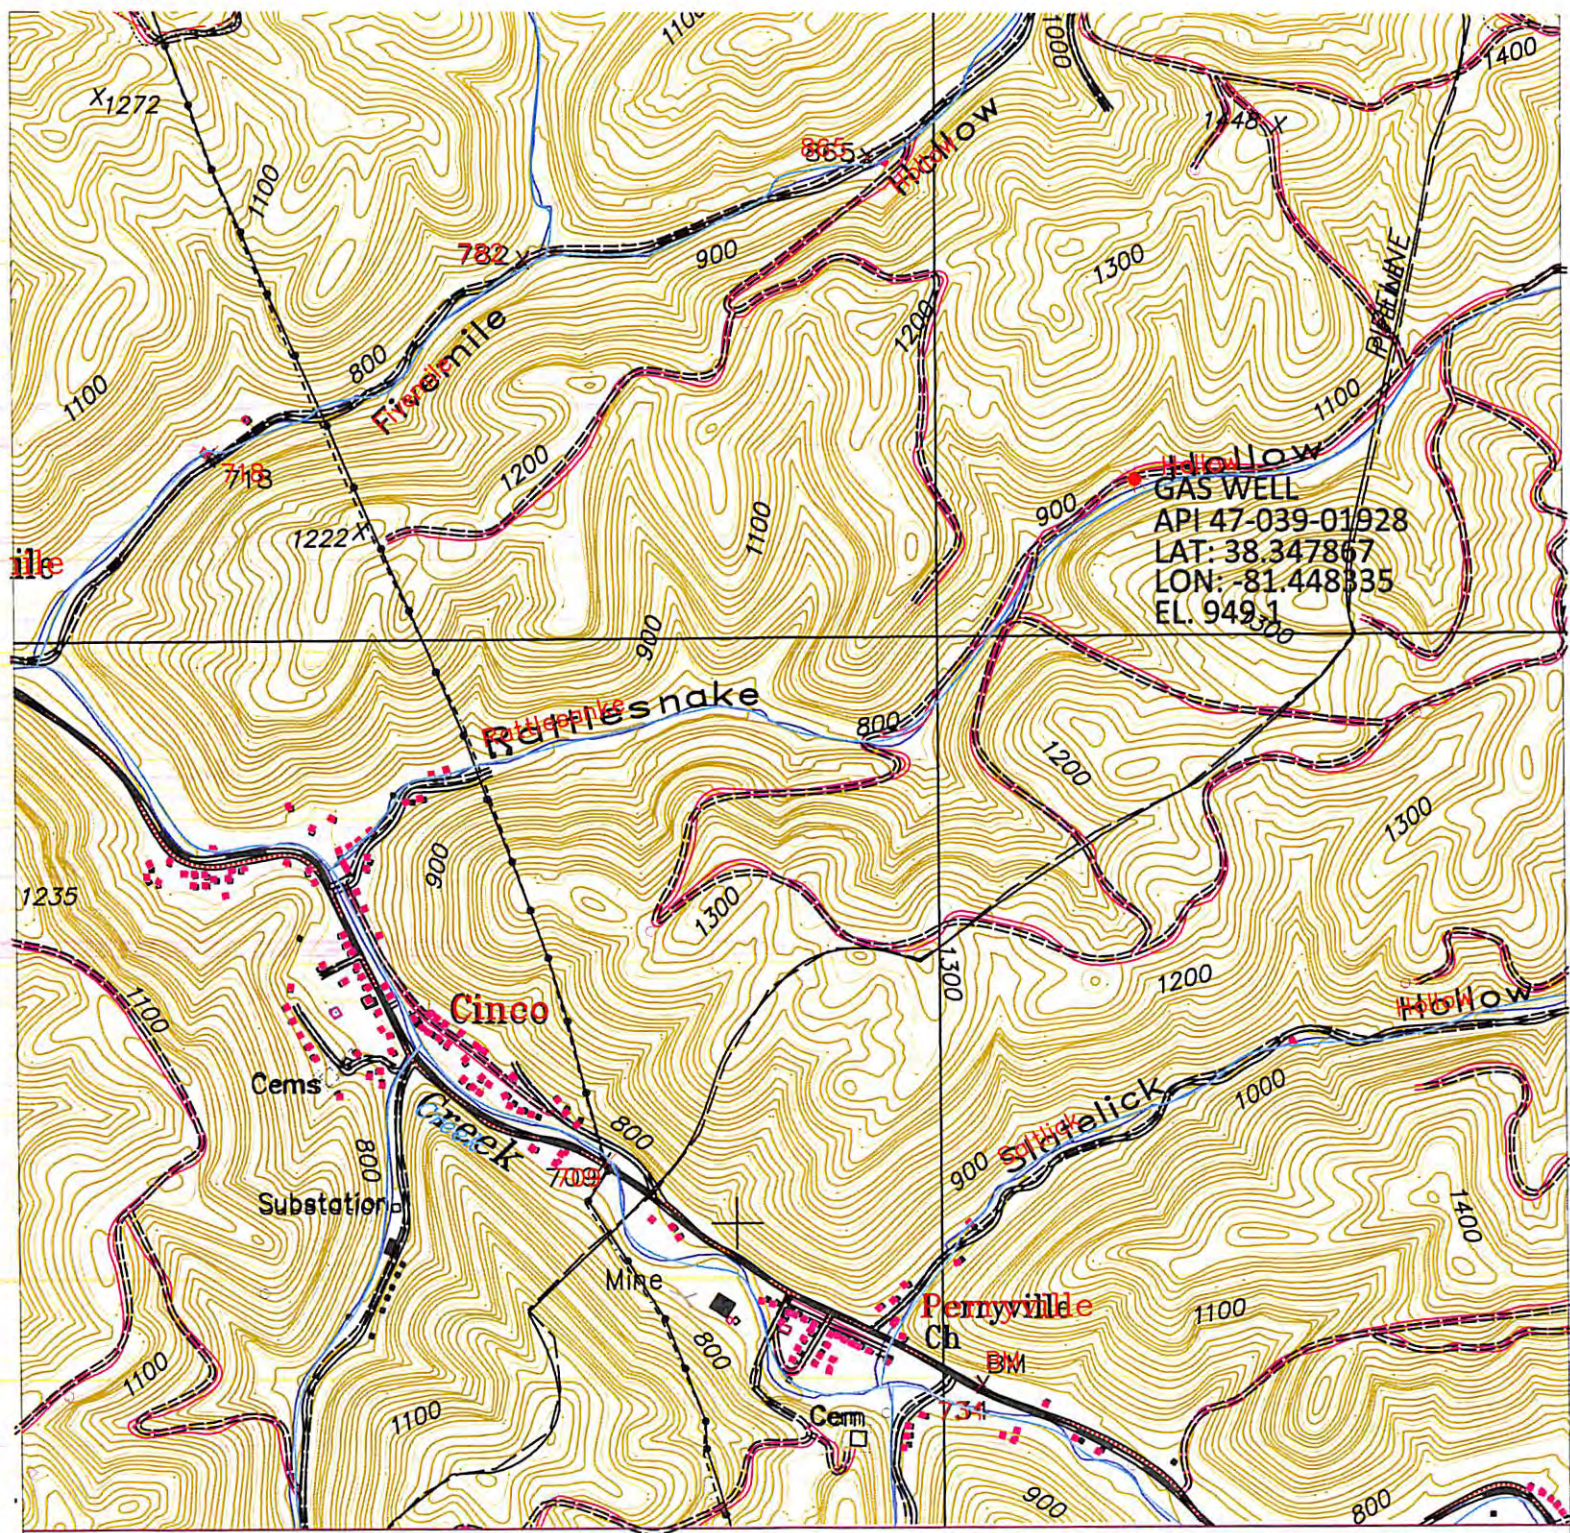

REFERENCES:
 1. 7.5 MIN. U.S.G.S. TOPOGRAPHIC MAP
 OF QUICK QUADRANGLE, WEST VIRGINIA
 2. COORDINATES WEST VIRGINIA SOUTH-NAD 27

GAS WELL LOCATION MAP
API NO. 47-039-01928
MALDEN DISTRICT
KANAWHA COUNTY, WEST VIRGINIA

RECEIVED
 Office of Oil and Gas
 APR 03 2017
 WV Department of
 Environmental Protection
 04/28/2017