

LATITUDE 38°25'00"

4,115'

LONGITUDE 81°25'00"

7,450'

GAS WELL

GAS WELL

CONNIE SHAFFER
DEED BOOK 1746 PAGE 466
TAX MAP 39 PARCEL 90.1

UTM METERS (NAD83)
N-4249874.59
E-462376.44

LAT.=38°23'46.32"
LONG.=81°25'51.65"

WELL #12079

HANSHAW ROAD
ROUTE 902/23

2" IRON PIPE

815'
N 85°06' E

2" IRON PIPE

7.5 LOC.

N 84°32' E
368'

CARLOS HIVELY
DEED BOOK 1781 PAGE 573
TAX MAP 39 PARCEL 90.2

PERRY CEMETERY
DEED BOOK 455 PAGE 263
TAX MAP 39 PARCEL 89


SECONDARY ROUTE 49/2

JOHNNY P. & THELMA R.
JACKSON
DEED BOOK 1718 PAGE 574
TAX MAP 39 PARCEL 90

(+) DENOTES LOCATION OF WELL ON UNITED STATES TOPOGRAPHIC MAPS REVISED 6/5/13

FILE No 13-100-010
DRAWING No. 13-100-010
SCALE 1"=500'
MINIMUM DEGREE OF ACCURACY 1:200
PROVEN SOURCE OF ELEVATION TRIMBLE PRO XH
GPS UNIT

I THE UNDERSIGNED, HEREBY CERTIFY THAT THIS PLAT IS CORRECT TO THE BEST OF MY KNOWLEDGE AND BELIEF AND SHOWS ALL THE INFORMATION REQUIRED BY LAW AND THE REGULATIONS ISSUED AND PRESCRIBED BY THE DIVISION OF ENVIRONMENTAL PROTECTION.
(SIGNED) Jason L. Woods 6-6-13
JASON L. WOODS PS #2174

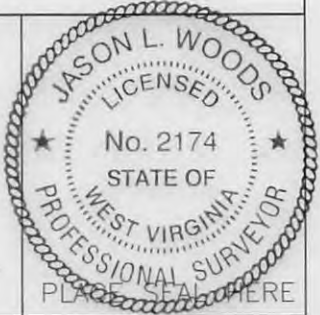

STATE OF WEST VIRGINIA
DIVISION OF ENVIRONMENTAL PROTECTION
OFFICE OF OIL AND GAS
NITRO, WV



DATE APRIL 19 2013
OPERATOR'S WELL No. 12079
API WELL No. 47 039 -02816 R

WELL TYPE: OIL GAS LIQUID INJECTION WASTE DISPOSAL
(IF "GAS") PRODUCTION STORAGE DEEP SHALLOW
LOCATION: ELEVATION 1115 WATER SHED FALLING ROCK CREEK
DISTRICT ELK COUNTY KANAWHA
QUADRANGLE BLUE CREEK

SURFACE OWNER JOHNNY P. & THELMA R. JACKSON ACREAGE 10.19
OIL & GAS ROYALTY OWNER J. H. PERRY, ET UX LEASE ACREAGE 162
LEASE No. 11347

PROPOSED WORK: DRILL CONVERT DRILL DEEPER REDRILL FRACTURE OR STIMULATE PLUG OFF OLD FORMATION PERFORATE NEW FORMATION OTHER PHYSICAL CHANGE IN WELL (SPECIFY) FRAC

PLUG AND ABANDON CLEAN OUT AND REPLUG
TARGET FORMATION ORISKANY ESTIMATED DEPTH 5450
WELL OPERATOR COLUMBIA GAS TRANSMISSION, LLC DESIGNATED AGENT PAUL AMICK
ADDRESS PO BOX 1273, CHARLESTON, WV ADDRESS P.O. BOX 1273, CHARLESTON W.V.
25325-1273 25325-1273

FORM IV-6 (8-78)

06/14/2013

2902816R

(ROMANCE)



BLUE CREEK QUADRANGLE
WEST VIRGINIA
TOPOGRAPHIC SERIES

(CLIO)



Recd
MAY 15 2013
Copyright of Environmental Protection Agency
Copyright of Oil and Gas


(BIG CHIMNEY)

(GLENDEIN)

(CHARLESTON EAST)

(MAMMOTH)

Produced by MyTopo Terrain Navigator
Topography based on USGS 1:24,000 Maps
North American 1983 Datum (NAD83)
Polyconic Projection
To place on the predicted North American 1927 move the
projection lines 11M N and 14M E

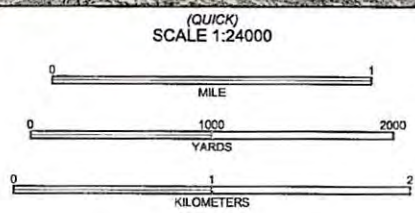

CONTOUR INTERVAL 20 FEET
NATIONAL GEODETIC VERTICAL DATUM 1929

BLUE CREEK, WV
1957