3903357P

WW-7
8-30-06

West Virginia Department of Environmental Protection
Office of Oil and Gas
WELL LOCATION FORM: GPS

API: 47-039-03357 **WELL NO.:** WV 151911 (J. Orlandi #1)

FARM NAME: Joseph Orlandi

RESPONSIBLE PARTY NAME: EQT Production Company

COUNTY: Kanawha **DISTRICT:** Cabin Creek

QUADRANGLE: Belle 7.5'

SURFACE OWNER: Orlandi Inc.

ROYALTY OWNER: Orlandi Inc., et al.

UTM GPS NORTHING: 4229656

UTM GPS EASTING: 452935 **GPS ELEVATION:** 321 m (1054 ft)

The Responsible Party named above has chosen to submit GPS coordinates in lieu of preparing a new well location plat for a plugging permit or assigned API number on the above well. The Office of Oil and Gas will not accept GPS coordinates that do not meet the following requirements:

1. Datum: NAD 1983, Zone: 17 North, Coordinate Units: meters, Altitude: height above mean sea level (MSL) – meters.
2. Accuracy to Datum – 3.05 meters
3. Data Collection Method:

Survey grade GPS ____: Post Processed Differential ____
Real-Time Differential ____
Mapping Grade GPS X : Post Processed Differential X
Real-Time Differential ____

4. **Letter size copy of the topography map showing the well location.**

I the undersigned, hereby certify this data is correct to the best of my knowledge and belief and shows all the information required by law and the regulations issued and prescribed by the Office of Oil and Gas.

Signature	Title	Date
	PS # 2180	6/5/14

3903357P

Topo Quad:	Belle 7.5'	Scale:	1 " = 2000'
County:	Kanawha	Date:	May 12, 2014
District:	Cabin Creek	Project No:	52-14-00-07

47-039-03357 WV 151911 (J. Orlandi #1)

Topo

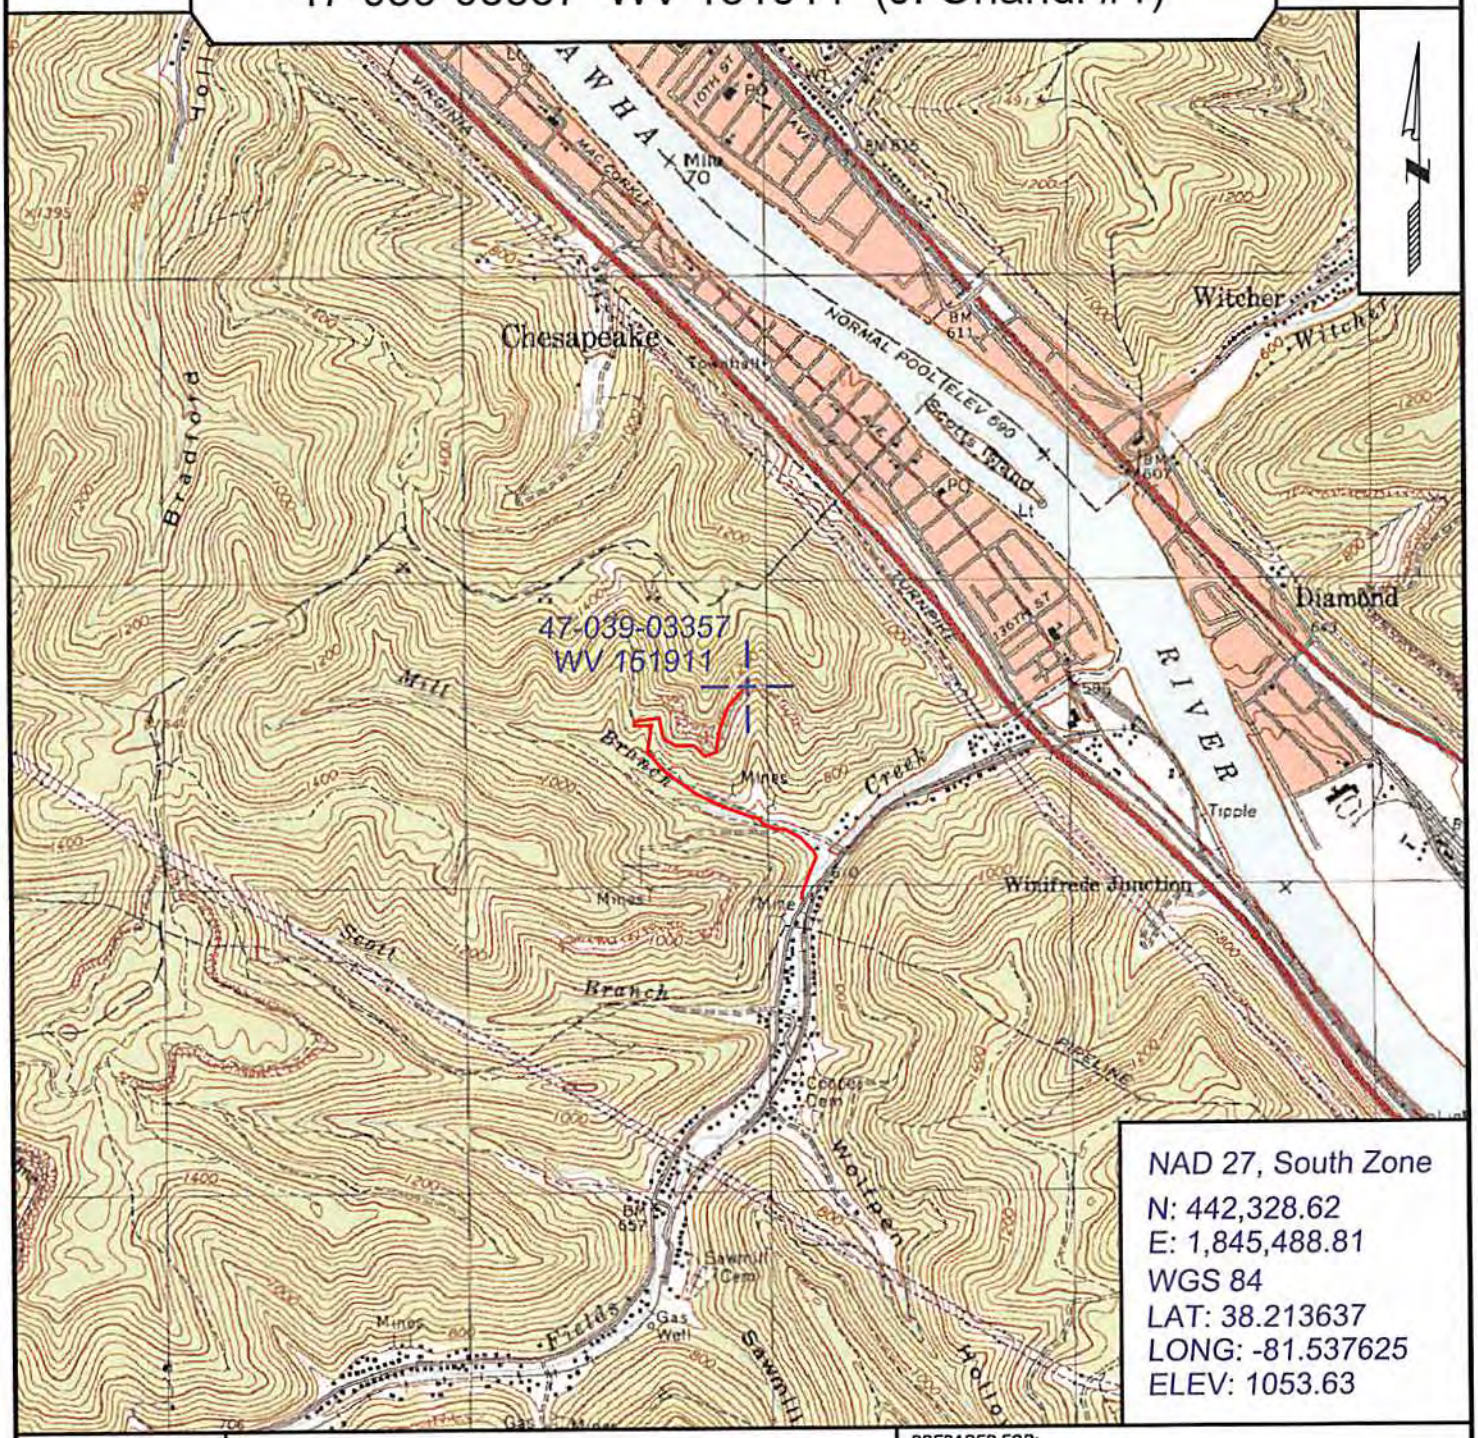

NAD 27, South Zone
N: 442,328.62
E: 1,845,488.81
WGS 84
LAT: 38.213637
LONG: -81.537625
ELEV: 1053.63

SURVEYING AND MAPPING SERVICES PERFORMED BY:

ALLEGHENY SURVEYS, INC.

1-800-482-8606
237 Birch River Road
Birch River, WV 26610
PH: (304) 649-8606
FAX: (304) 649-8608

PREPARED FOR:

EQT Production Company

P.O. Box 280
Bridgeport, WV 26330