



4703903730

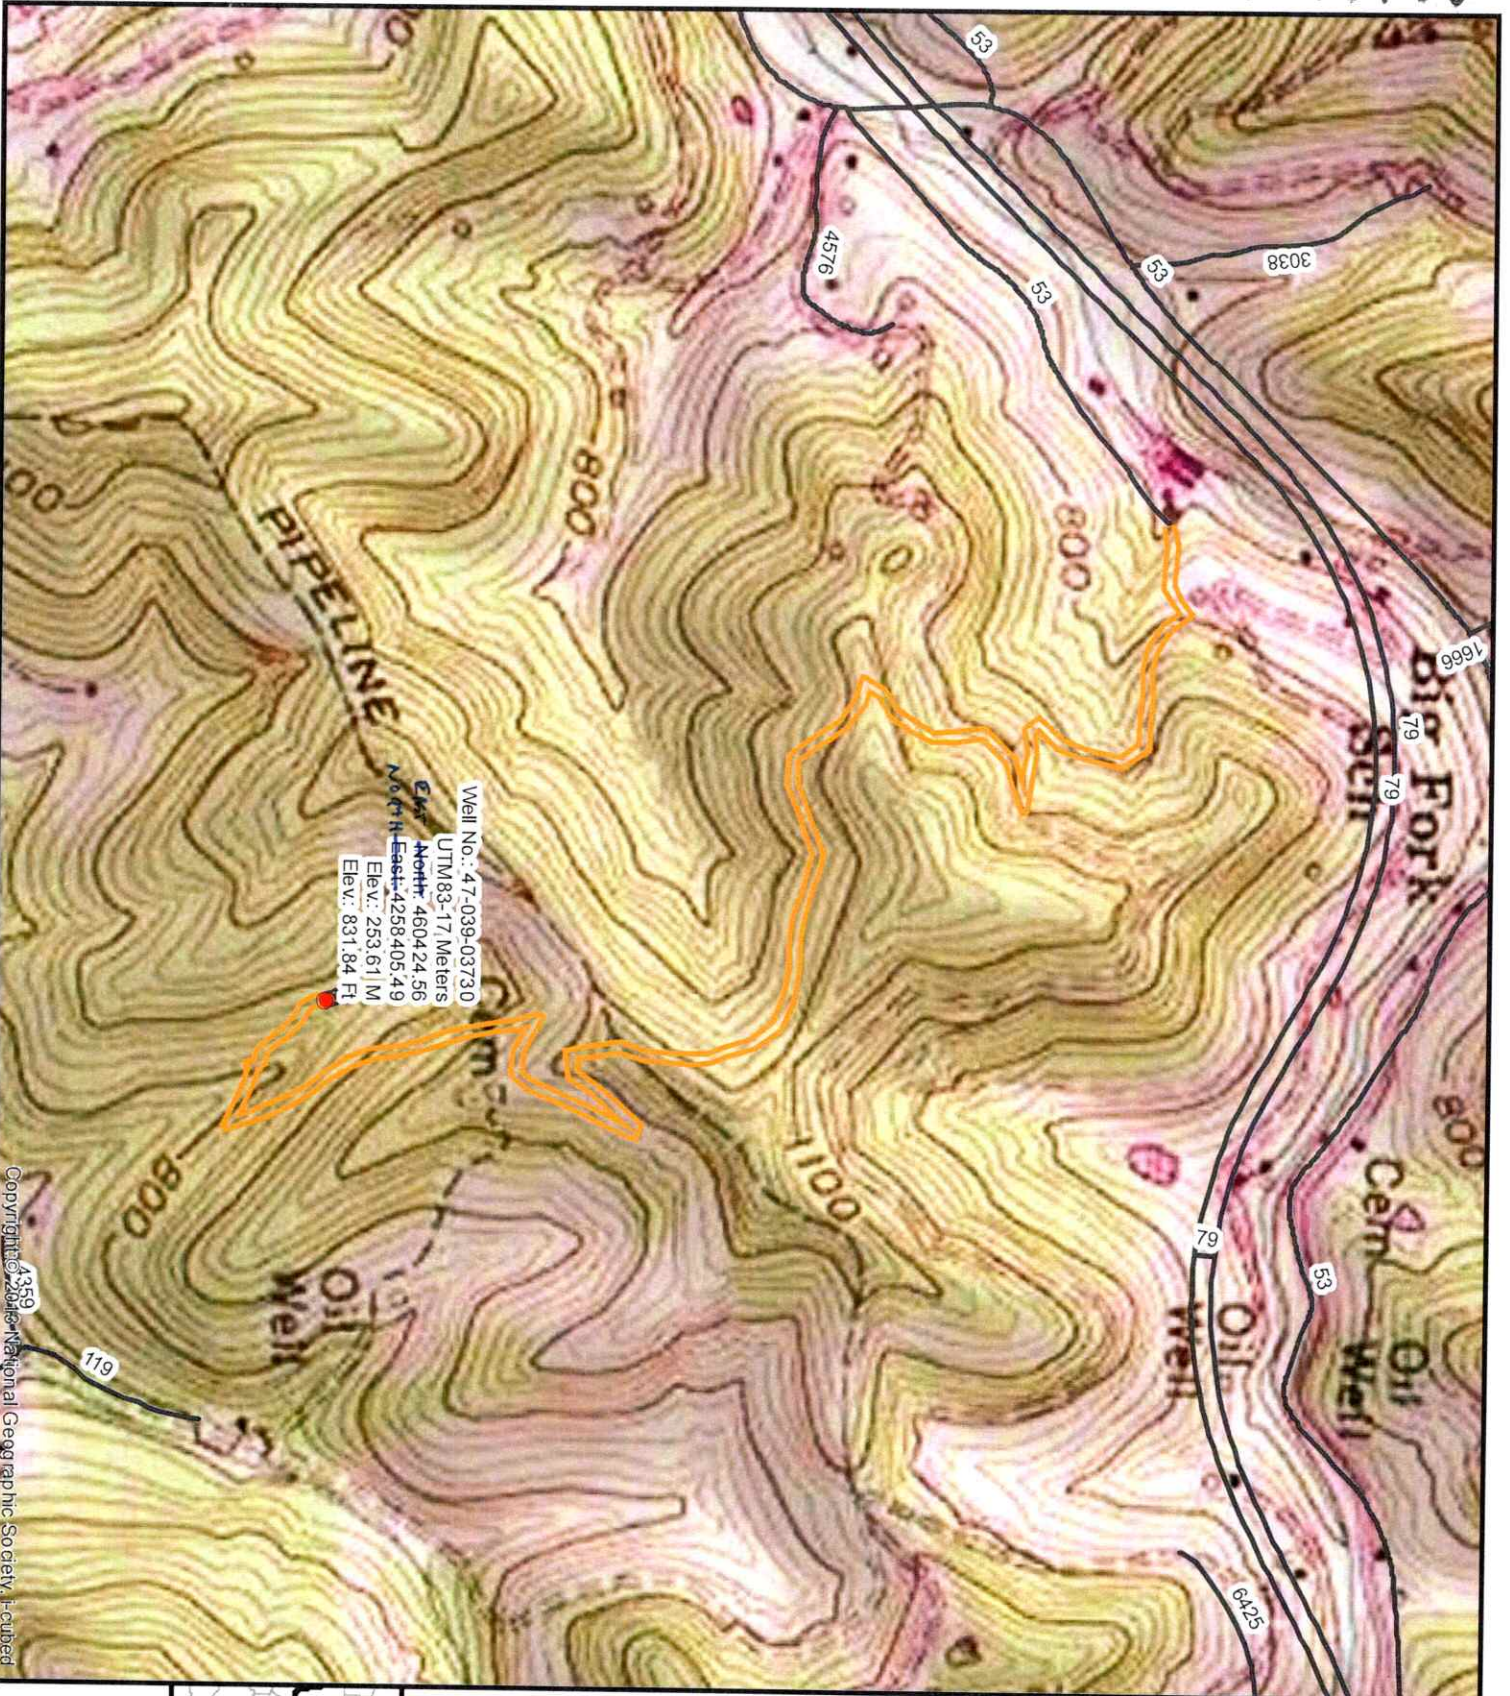

Copyright © 2015 National Geographic Society. Incubed

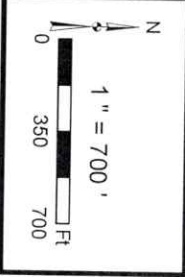

RECEIVED  
 Office of Oil and Gas  
 MAY 18 2023  
 WV Department of  
 Environmental Protection

**Legend**

- Well
- ▬ Access Road
- ▨ Pits
- Pad
- Public Roads

47-039-03730  
 Plugging Map

Diversified Gas & Oil  
 Corporation  
 100 Diversified Way  
 Pikeville KY, 41051

**06/30/2023**

WW-7  
8-30-06



West Virginia Department of Environmental Protection  
Office of Oil and Gas  
**WELL LOCATION FORM: GPS**

API: 47-039-03730 WELL NO.: Simon D. Sa

FARM NAME: SD Sampson

RESPONSIBLE PARTY NAME: Diversified Energy

COUNTY: Kanawha DISTRICT: Elk

QUADRANGLE: Blue Creek 7.5'

SURFACE OWNER: Stricklen Realty Inc.

ROYALTY OWNER: Jerry Null

UTM GPS ~~NORTHING~~: 460424.26 EAST

UTM GPS ~~EASTING~~: 4258405.49 NORTH GPS ELEVATION: 829.4'

The Responsible Party named above has chosen to submit GPS coordinates in lieu of preparing a new well location plat for a plugging permit or assigned API number on the above well. The Office of Oil and Gas will not accept GPS coordinates that do not meet the following requirements:

1. Datum: NAD 1983, Zone: 17 North, Coordinate Units: meters, Altitude: height above mean sea level (MSL) – meters.
2. Accuracy to Datum – 3.05 meters
3. Data Collection Method:

Survey grade GPS \_\_\_\_\_: Post Processed Differential \_\_\_\_\_  
Real-Time Differential \_\_\_\_\_

Mapping Grade GPS X: Post Processed Differential X  
Real-Time Differential \_\_\_\_\_

4. **Letter size copy of the topography map showing the well location.**

I the undersigned, hereby certify this data is correct to the best of my knowledge and belief and shows all the information required by law and the regulations issued and prescribed by the Office of Oil and Gas.

Chris Veazey  
Signature

Chris Veazey - Permitting Supervisor  
Title

5/11/23  
Date

RECEIVED  
Office of Oil and Gas  
MAY 18 2023  
WV Department of  
Environmental Protection