


Well Location Map for
47-039-04018
Central Appalachian
Coal #11


Northing: 4223107.326
Easting: 468902.999
Elevation: 1,366 ft
UTM NAD83 Zone 17N Meters

Greylock Conventional, LLC
500 Corporate Landing
Charleston, WV 25311

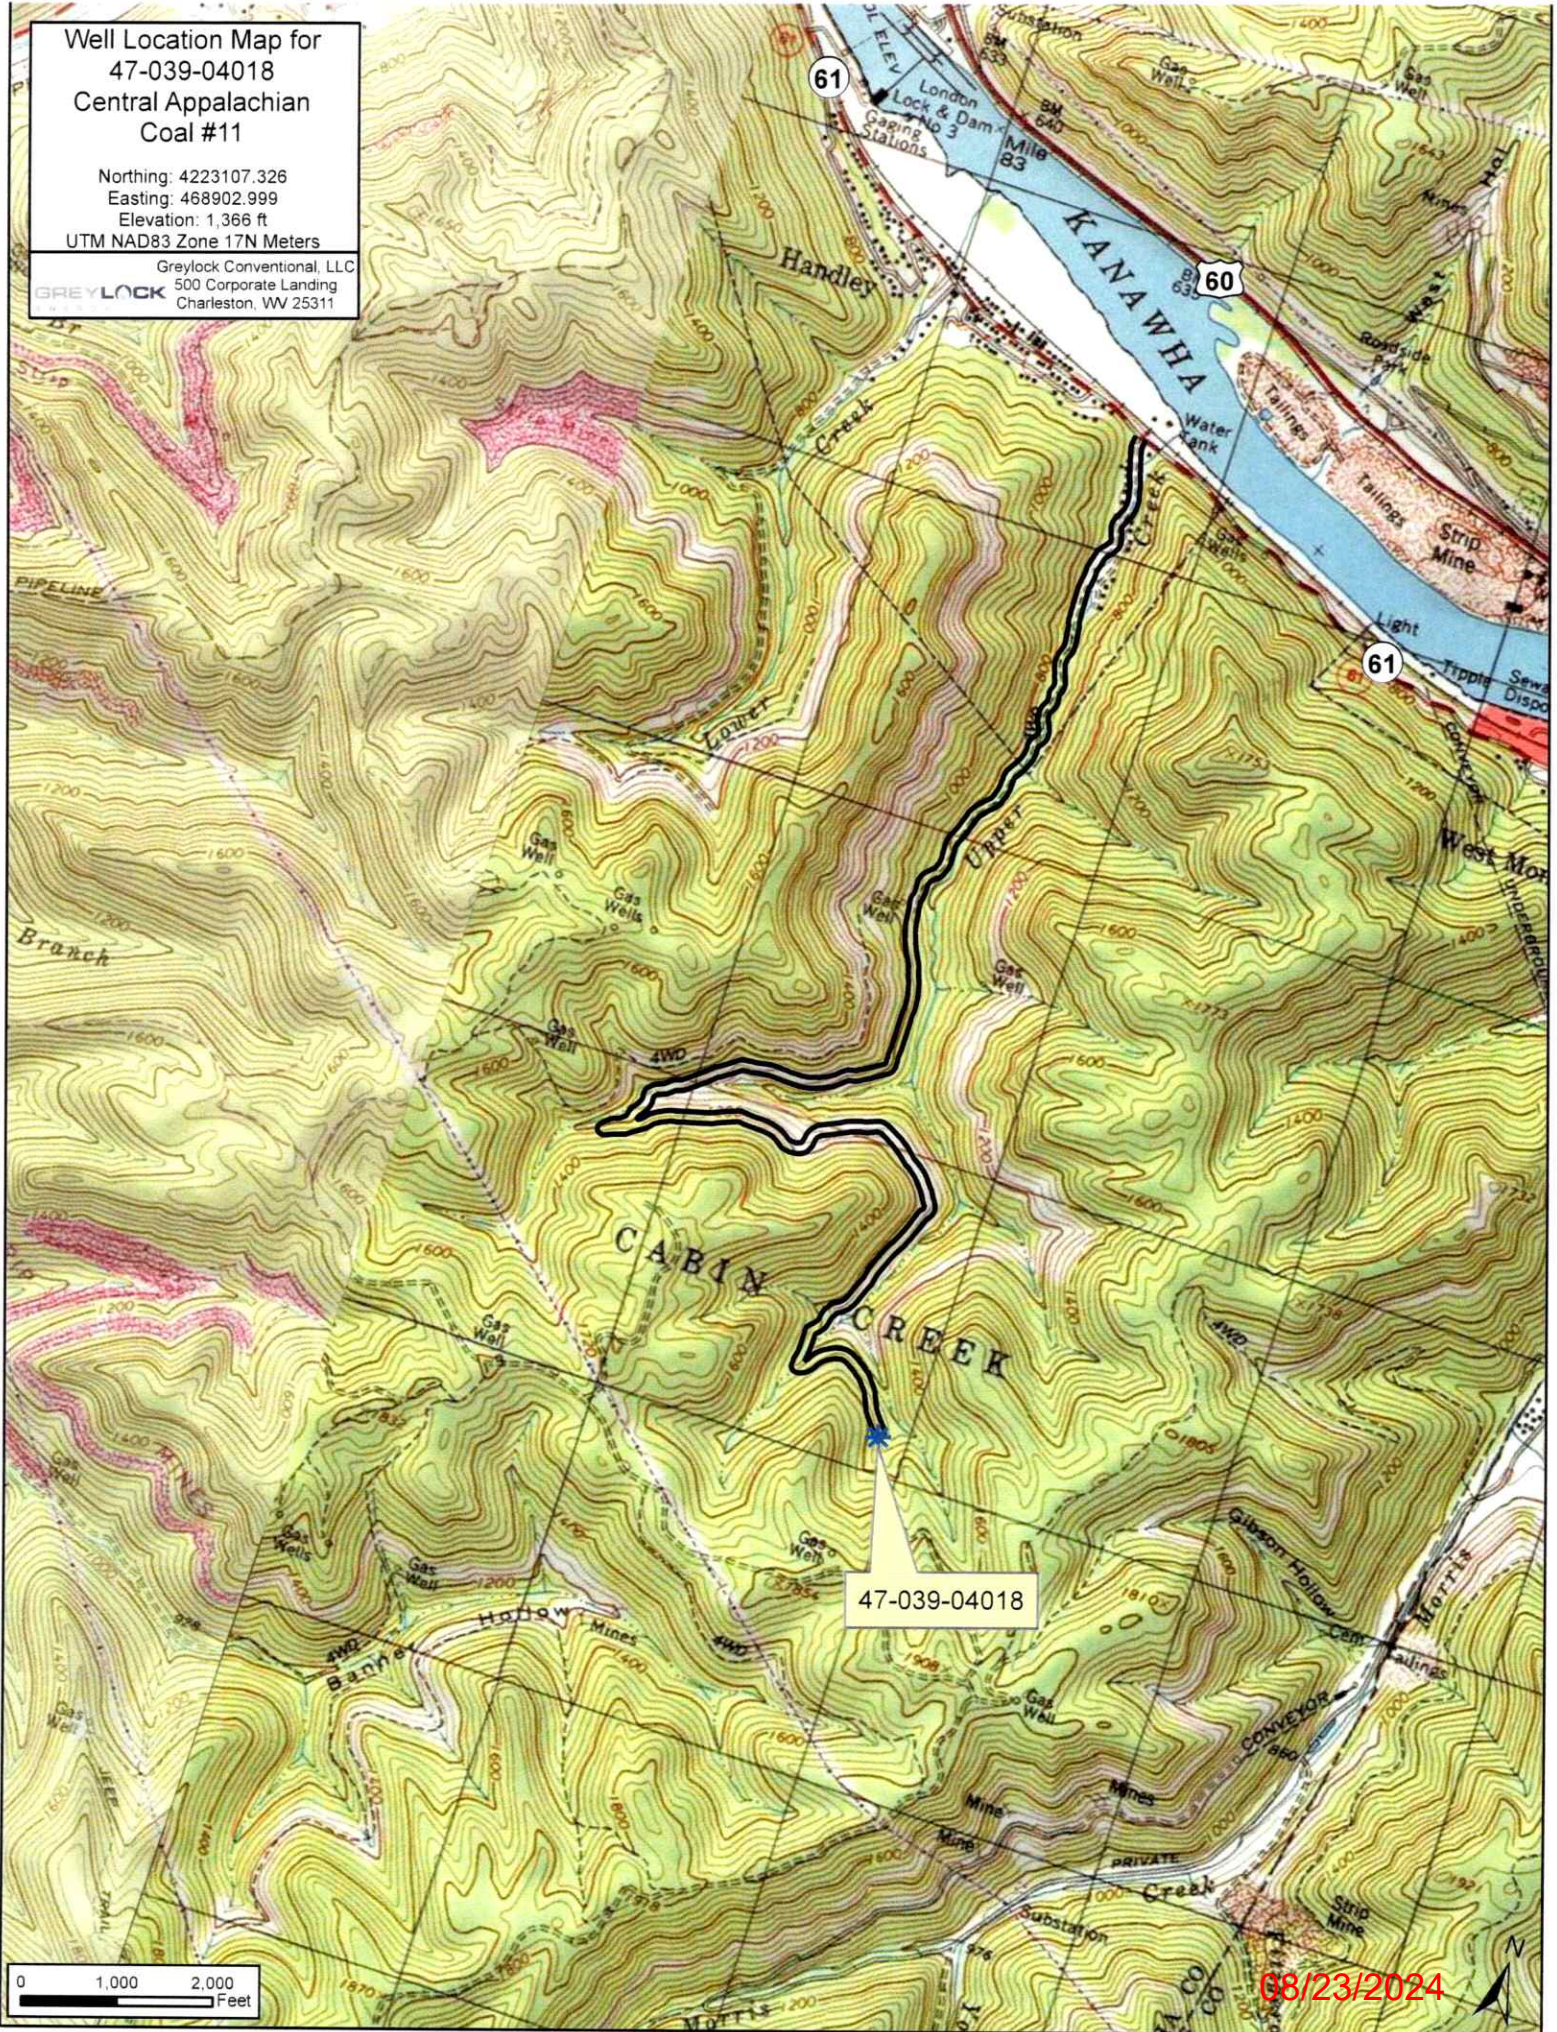

08/23/2024

Central Appalachian Coal #11

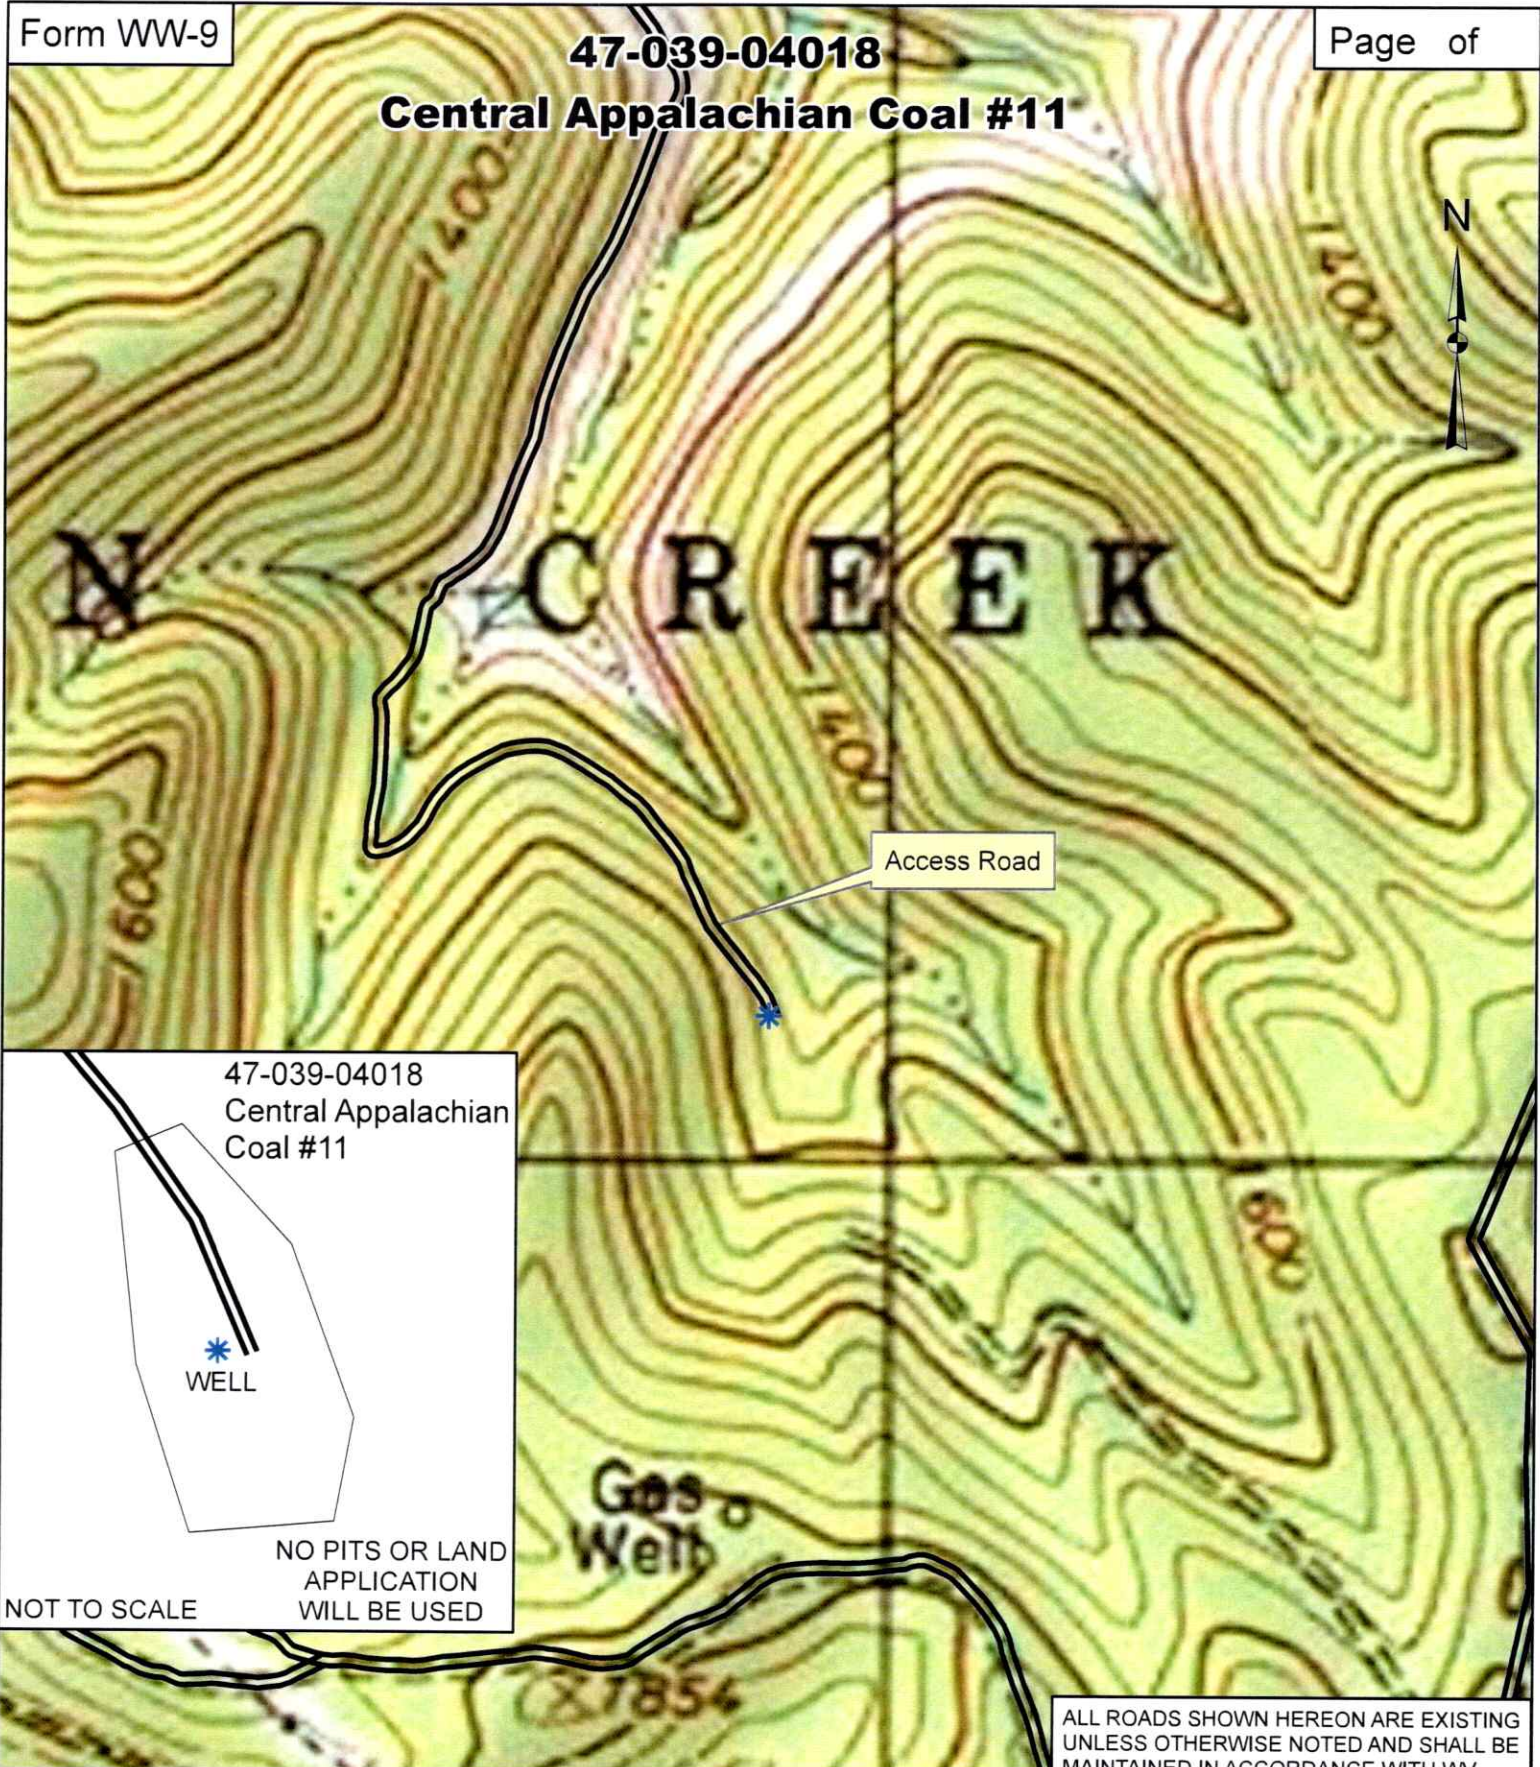


47-039-04018
Central Appalachian
Coal #11

WELL

NO PITS OR LAND
APPLICATION
WILL BE USED

NOT TO SCALE

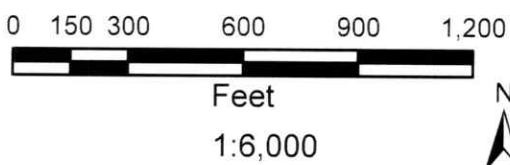

ALL ROADS SHOWN HEREON ARE EXISTING UNLESS OTHERWISE NOTED AND SHALL BE MAINTAINED IN ACCORDANCE WITH WV D.E.P. OIL AND GAS BMP MANUAL ENTRANCES AT COUNTY/STATE ROADS SHALL BE MAINTAINED WITH WV D.O.T. REGULATION. SEPARATE PERMITS MAY BE REQUIRED BY D.O.T.

EARTHWORK CONTRACTORS ARE RESPONSIBLE FOR NOTIFICATION TO THE OPERATOR AND IN COMPLIANCE WITH ANY DEVIATION FROM THIS PLAN.

GREYLOCK
ENERGY

Greylock Conventional, LLC
500 Corporate Landing Charleston, WV 25311
304-925-6100 - www.greylockenergy.com

Date: 6/26/2024

TOPO SECTION OF USGS
MONTGOMERY 7.5' QUADRANGLE

08/23/2024

WW-7
8-30-06



West Virginia Department of Environmental Protection
Office of Oil and Gas
WELL LOCATION FORM: GPS

API: 47-039-04018 WELL NO.: 11

FARM NAME: EASTERN ASSOC. COAL CO.

RESPONSIBLE PARTY NAME: Greylock Conventional, LLC

COUNTY: Kanawha DISTRICT: Cabin Creek

QUADRANGLE: Montgomery

SURFACE OWNER: _____

ROYALTY OWNER: _____

UTM GPS NORTHING: 4223107.33

UTM GPS EASTING: 468902.99 GPS ELEVATION: 1,366 ft

The Responsible Party named above has chosen to submit GPS coordinates in lieu of preparing a new well location plat for a plugging permit or assigned API number on the above well. The Office of Oil and Gas will not accept GPS coordinates that do not meet the following requirements:

1. Datum: NAD 1983, Zone: 17 North, Coordinate Units: meters, Altitude: height above mean sea level (MSL) – meters.
2. Accuracy to Datum – 3.05 meters
3. Data Collection Method:

Survey grade GPS _____: Post Processed Differential _____

Real-Time Differential _____

Mapping Grade GPS X: Post Processed Differential _____

Real-Time Differential X

4. **Letter size copy of the topography map showing the well location.**

I the undersigned, hereby certify this data is correct to the best of my knowledge and belief and shows all the information required by law and the regulations issued and prescribed by the Office of Oil and Gas.

GSM
Signature

Asset Development Manager
Title

5/28/24
Date

RECEIVED
Office of Oil and Gas

JUL 31 2024

WV Department of
Environmental Protection

08/23/2024