

47-039-04745P
04/19/2019

WW-7
8-30-06



West Virginia Department of Environmental Protection
Office of Oil & Gas
WELL LOCATION FORM: GPS

API: 47- 039 - 04745 WELL NO: 32

FARM NAME: Black Band Fuel No.32

RESPONSIBLE PARTY NAME: H.G. Energy, LLC

COUNTY: Kanawha DISTRICT: Washington

QUADRANGLE: Racine 7.5'

SURFACE OWNER: Dickinson Fuel Co.

ROYALTY OWNER: HG Energy, LLC

UTM GPS NORTHING: 4,233,190 (NAD 83)

UTM GPS EASTING: 438,933 (NAD 83) GPS ELEVATION: 372 m. (1220')

The Responsible Party named above has chosen to submit GPS coordinates in lieu of preparing a new well location plat for a plugging permit or assigned API number on the above well. The Office of Oil & Gas will not accept GPS coordinates that do not meet the following requirements:

- Datum: NAD 1983, Zone:17 North, Coordinate Units: meters, Altitude: height above mean sea level (MSL) - meters.
- Accuracy to Datum - 3.05 meters
- Data Collection Method:

Survey Grade GPS	<input type="checkbox"/>	Post Processed Differential	<input type="checkbox"/>
		Real-Time Differential	<input type="checkbox"/>
Mapping Grade GPS	<input checked="" type="checkbox"/>	Post Processed Differential	<input checked="" type="checkbox"/>
		Real-Time Differential	<input type="checkbox"/>
- Letter size copy of the topography map showing the well location.**

RECEIVED
Office of Oil and Gas
APR 9 2019
WV Department of
Environmental Protection

I the undersigned, hereby certify this data is correct to the best of my knowledge and belief and shows all the information required by law and the regulations issued and prescribed by the Office of Oil and Gas.


Diane White
Diane C. White

Designated Agent
Title

11/20/2018
Date

04/19/2019

SUBJECT WELL
Black Band Fuel No. 32
47-039-2395

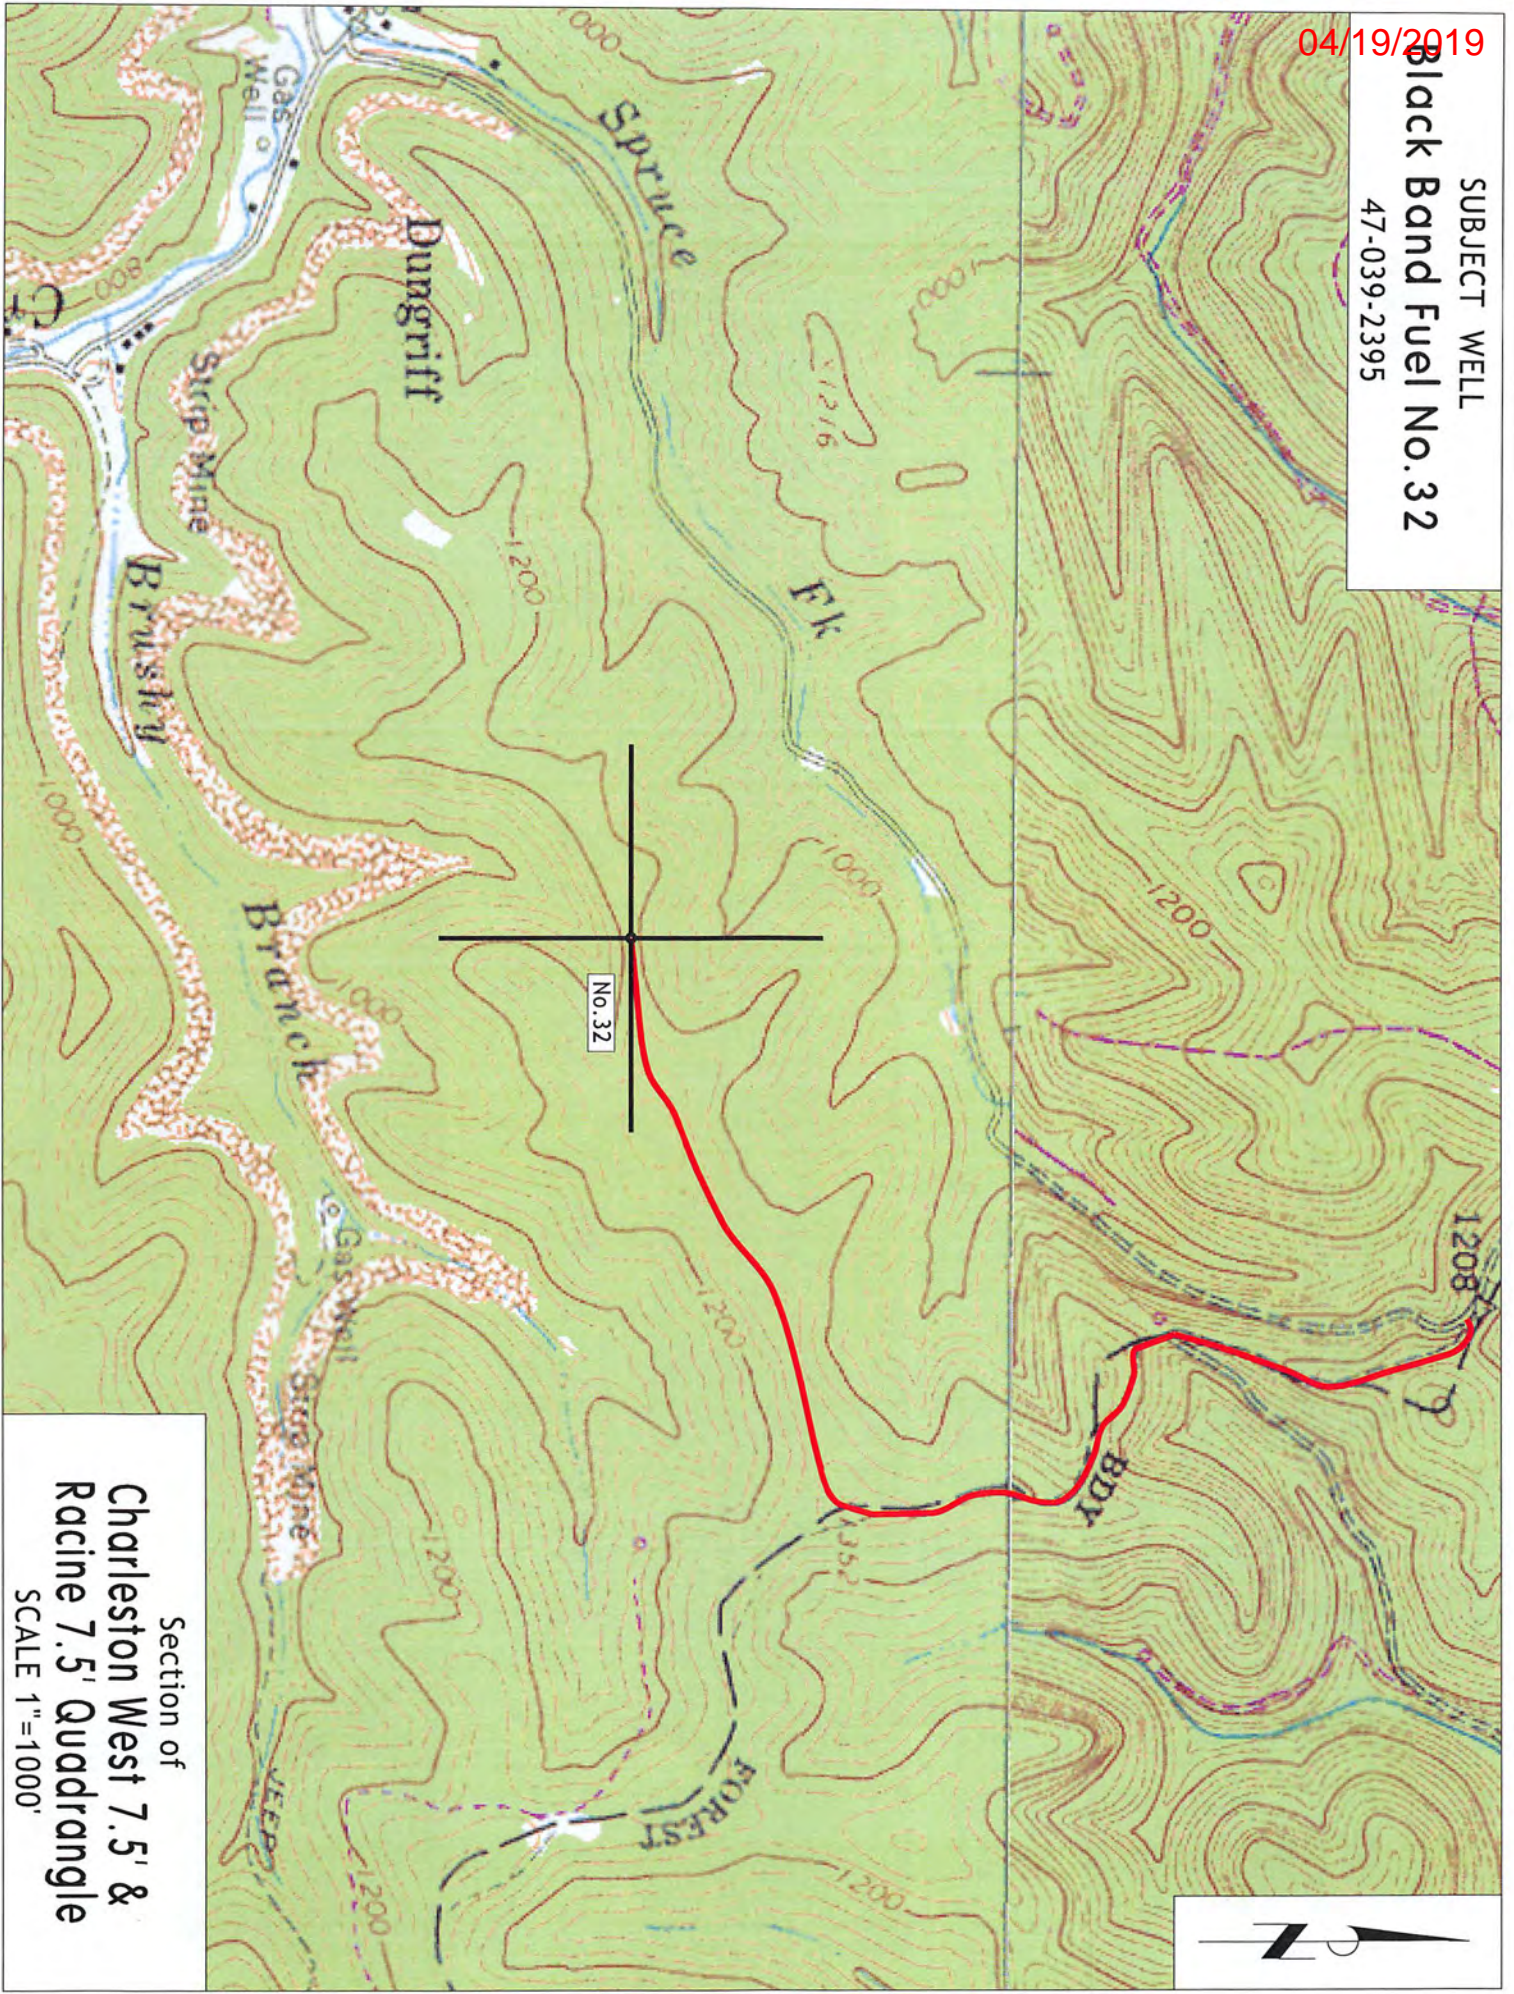

Section of
 Charleston West 7.5' &
 Racine 7.5' Quadrangle
 SCALE 1"=1000'