FORM WW 6

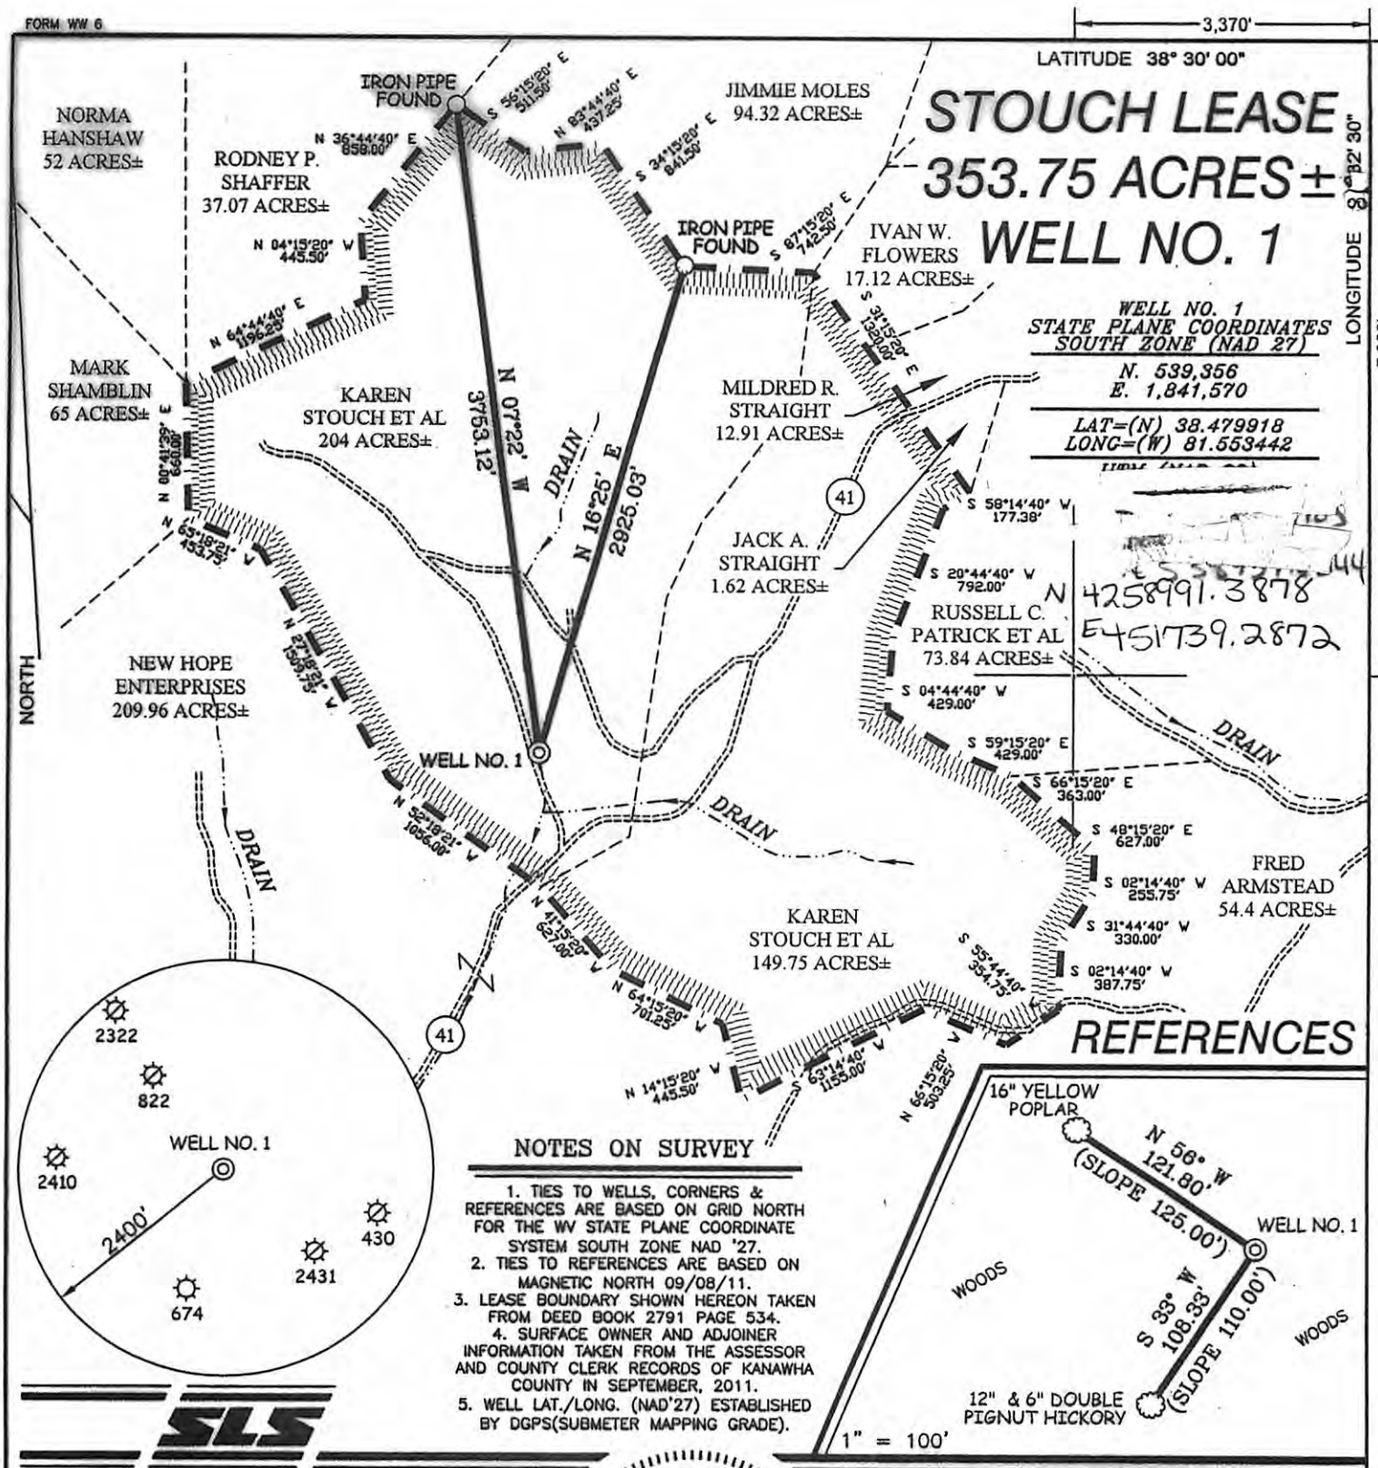

NOTES ON SURVEY

1. TIES TO WELLS, CORNERS & REFERENCES ARE BASED ON GRID NORTH FOR THE WV STATE PLANE COORDINATE SYSTEM SOUTH ZONE NAD '27.
2. TIES TO REFERENCES ARE BASED ON MAGNETIC NORTH 09/08/11.
3. LEASE BOUNDARY SHOWN HEREON TAKEN FROM DEED BOOK 2791 PAGE 534.
4. SURFACE OWNER AND ADJOINER INFORMATION TAKEN FROM THE ASSESSOR AND COUNTY CLERK RECORDS OF KANAWHA COUNTY IN SEPTEMBER, 2011.
5. WELL LAT./LONG. (NAD'27) ESTABLISHED BY DGPS(SUBMETER MAPPING GRADE).

SLS

I THE UNDERSIGNED, HEREBY CERTIFY THAT THIS PLAT IS CORRECT TO THE BEST OF MY KNOWLEDGE AND BELIEF AND SHOWS ALL THE INFORMATION REQUIRED BY LAW AND THE REGULATIONS ISSUED AND PRESCRIBED BY THE DIVISION OF ENVIRONMENTAL PROTECTION.

P.S. 677 Gregory A. Smith

GREGORY A. SMITH LICENSED No. 677 STATE OF WEST VIRGINIA PROFESSIONAL SURVEYOR

(+) DENOTES LOCATION OF WELL ON UNITED STATES TOPOGRAPHIC MAPS.

DATE SEPTEMBER 12 , 20 11

OPERATORS WELL NO. STOUCH NO. 1

API WELL NO. 47 — 039 — 06313
STATE COUNTY PERMIT

CANCELLED

MINIMUM DEGREE OF ACCURACY 1 / 2500

PROVEN SOURCE OF ELEVATION DGPS (SUBMETER MINING GRADE)

FILE NO. 7693P1 (370-55)

SCALE 1" = 1000'

STATE OF WEST VIRGINIA
DIVISION OF ENVIRONMENTAL PROTECTION
OFFICE OF OIL AND GAS

WELL TYPE : OIL ___ GAS X LIQUID INJECTION ___ WASTE DISPOSAL ___ IF "GAS" PRODUCTION X STORAGE ___ DEEP ___ SHALLOW X

LOCATION :

ELEVATION 790' WATERSHED COOPERS CREEK

DISTRICT ELK COUNTY KANAWHA QUADRANGLE BIG CHIMNEY 7.5'

SURFACE OWNER KAREN STOUCH AND GERALDINE KESSEL ET AL ACREAGE 204±

ROYALTY OWNER KAREN STOUCH AND GERALDINE KESSEL ET AL LEASE ACREAGE 204 OF 353.75±

PROPOSED WORK : LEASE NO. ___

DRILL X CONVERT ___ DRILL DEEPER ___ REDRILL ___ FRACTURE OR STIMULATE X PLUG OFF OLD FORMATION ___ PERFORATE NEW FORMATION ___ PLUG AND ABANDON ___ CLEAN OUT AND REPLUG ___ OTHER ___

PHYSICAL CHANGE IN WELL (SPECIFY) ___ TARGET FORMATION LOWER HURON

ESTIMATED DEPTH 5,330'

COUNTY NAME

PERMIT

WELL OPERATOR SHULTZ RUN GAS COMPANY

ADDRESS 300 CAPITOL STREET, SUITE 1500 CHARLESTON, WV 25301

DESIGNATED AGENT PETE PAULEY

ADDRESS 300 CAPITOL STREET, SUITE 1500 CHARLESTON, WV 25301

11/08/2013