



T C Energy
Coco B 12643, Kanawha, AS Drilled

Job No. 11424
Survey Date: Monday, July 8, 2024

True North Directional Services
Survey Report

Tuesday, July 9, 2024

Surface Coordinates: 514,763.54 N, 1,864,711.46 E (38° 24' 45.8519" N, 81° 28' 19.7940" W)
Grid Coordinate System: NAD27 West Virginia State Planes, Southern Zone, US Foot

Surface Coordinates relative to Coco B 12643: 0.00 N, 0.00 E (Grid)

Kelly Bushing Elevation: 866.00ft above Mean Sea Level
Kelly Bushing Elevation: 866.00ft above Mean Sea Level
Kelly Bushing Elevation: 19.00ft above Ground Level
Ground Level: 847.00ft above Mean Sea Level

Survey Ref: svy1268

RECEIVED
Office Of Oil and Gas

SEP 17 2024

WV Department of
Environmental Protection

KellyDown - Version: 4.01.04.02



11/15/2024



T C Energy
Coco B 12643



Survey Report for Kanawha, 12643, AS Drilled

Measured Depth (ft)	Inclination (°)	Azimuth (°)	Vertical Depth (ft)	Northings (ft)	Eastings (ft)	Vertical Section (ft)	Dogleg Rate (°/100ft)
5,696.00	62.72	63.68	5,075.88	1,191.53 N	10.09 W	561.52	
5,700.00	63.06	63.62	5,077.70	1,193.11 N	6.90 W	565.07	8.659
5,750.00	67.33	62.84	5,098.67	1,213.56 N	33.61 E	610.43	8.659
5,800.00	71.10	63.10	5,116.32	1,234.98 N	75.19 E	657.19	7.548
5,850.00	72.59	64.08	5,131.62	1,256.13 N	117.83 E	704.75	3.514
5,900.00	73.29	64.64	5,146.31	1,276.78 N	160.93 E	752.48	1.758
5,950.00	74.83	65.56	5,160.09	1,297.04 N	204.52 E	800.44	3.558
6,000.00	76.96	66.51	5,172.27	1,316.74 N	248.82 E	848.77	4.633
6,041.00	78.60	67.60	5,180.95	1,332.37 N	285.72 E	888.65	4.774
6,050.00	78.94	67.52	5,182.70	1,335.73 N	293.88 E	897.43	3.892
6,100.00	80.83	67.06	5,191.48	1,354.74 N	339.28 E	946.39	3.892
6,150.00	81.96	66.81	5,198.91	1,374.12 N	384.77 E	995.60	2.306
6,200.00	83.53	68.59	5,205.24	1,392.99 N	430.64 E	1,044.90	4.727
6,250.00	85.02	70.79	5,210.16	1,410.21 N	477.31 E	1,094.13	5.294
6,300.00	85.73	72.00	5,214.20	1,426.00 N	524.58 E	1,143.19	2.806
6,350.00	86.64	72.42	5,217.56	1,441.27 N	572.07 E	1,192.19	2.008
6,400.00	87.87	73.31	5,219.98	1,456.05 N	619.77 E	1,241.15	3.021
6,450.00	90.10	74.28	5,221.02	1,469.95 N	667.79 E	1,289.96	4.875
6,500.00	90.74	74.18	5,220.38	1,483.44 N	715.93 E	1,338.68	1.286
6,550.00	90.23	73.63	5,219.93	1,497.29 N	763.97 E	1,387.49	1.489
6,553.00	90.20	73.60	5,219.92	1,498.14 N	766.85 E	1,390.42	1.607
6,600.00	90.23	77.42	5,219.76	1,509.84 N	812.36 E	1,435.98	8.134
6,650.00	91.02	77.90	5,219.21	1,520.49 N	861.21 E	1,483.97	1.850
6,700.00	91.69	77.72	5,217.99	1,530.99 N	910.08 E	1,531.90	1.375
6,750.00	91.48	76.96	5,216.46	1,541.92 N	958.84 E	1,579.95	1.578
6,800.00	90.15	76.18	5,215.70	1,553.55 N	1,007.46 E	1,628.21	3.076
6,850.00	89.50	75.32	5,216.01	1,565.82 N	1,055.93 E	1,676.64	2.160
6,900.00	89.65	73.76	5,216.40	1,579.07 N	1,104.14 E	1,725.31	3.128
6,950.00	90.14	73.22	5,216.52	1,593.39 N	1,152.05 E	1,774.22	1.460
7,000.00	91.20	71.90	5,215.95	1,608.32 N	1,199.76 E	1,823.26	3.384
7,050.00	90.57	71.13	5,215.20	1,624.18 N	1,247.17 E	1,872.48	1.980
7,100.00	90.63	70.70	5,214.77	1,640.57 N	1,294.41 E	1,921.79	0.873
7,150.00	90.58	70.74	5,213.93	1,657.09 N	1,341.59 E	1,971.13	0.114
7,200.00	89.15	70.95	5,214.22	1,673.52 N	1,388.81 E	2,020.45	2.896
7,250.00	88.71	71.60	5,215.18	1,689.62 N	1,436.14 E	2,069.71	1.562
7,300.00	88.82	72.58	5,216.32	1,705.01 N	1,483.70 E	2,118.83	1.967
7,350.00	88.90	73.06	5,217.28	1,719.73 N	1,531.47 E	2,167.83	0.981
7,400.00	86.94	72.90	5,218.99	1,734.33 N	1,579.26 E	2,216.77	3.923
7,445.00	87.60	72.70	5,221.16	1,747.62 N	1,622.20 E	2,260.83	1.526
7,450.00	87.69	72.82	5,221.36	1,749.10 N	1,626.97 E	2,265.73	3.021
7,500.00	88.56	73.78	5,222.99	1,763.37 N	1,674.86 E	2,314.61	2.583
7,550.00	89.95	73.84	5,223.82	1,777.36 N	1,722.85 E	2,363.44	2.792
7,600.00	91.59	73.77	5,222.89	1,791.17 N	1,770.90 E	2,412.24	3.283
7,650.00	91.08	74.24	5,221.66	1,805.17 N	1,818.88 E	2,461.07	1.388
7,668.00	92.10	74.40	5,221.16	1,810.03 N	1,836.20 E	2,478.60	5.719
7,700.00	92.53	73.69	5,219.86	1,818.82 N	1,866.95 E	2,509.80	2.590
7,750.00	90.85	73.65	5,218.12	1,832.99 N	1,914.86 E	2,558.65	3.354
7,800.00	88.21	73.89	5,218.53	1,846.95 N	1,962.87 E	2,607.48	5.308
7,850.00	88.37	74.07	5,220.05	1,860.73 N	2,010.91 E	2,656.26	0.494
7,900.00	88.18	73.84	5,221.60	1,874.57 N	2,058.93 E	2,705.05	0.606

Office Of Oil and Gas
REG-024
Department of Environmental Protection



Survey Report for Kanawha, 12643, AS Drilled

Measured Depth (ft)	Inclination (°)	Azimuth (°)	Vertical Depth (ft)	Northings (ft)	Eastings (ft)	Vertical Section (ft)	Dogleg Rate (°/100ft)
7,950.00	89.01	74.13	5,222.95	1,888.38 N	2,106.96 E	2,753.83	1.755
8,000.00	89.92	74.09	5,223.18	1,901.95 N	2,155.09 E	2,802.58	1.828
8,050.00	89.25	73.53	5,223.49	1,915.93 N	2,203.09 E	2,851.42	1.756
8,100.00	89.04	72.71	5,224.36	1,930.37 N	2,250.95 E	2,900.35	1.689
8,150.00	89.84	71.42	5,224.92	1,945.75 N	2,298.52 E	2,949.48	3.039
8,200.00	89.72	71.20	5,225.03	1,961.85 N	2,345.86 E	2,998.75	0.495
8,250.00	89.31	70.12	5,225.46	1,978.40 N	2,393.04 E	3,048.09	2.314
8,300.00	89.78	70.78	5,225.95	1,995.21 N	2,440.12 E	3,097.48	1.637
8,350.00	91.16	72.16	5,225.41	2,010.97 N	2,487.57 E	3,146.68	3.888
8,381.00	91.30	72.30	5,224.74	2,020.43 N	2,517.08 E	3,177.12	0.643
8,400.00	91.00	72.09	5,224.36	2,026.24 N	2,535.17 E	3,195.78	1.912
8,450.00	90.87	71.59	5,223.69	2,041.83 N	2,582.67 E	3,244.95	1.041
8,500.00	92.39	71.72	5,222.45	2,057.67 N	2,630.08 E	3,294.15	3.056
8,550.00	94.49	72.67	5,219.43	2,072.98 N	2,677.58 E	3,343.18	4.612
8,584.00	95.60	74.30	5,216.41	2,082.62 N	2,710.04 E	3,376.30	5.777

Bit Projection

8,608.00	96.37	76.43	5,213.91	2,088.65 N	2,733.13 E	3,399.46	9.406
8,634.00	96.37	76.43	5,211.02	2,094.71 N	2,758.25 E	3,424.42	0.000

All data is in Feet (US Survey) unless otherwise stated. Directions and coordinates are relative to Grid North. Vertical depths are relative to 12643. Northings and Eastings are relative to Coco B 12643.

The dogleg severity is in Degrees per 100 feet (US Survey). Vertical Section is from Coco B 12643 calculated along an azimuth of 61.40° (Grid).

Based upon minimum curvature calculations, at a measured depth of 8,634.00ft, the bottom hole displacement is 3,463.49ft, in the direction of 52.79° (Grid).

Disclaimer Notice

True North Directional Services makes no warranty of any kind with respect to the subject matter included herein or the completeness or accuracy of this document.

True North Directional Services are not responsible for any actions (or lack thereof) taken as a result of relying on or in any way using information contained in this document and in no event shall be liable for any damages resulting from reliance on or use of this information.


RECEIVED
Office Of Oil and Gas
SEP 17 2024
WV Department of



T C Energy
Coco B 12643

Horizontal Section  TC Energy

Kanawha, 12643

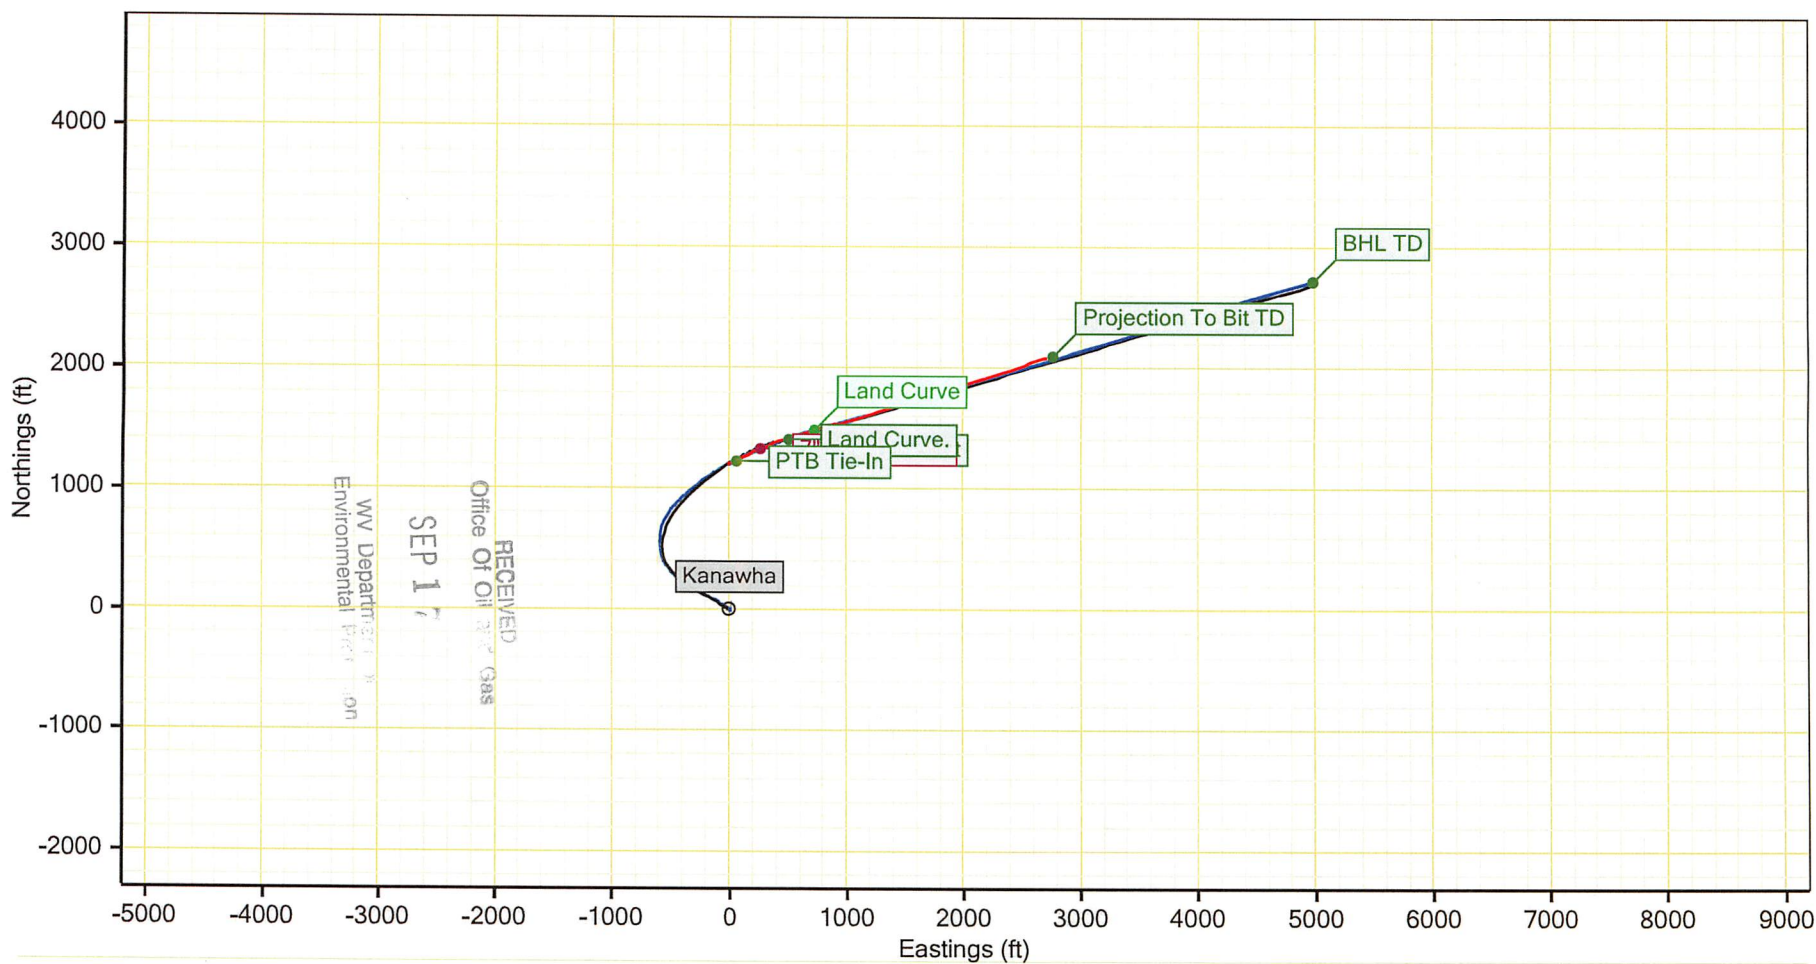



T C Energy
Coco B 12643

Vertical Section



Kanawha, 12643

