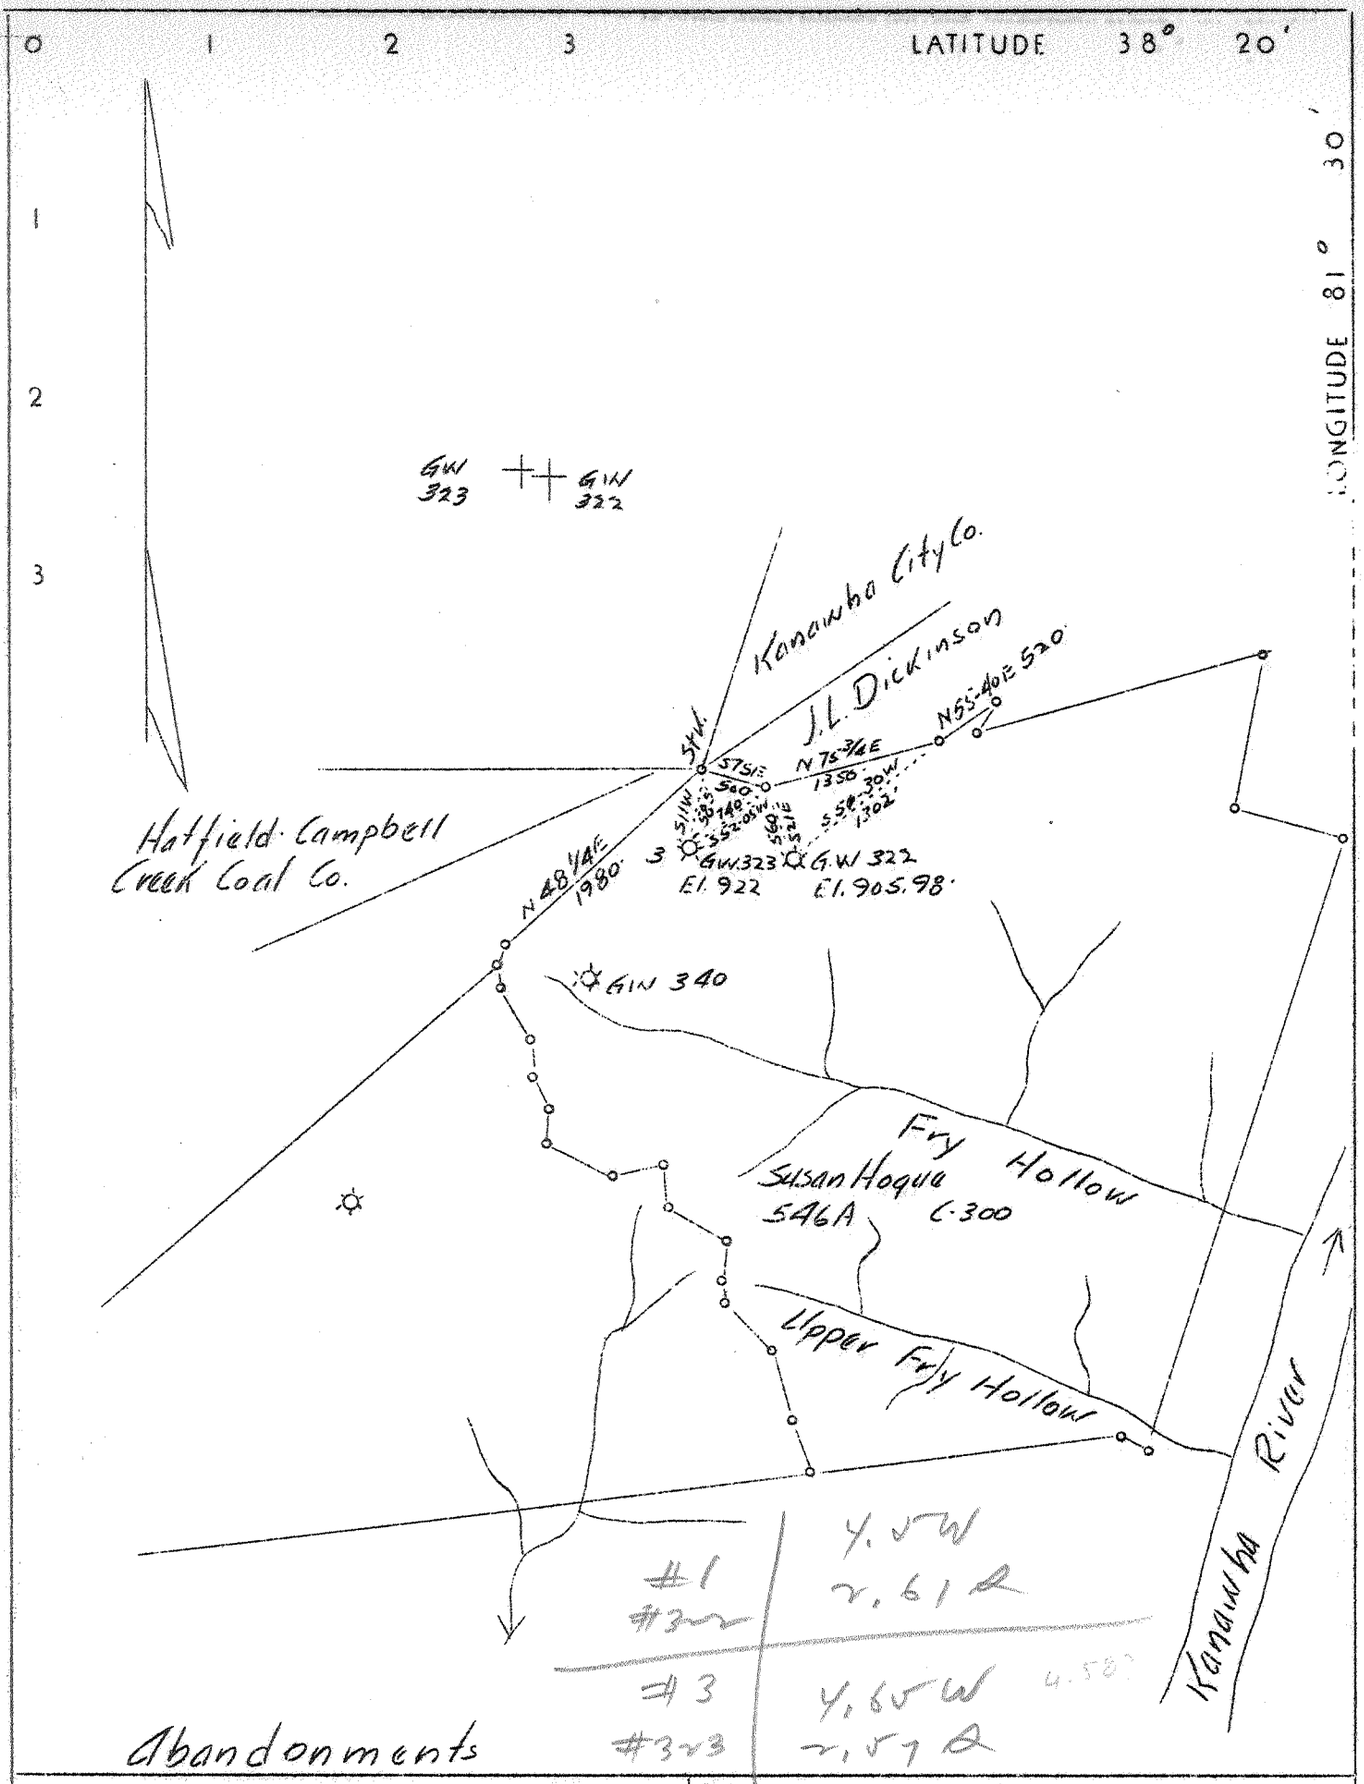

Company Columbian Carbon Co

Address P.O.Box 1240, Charleston, W.Va.

Farm Susan Hogue

Tract Acres 546 Lease No. C-300

Well (Farm) No. 1 & 3 Serial No. GW-322 GW-323

Elevation (Spirit Level) As shown on plat

Quadrangle Charleston - SE (SE)

County Kanawha District Louden

Engineer James N. Sell

Engineer's Registration No. 772

File No. Drawing No.

Date April 29, 1937 Scale: 1" 1320'

STATE OF WEST VIRGINIA
Department of Mines
OIL AND GAS DIVISION
Charleston

WELL LOCATION MAP

File No. KAN-207 & 208 A

+Denotes location of well on U.S. Topographic Maps, scale 1 to 62,500, latitude and longitude lines being represented by border lines as shown.

—Denotes one inch spaces on border line of original tracing.