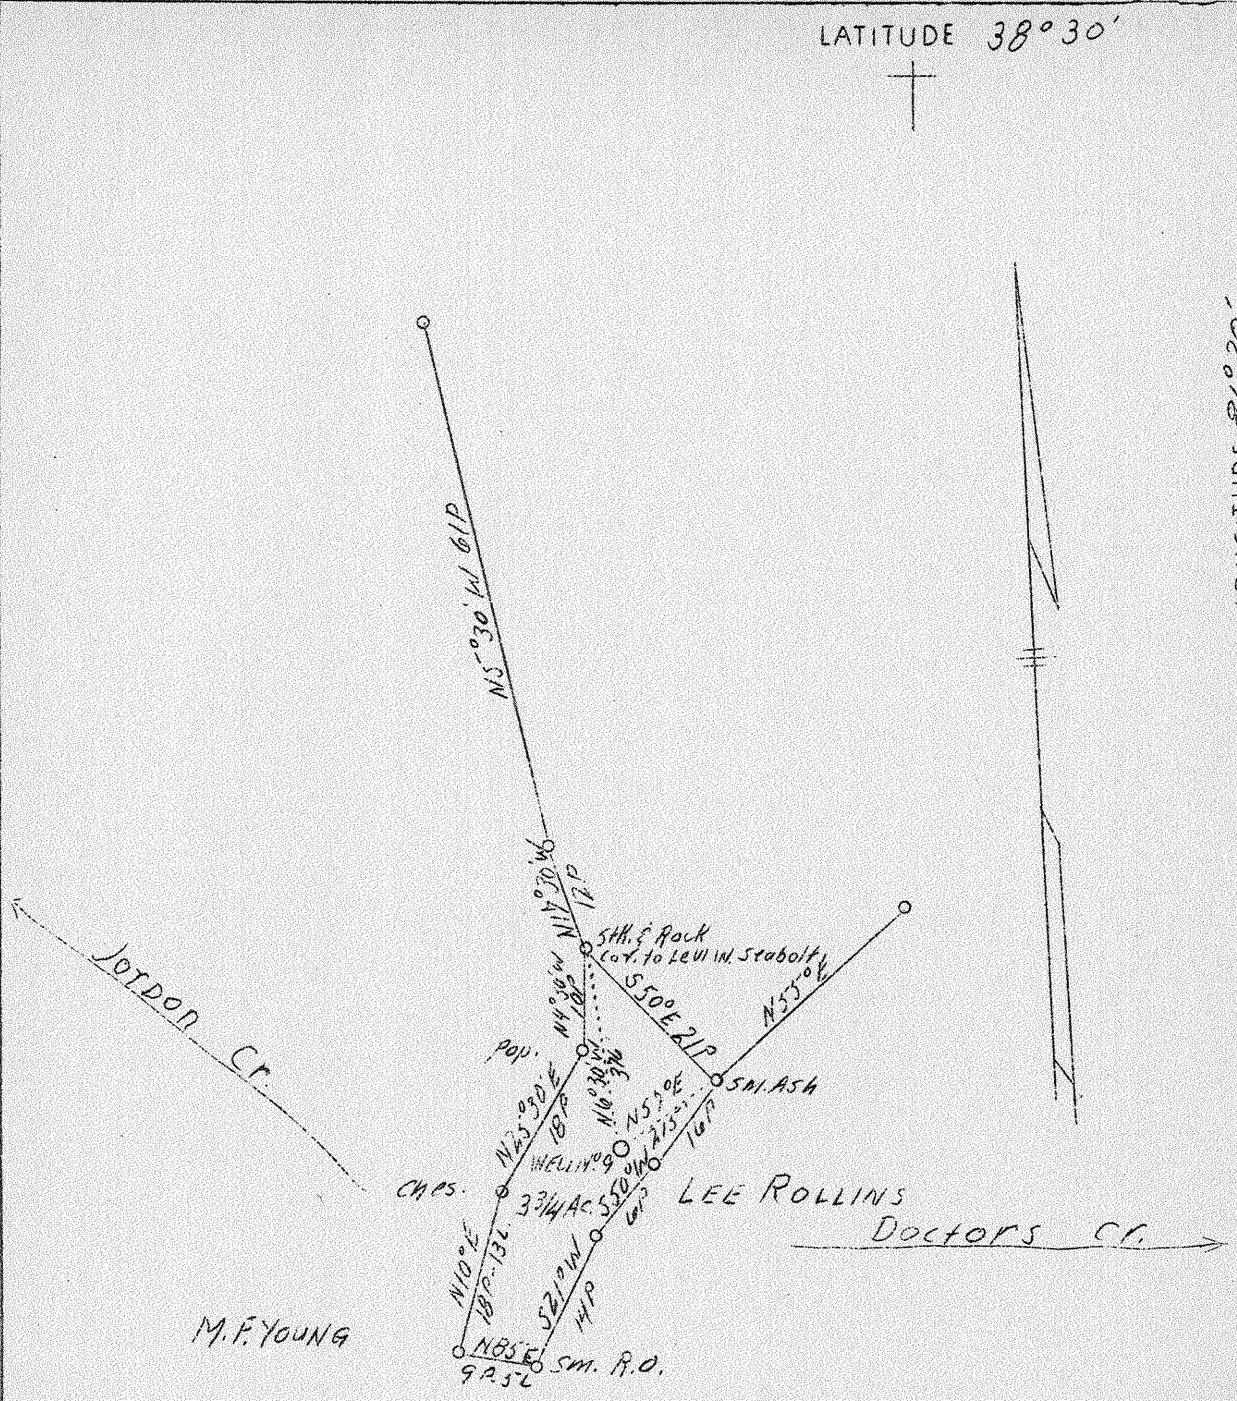

1.97 W
0.4 S

ABD.

JUL 17 1939

Company	Silman Oil & Gas Co.,
Address	311 Penna. Ave., Charleston, W. Va.
Farm	Brown - Mineral Levi W. Seabolt - Surface
Tract	1
Acres	3-3/4
Well (Farm) No.	9
Elevation (SL)	940
Quadrangle	Clendenin N. E.
County	Kanawha
District	Big Sandy
Engineer	A. E. Price
Eng. Reg. No.	819
Date	June 28, 1939
Scale	1" - 20 po. - 330'

HC

STATE OF WEST VIRGINIA
Department of Mines
OIL & GAS DIVISION
Charleston

WELL LOCATION MAP

File No. Kan-274-A

x Denotes location of well on U. S. Topographic Maps, scale 1 to 62,500, latitude and longitude lines being represented by border lines as shown.

- Denotes one inch spaces on border line of original tracing.

BROWN (Mineral) & LEVI W. SEABOLT (surface) NO. 9 - SILMAN OIL & GAS CO. - Kan-274-A.