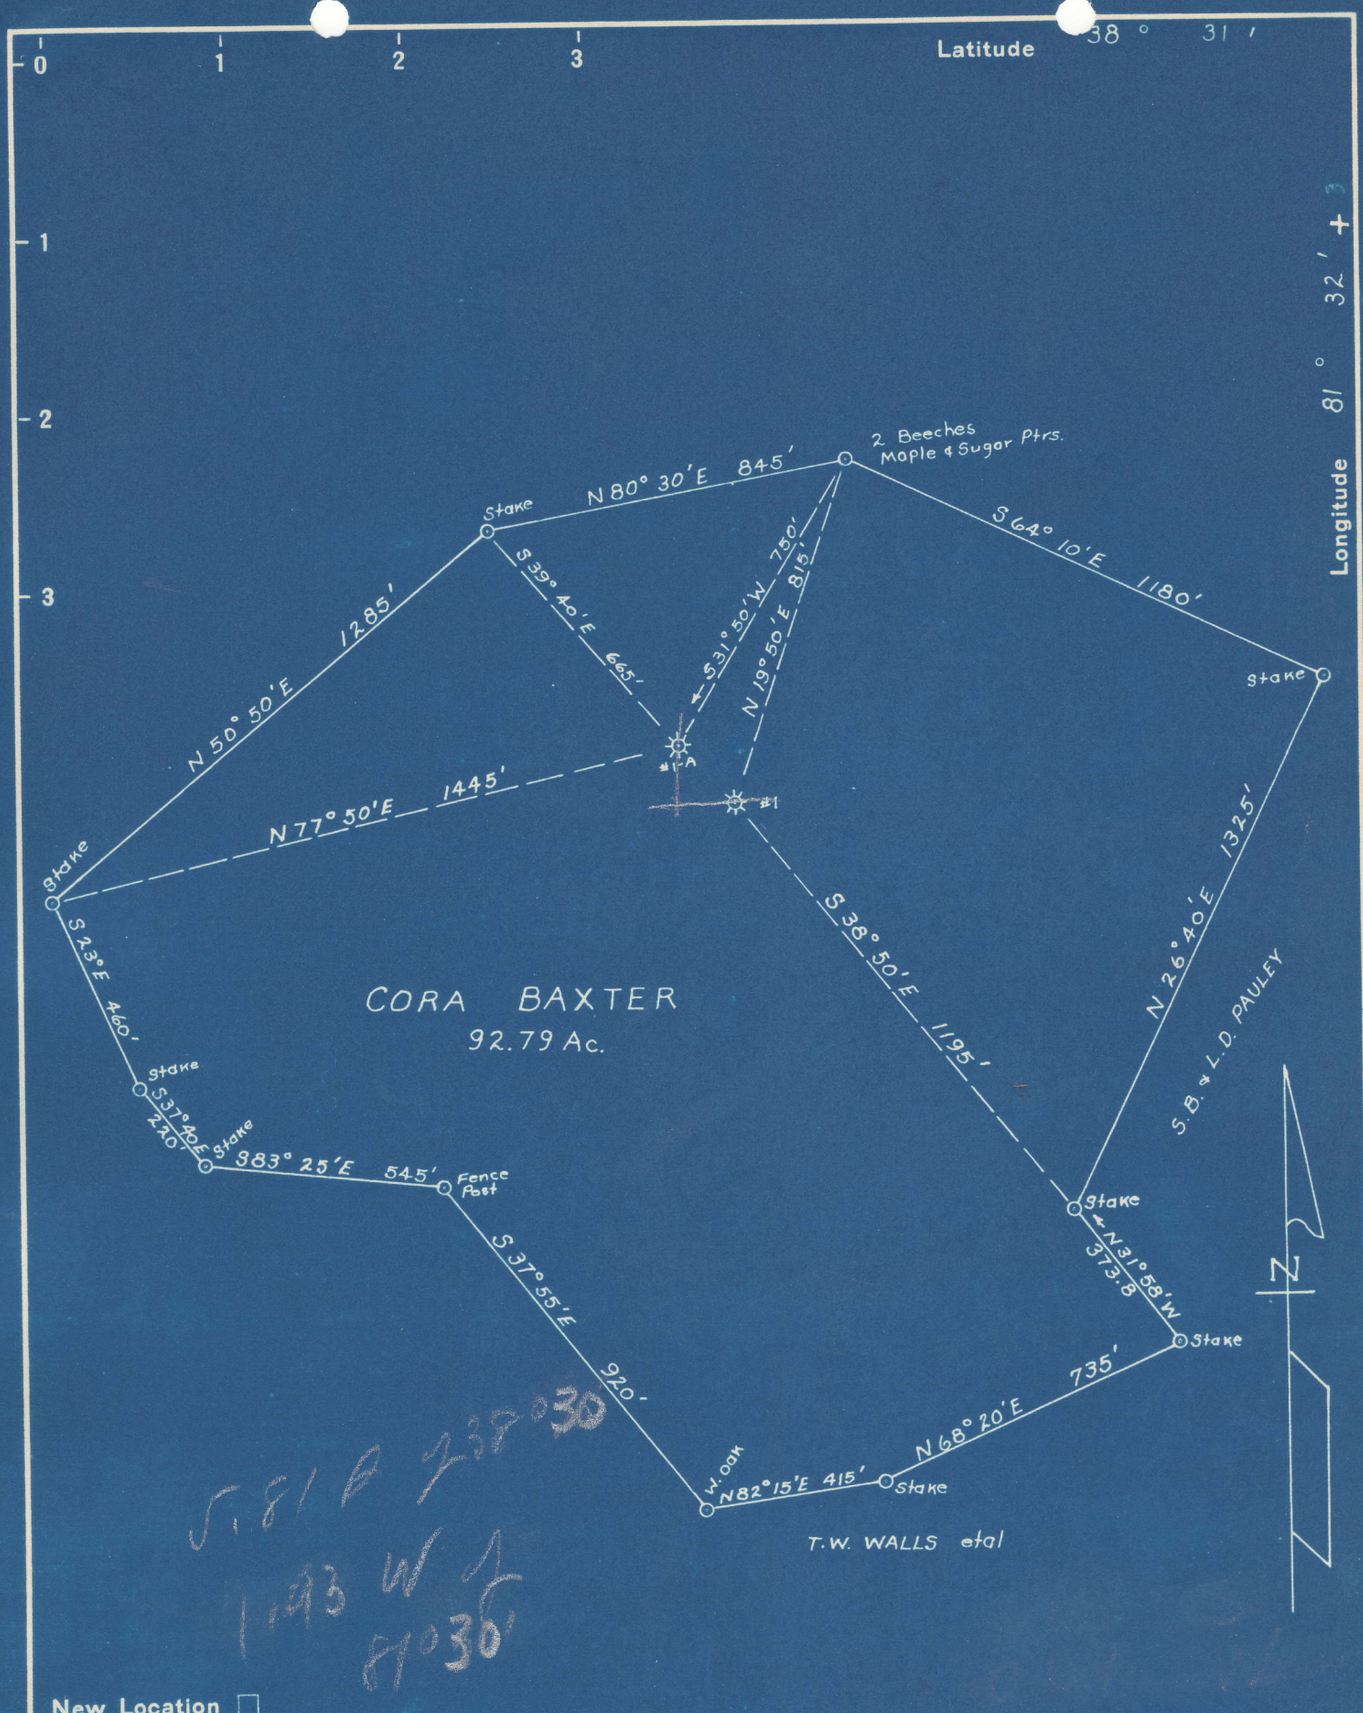

New Location.. ☐
Drill Deeper..... ☐
Abandonment..... ✚ #1-A

Company C. H. Bland ~~BENEDUM TREES OIL COMPANY~~
Address ~~PITTSBURGH, PA.~~ Charleston W. Va.
Farm CORA BAXTER
Tract ____ Acres 92.79 Lease No. ____
Well (Farm) No. ____ Serial No. ____
Elevation (Spirit Level) #1-A, 739.14 — #1, ~~741.72~~
Quadrangle KENNA
County KANAWHA District ELK
Engineer J. H. HIGH
Engineer's Registration No. 156
File No. ____ Drawing No. ____
Date June 1, 1937 Scale 1" = 400'

NE

STATE OF WEST VIRGINIA
DEPARTMENT OF MINES
OIL AND GAS DIVISION
CHARLESTON

WELL LOCATION MAP

FILE NO. KAN-526-A-#1-A

✚ Denotes location of well on United States Topographic Maps, scale 1 to 62,500, latitude and longitude lines being represented by border lines as shown.

— Denotes one inch spaces on border line of original tracing.

"IMPERIAL" TRACING CLOTH
K & E CO., N. Y.