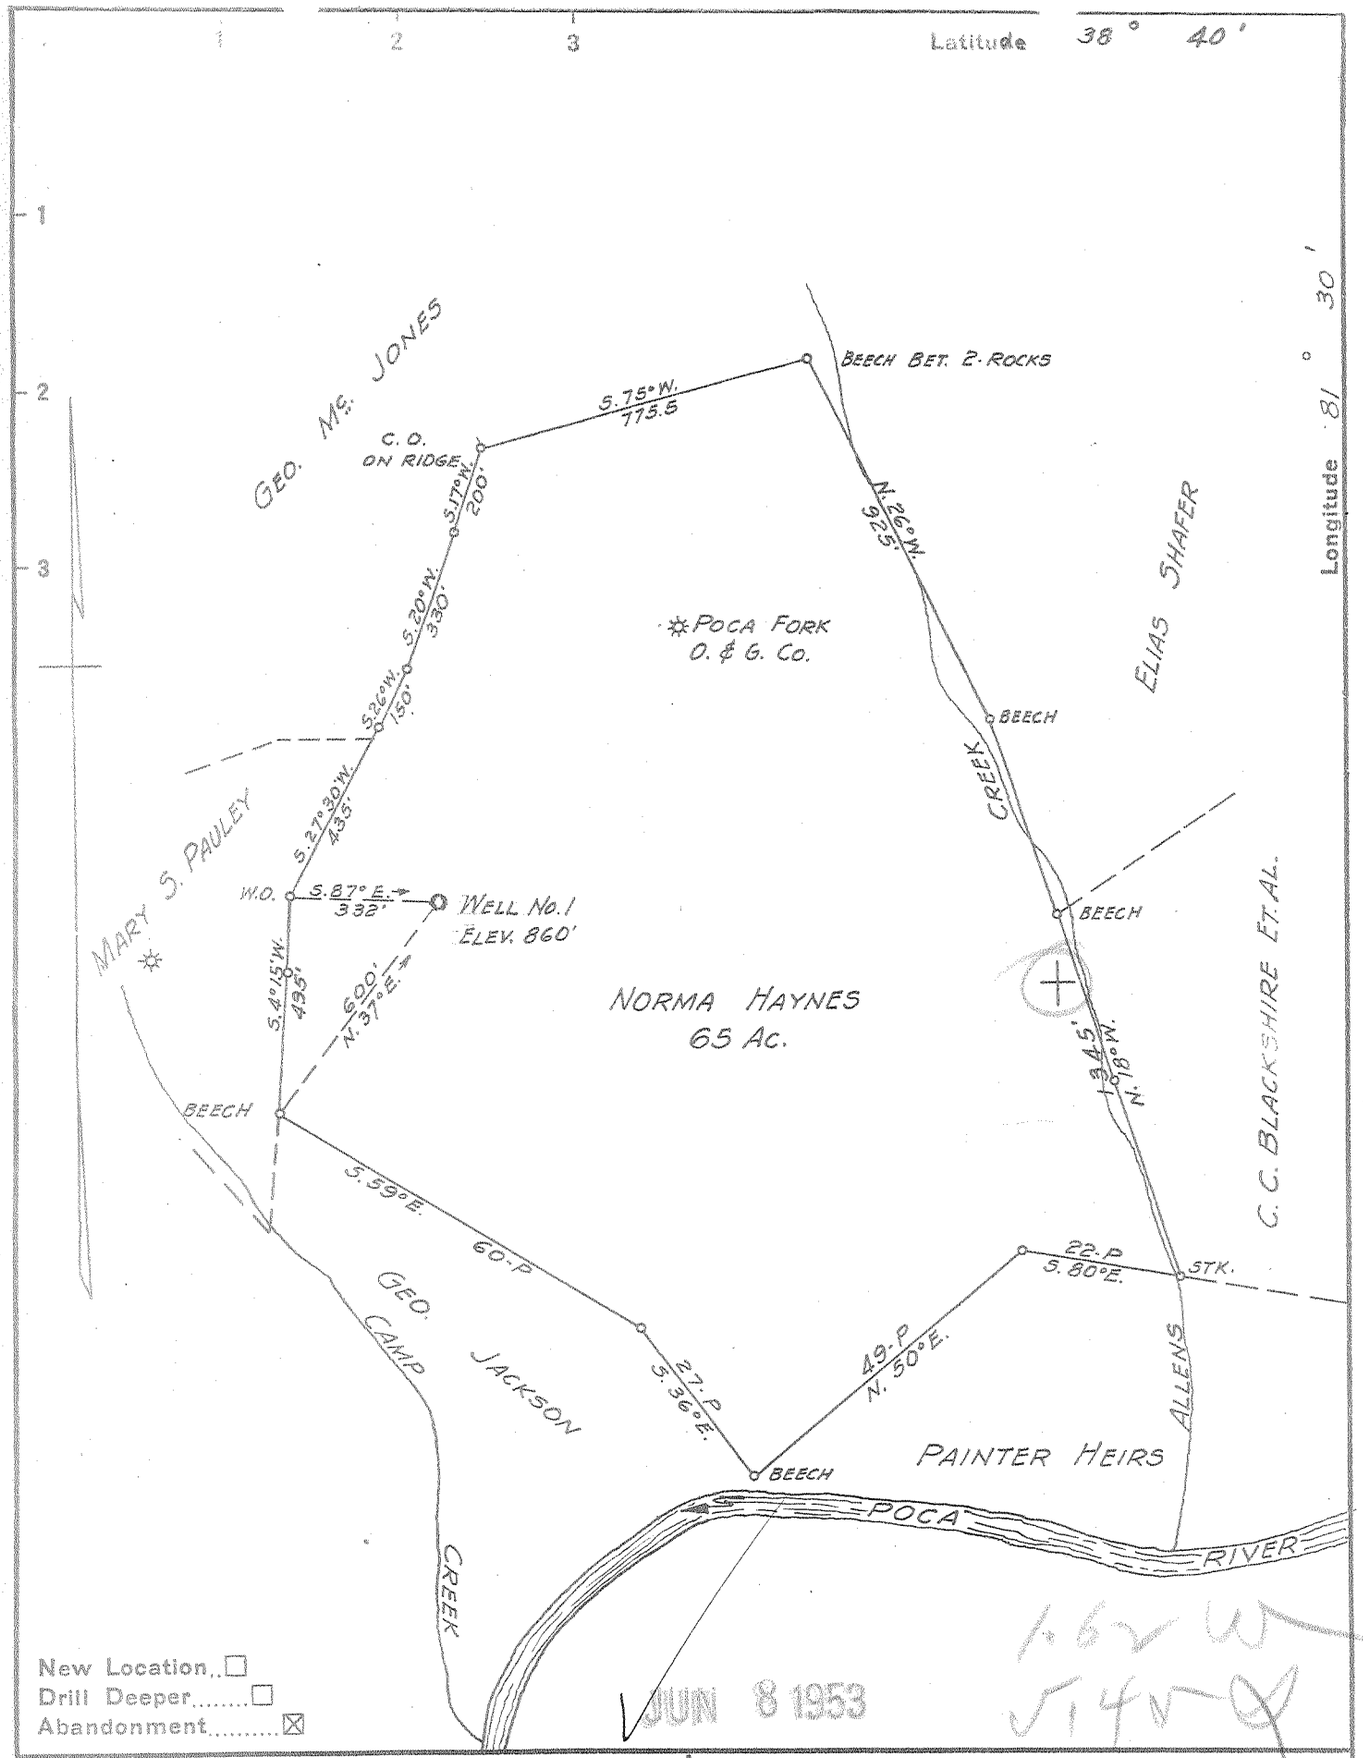

Company THE CHARTIERS OIL CO.
Address PITTSBURGH, PA.
Farm NORMA HAYNES
Tract ____ Acres 65 Lease No. ____
Well (Farm) No. 1 Serial No. ____
Elevation (Spirit Level) 860
Quadrangle KENNA
County KANAWHA District POCA
Engineer G. C. Ewing
Engineer's Registration No. 309
File No. ____ Drawing No. ____
Date 9-12-42 Scale 1" = 400'

STATE OF WEST VIRGINIA
DEPARTMENT OF MINES
OIL AND GAS DIVISION
CHARLESTON

WELL LOCATION MAP

FILE NO. KAN-1004-A

+ Denotes location of well on United States Topographic Maps, scale 1 to 62,500, latitude and longitude lines being represented by border lines as shown.

— Denotes one inch spaces on border line of original tracing.

NORMA HAYES NO. 1 — THE CHARTIERS OIL CO. — KAN-1004-A