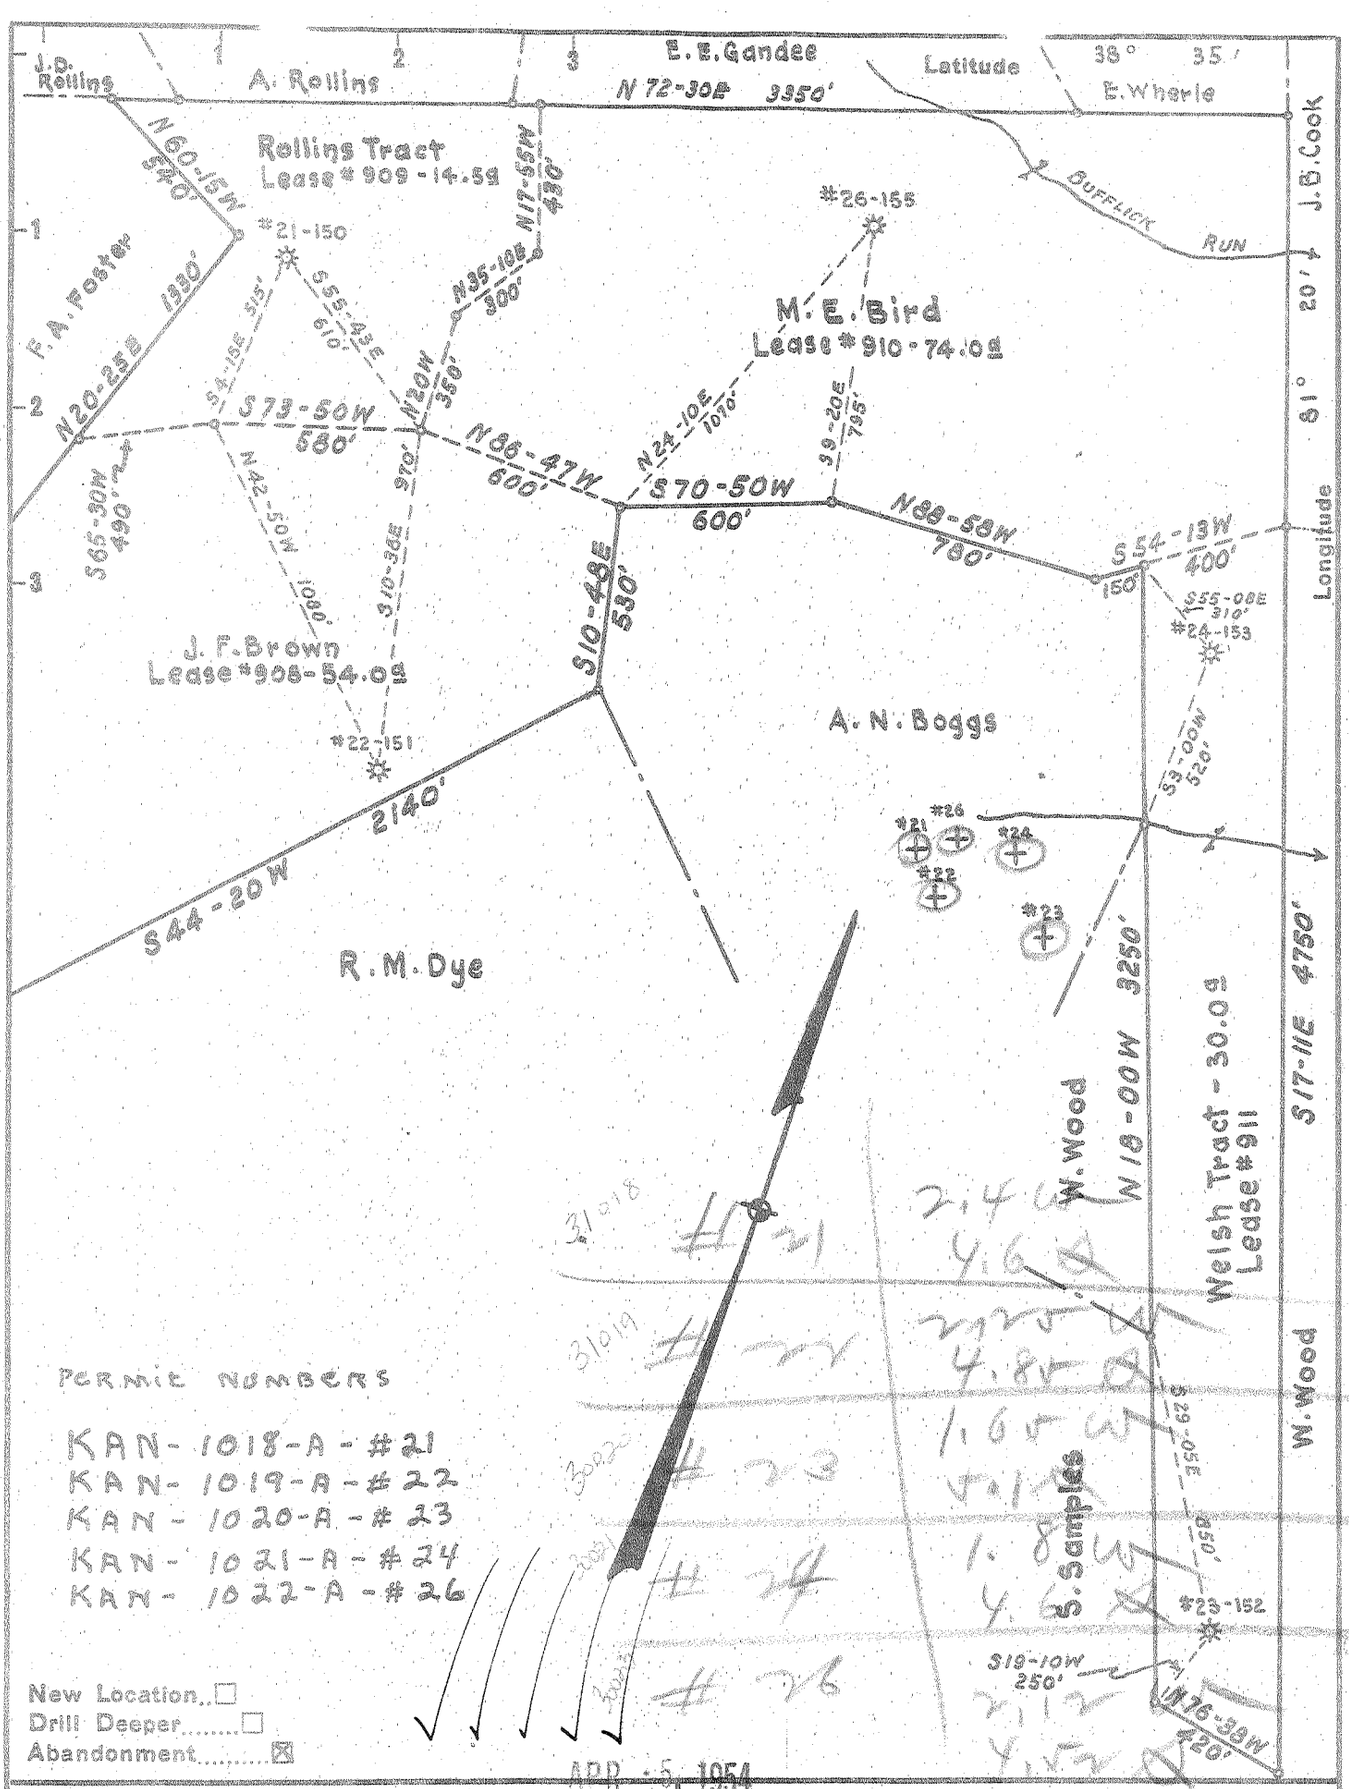

PERMIT NUMBERS

KAN-1018-A-#21
KAN-1019-A-#22
KAN-1020-A-#23
KAN-1021-A-#24
KAN-1022-A-#26

New Location.. ☐
Drill Deeper..... ☐
Abandonment..... ☒

APR 5 1954

Company UNITED CARBON COMPANY
Address CHARLESTON, WEST VA.
Farm J.F. BROWN (GAS RIGHTS ONLY)
Tract ____ Acres 172.5 Lease Nos. AS SHOWN
Well (Farm) Nos. 21, 22, 23, 24 & 26 Serial Nos. AS SHOWN
Elevation (Spirit Level) ____
Quadrangle WALTON
County KANAWHA District BIG SANDY
Engineer G.B. Wilson
Engineer's Registration No. 494
File No. 9-G & 10-G Drawing No. ____
Date ____ Scale 1" = 500'

STATE OF WEST VIRGINIA
DEPARTMENT OF MINES
OIL AND GAS DIVISION
CHARLESTON

WELL LOCATION MAP

FILE NO. See Above

+ Denotes location of well on United States Topographic Maps, scale 1 to 62,500, latitude and longitude lines being represented by border lines as shown.

— Denotes one inch spaces on border line of original tracing.

J.F. BROWN Nos. No. 21, 22, 23, 24, & 26 — UNITED CARBON Co. KAN-1018-A to 1022-A