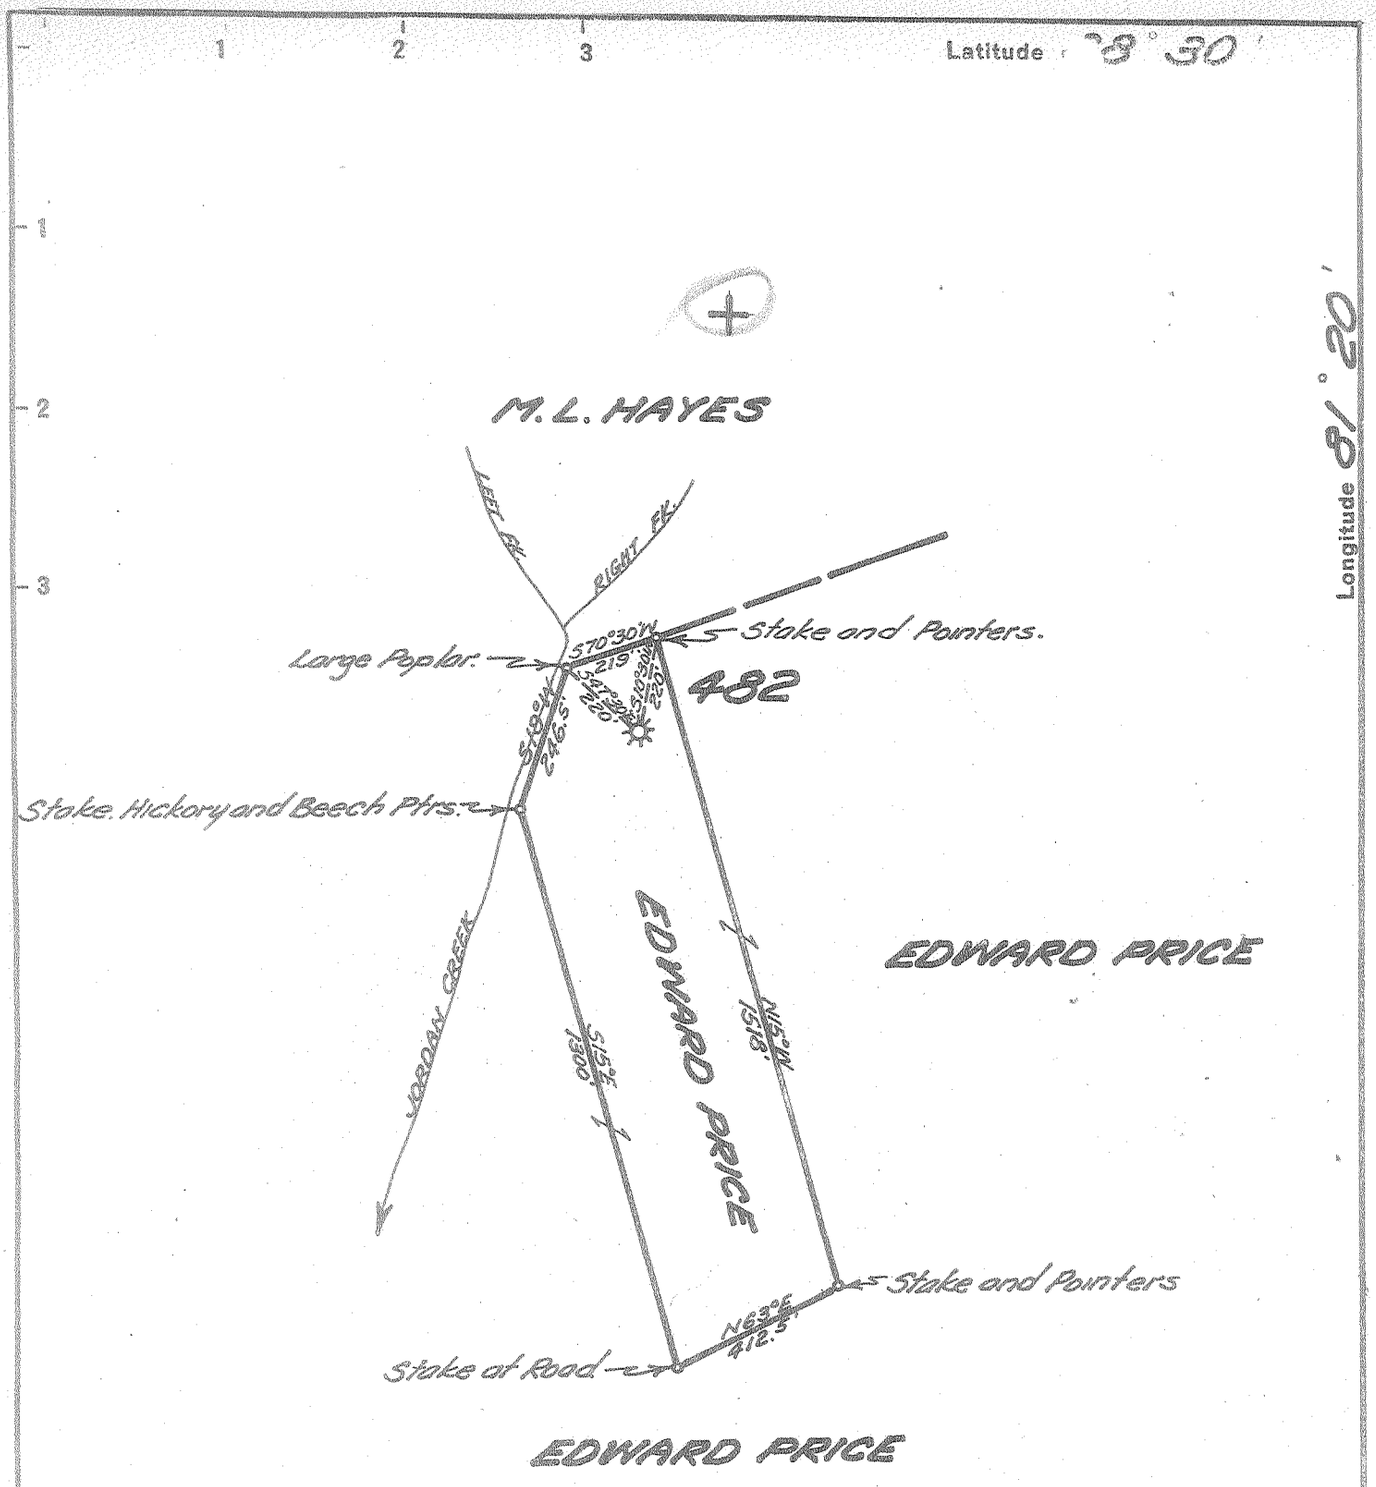

3.55 ac
1.67 ☐

New Location..☐
Drill Deeper.....☐
Abandonment.....■

MAY 3 1954

Company UNITED FUEL GAS CO.
Address CHARLESTON, W. VA.
Farm EDWARD PRICE
Tract _____ Acres 150 Lease No. 2163
Well (Farm) No. 1 Serial No. 482
Elevation (Spirit Level) 759.00'
Quadrangle CLENDENIN
County KANAWHA District BIG SANDY
Engineer [signature]
Engineer's Registration No. 669
File No. 74-67 Drawing No. _____
Date 4-20-54 Scale 1" = 400'

STATE OF WEST VIRGINIA
DEPARTMENT OF MINES
OIL AND GAS DIVISION
CHARLESTON

WELL LOCATION MAP

FILE NO. KAN-1034-A

+ Denotes location of well on United States Topographic Maps, scale 1 to 62,500, latitude and longitude lines being represented by border lines as shown.

— Denotes one inch spaces on border line of original tracing.

EDWARD PRICE No. 1 (482) — U.F.G. Co. — KAN-1034-A