




146 2730' 147 148 (GLOVERGAP) 4983 III SW 149 GLOVERGAP 1.5 MI FAIRMONT 1.3 MI 25' RECEIVED 1:250 000 FEET Office of Oil and Gas

SCALE 1:24 000

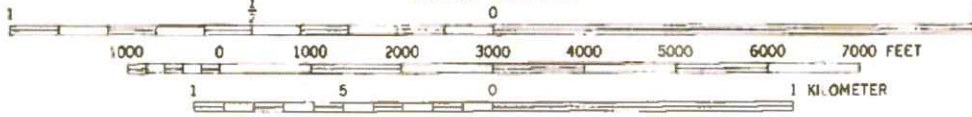

CONTOUR INTERVAL 20 FEET

3°22' 'Hundred; WV,PA' Scale: 1" = 0.379Mi 610Ml 2,000Ft. 1 Mi = 2.640" , 1 cm = 240ML DATUM OF 1929

FEB 17 2026 WV Department of Environmental Protection

03/20/2026

Well# 8110

HUNDRED WV / PA 7.5' Quad

Scale: 1" = 500'



1400

1300

1000

TRAIL

JEEP

Well# 8110

1300

1300

Fork

1300


RECEIVED
Office of Oil and Gas

FEB 17 2026

WV Department of
Environmental Protection

Access Road 

03/20/2026

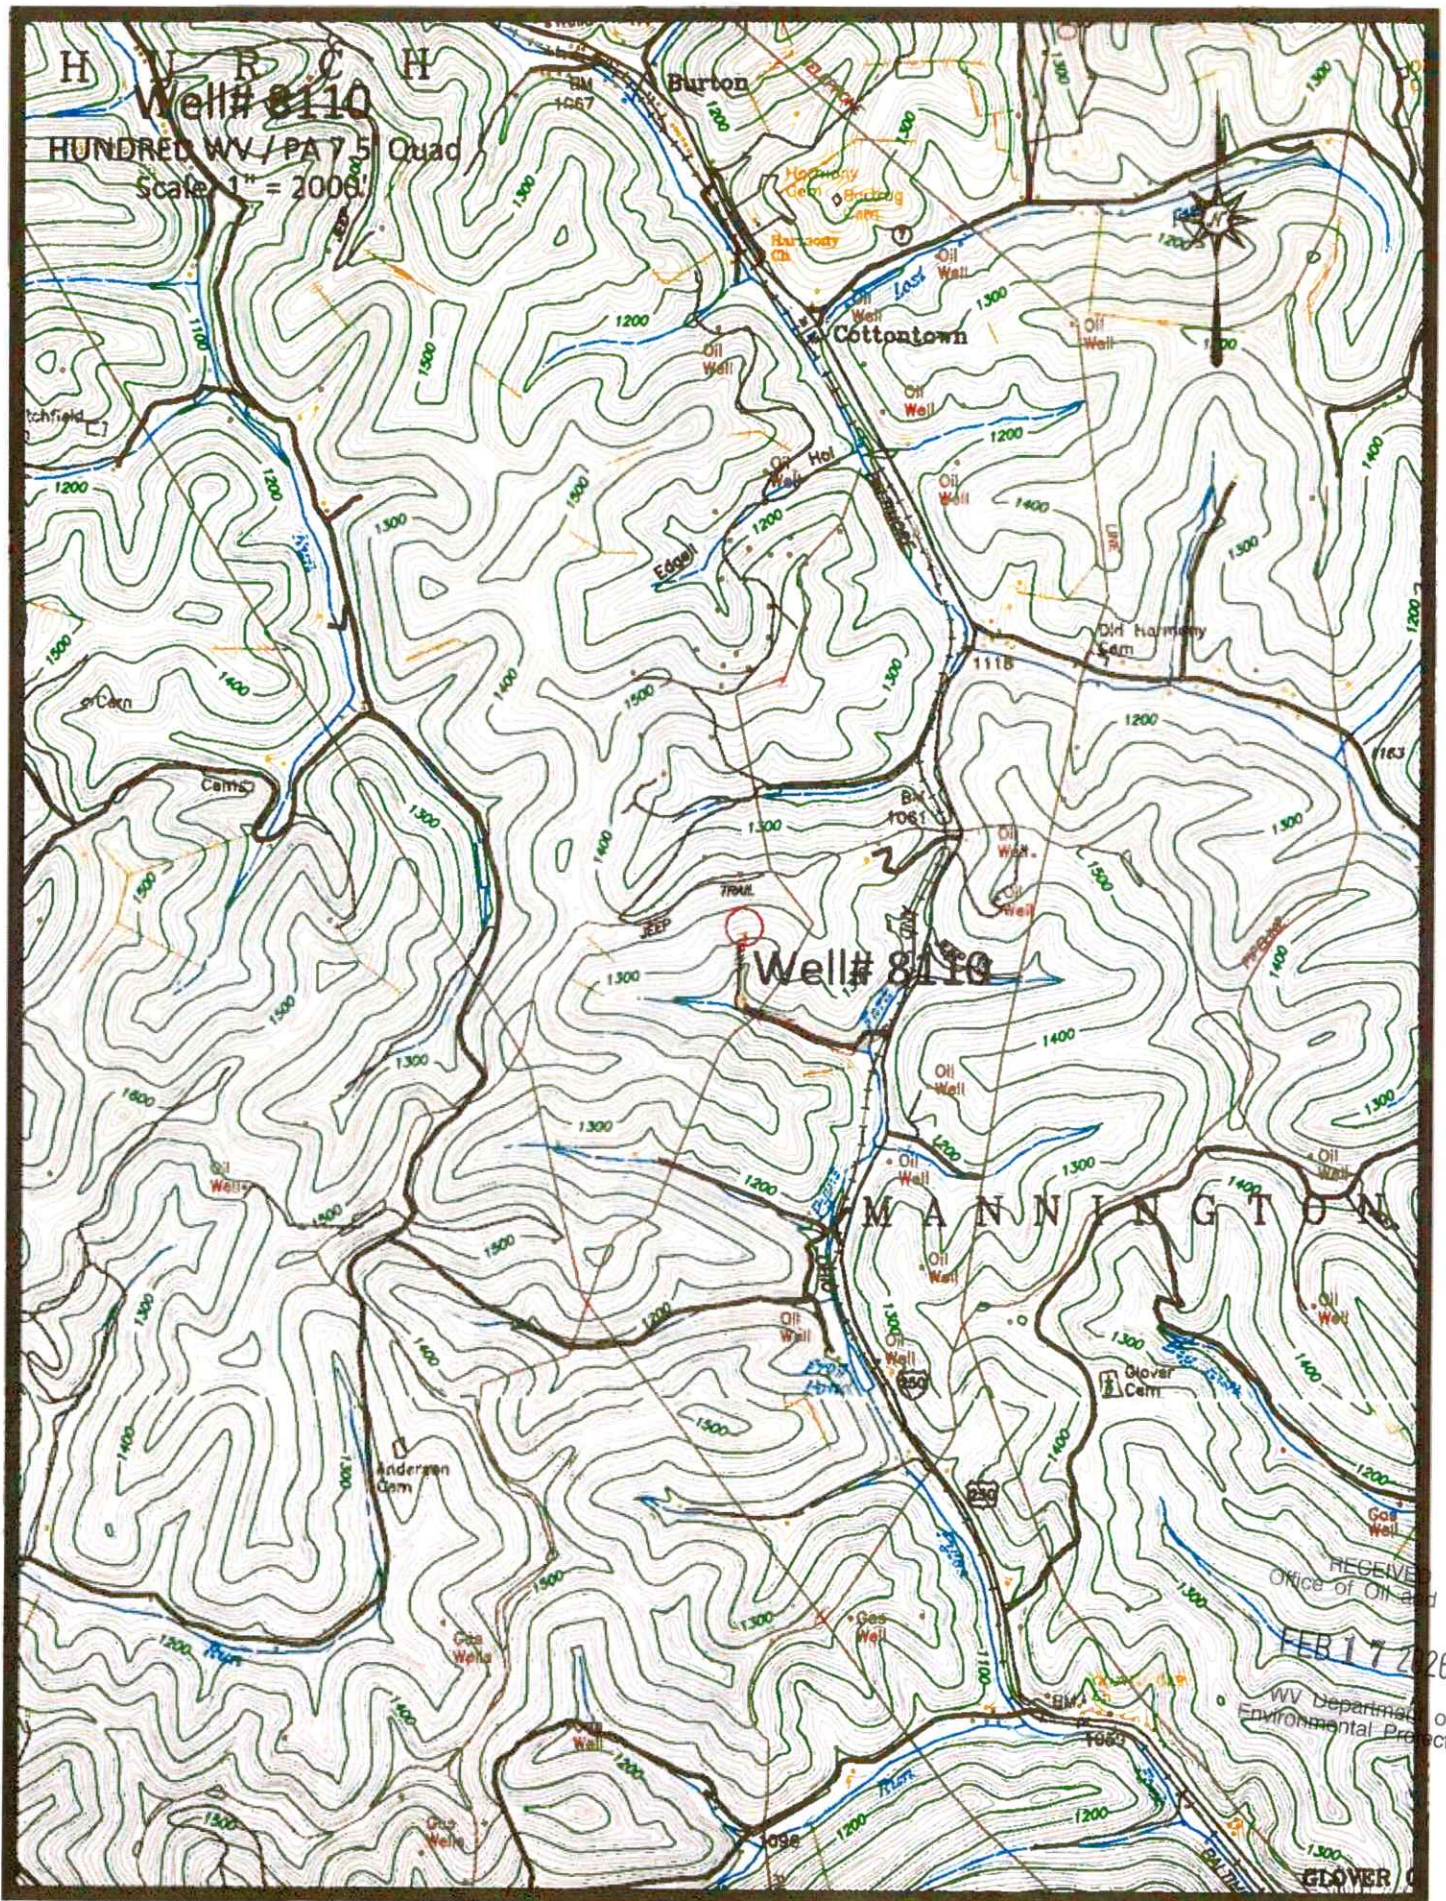

Access Road 

03/20/2026

RECEIVED
Office of Oil and Gas
FEB 17 2026
WV Department of
Environmental Protection

WW-7
8-30-06



West Virginia Department of Environmental Protection
Office of Oil and Gas

WELL LOCATION FORM: GPS

API: 47-049-00572 WELL NO.: 8110

FARM NAME: GEORGE RICE

RESPONSIBLE PARTY NAME: WEST VIRGINIA LAND RESOURCES INC.

COUNTY: MARION DISTRICT: MANNINGTON

QUADRANGLE: HUNDRED WV, PA

SURFACE OWNER: WILLIAM G. KUHN

ROYALTY OWNER: _____

UTM GPS NORTHING: 4,387,869 m

UTM GPS EASTING: 549,194 m GPS ELEVATION: 406 m

The Responsible Party named above has chosen to submit GPS coordinates in lieu of preparing a new well location plat for a plugging permit or assigned API number on the above well. The Office of Oil and Gas will not accept GPS coordinates that do not meet the following requirements:

- Datum: NAD 1983, Zone: 17 North, Coordinate Units: meters, Altitude: height above mean sea level (MSL) - meters.
- Accuracy to Datum - 3.05 meters
- Data Collection Method:

Survey grade GPS : Post Processed Differential _____

Real-Time Differential

Mapping Grade GPS _____ : Post Processed Differential _____

Real-Time Differential _____

- Letter size copy of the topography map showing the well location.**

I the undersigned, hereby certify this data is correct to the best of my knowledge and belief and shows all the information required by law and the regulations issued and prescribed by the Office of Oil and Gas.

Signature

PS2002

Title

JANUARY 30, 2026

Date

RECEIVED
Office of Oil and Gas

FEB 17 2026

WV Department of
Environmental Protection

03/20/2026