

West Virginia Department of Environmental Protection
Office of Oil & Gas

WELL LOCATION FORM: GPS

API: 47- 049 -00600 WELL NO: No.2

FARM NAME: James Yost

RESPONSIBLE PARTY NAME: HG Energy, LLC

COUNTY: Marion DISTRICT: Paw Paw

QUADRANGLE: Grant Town 7.5'

SURFACE OWNER: William P. Foley

ROYALTY OWNER: HG Energy LLC et al.

UTM GPS NORTHING: 4,383,634

UTM GPS EASTING: 564,589 GPS ELEVATION: 349 m.


The Responsible Party named above has chosen to submit GPS coordinates in lieu of preparing a new well location plat for a plugging permit on the above well. The Office of Oil & Gas will not accept GPS coordinates that do not meet the following requirements:

1. Datum: NAD 1983, Zone:17 North, Coordinate Units: meters, Altitude: height above mean sea level (MSL) - meters.
2. Accuracy to Datum - 3.05 meters
3. Data Collection Method:

Survey Grade GPS Post Processed Differential
 Real-Time Differential

Mapping Grade GPS Post Processed Differential
 Real-Time Differential

I the undersigned, hereby certify this data is correct to the best of my knowledge and belief and shows all the information required by law and the regulations issued and prescribed by the Office of Oil and Gas.



 Signature Timothy P. Roush


RECEIVED
 Office of Oil and Gas
 February 13, 2013

 Title Professional Surveyor

_____ February 13, 2013
 Date

West Virginia Department of Environmental Protection

SUBJECT WELL
James Yost No.2
47-04900600

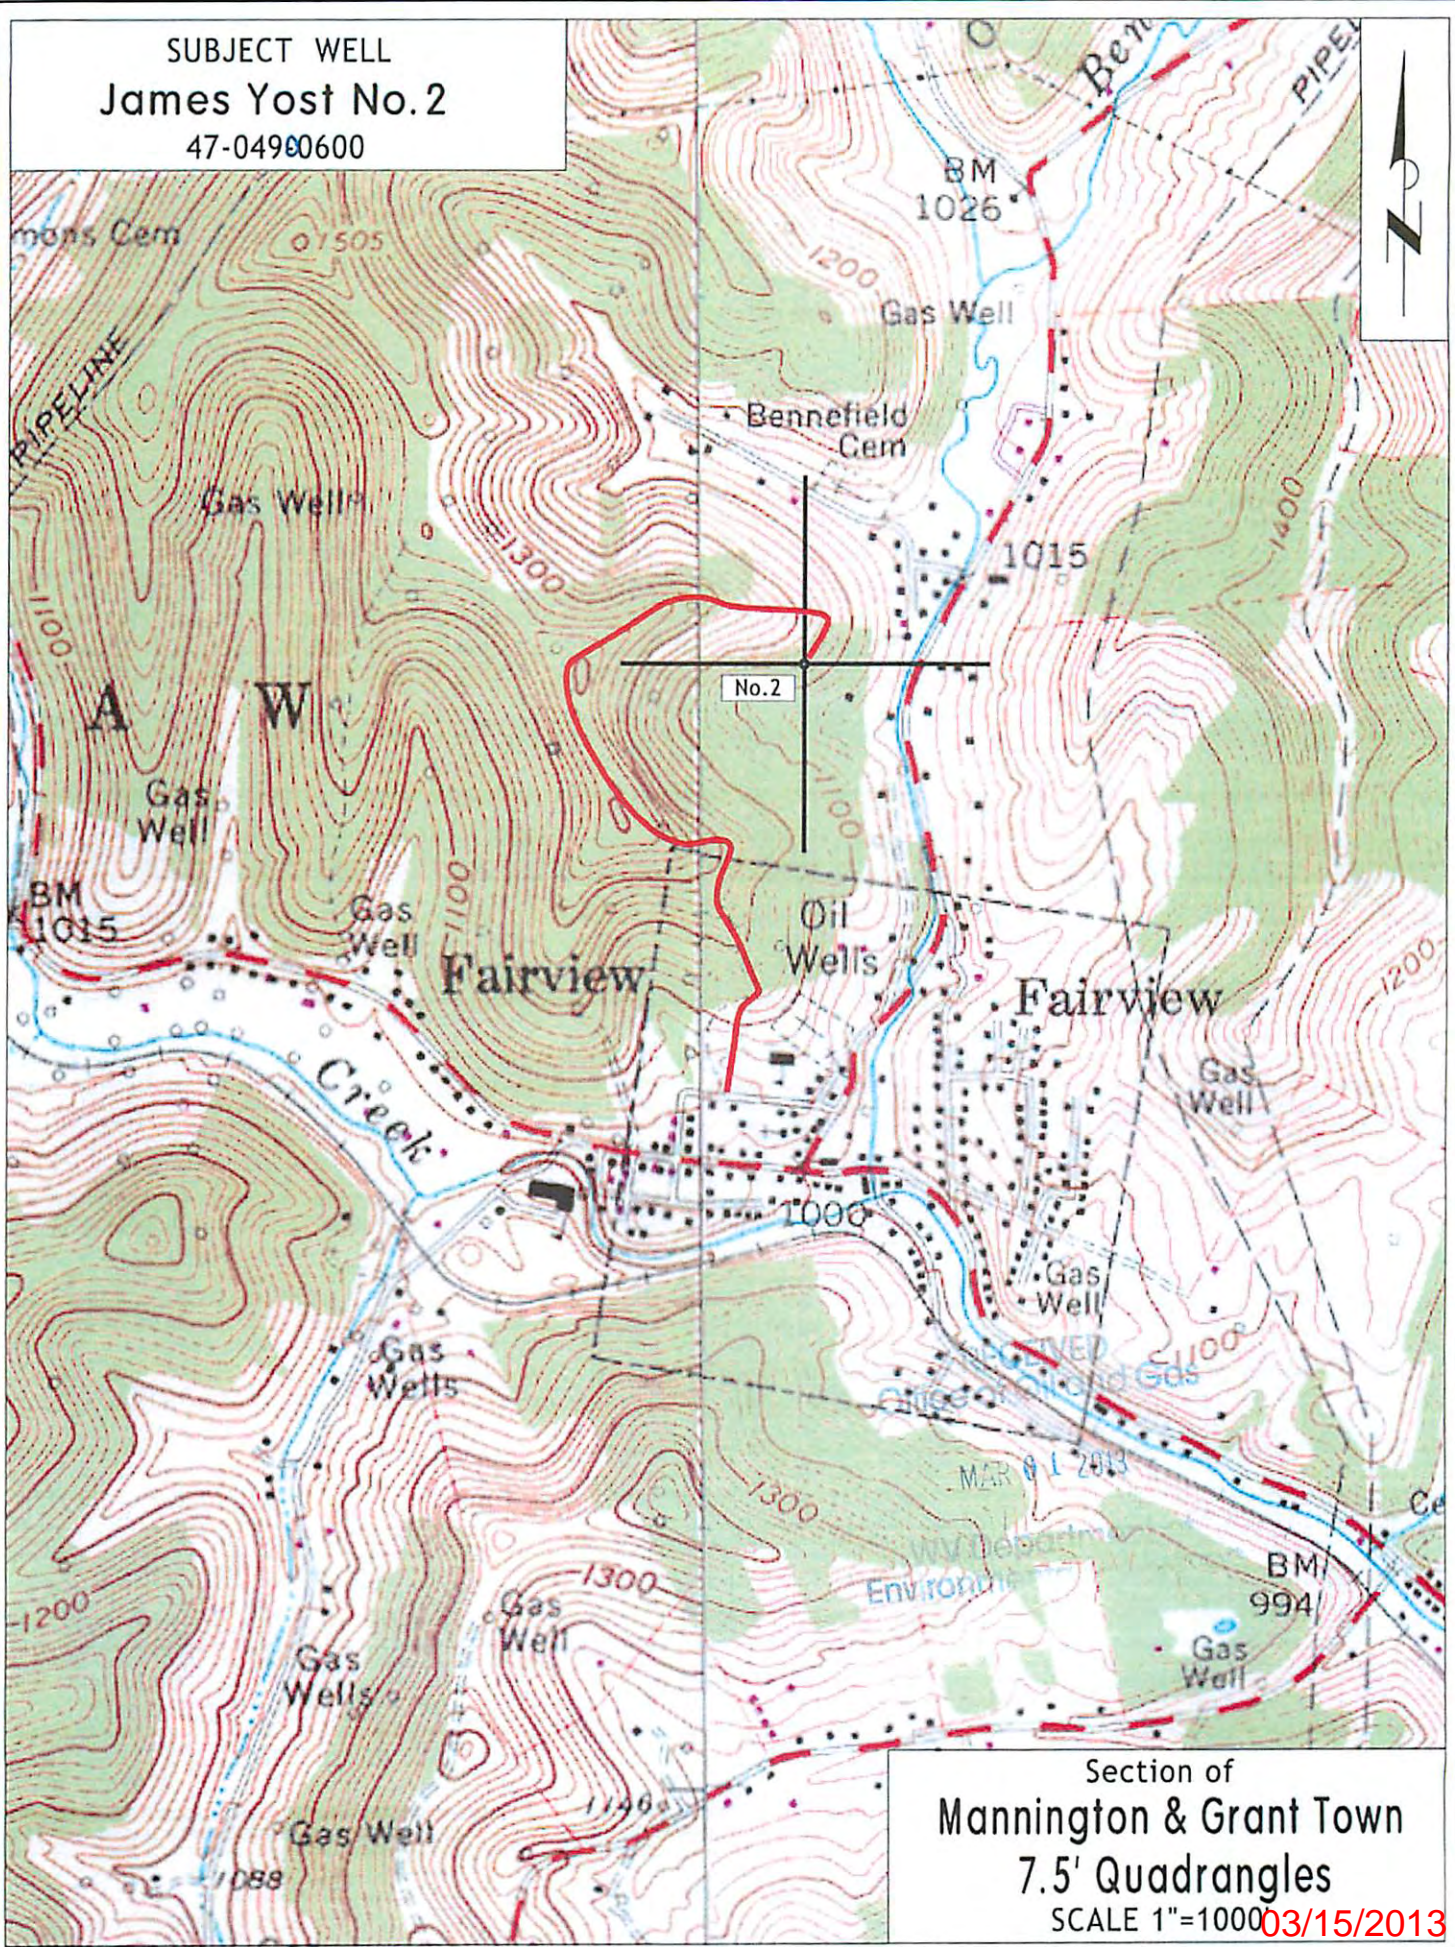

Section of
Mannington & Grant Town
7.5' Quadrangles
SCALE 1"=1000 03/15/2013