

4901940W

RECEIVED  
Office of Oil and Gas

JUN 23 2016

WV Department of  
Environmental Protection

WW-7  
8-30-06



West Virginia Department of Environmental Protection  
Office of Oil and Gas

WELL LOCATION FORM: GPS

API: 47-049-01940 WELL NO.: 608271

FARM NAME: J. Lawlis

RESPONSIBLE PARTY NAME: Equitrans L.P.

COUNTY: Marion DISTRICT: Mannington

QUADRANGLE: Glover Gap 7.5

SURFACE OWNER: Consolidation Coal Company

ROYALTY OWNER: William M. Burnside Et Al

UTM GPS NORTHING: 4374415.682

UTM GPS EASTING: 548091.594 GPS ELEVATION: 311.2008 meters (1021')

The Responsible Party named above has chosen to submit GPS coordinates in lieu of preparing a new well location plat for a plugging permit or assigned API number on the above well. The Office of Oil and Gas will not accept GPS coordinates that do not meet the following requirements:

1. Datum: NAD 1983, Zone: 17 North, Coordinate Units: meters, Altitude: height above mean sea level (MSL) – meters.
2. Accuracy to Datum – 3.05 meters
3. Data Collection Method:

Survey grade GPS  : Post Processed Differential

Real-Time Differential

Mapping Grade GPS  : Post Processed Differential

Real-Time Differential

4. Letter size copy of the topography map showing the well location.

I the undersigned, hereby certify this data is correct to the best of my knowledge and belief and shows all the information required by law and the regulations issued and prescribed by the Office of Oil and Gas.


*Jeffery Lawright*  
Signature Jeffery Lawright

Landman III  
Title

6-23-16  
Date

08/05/2016



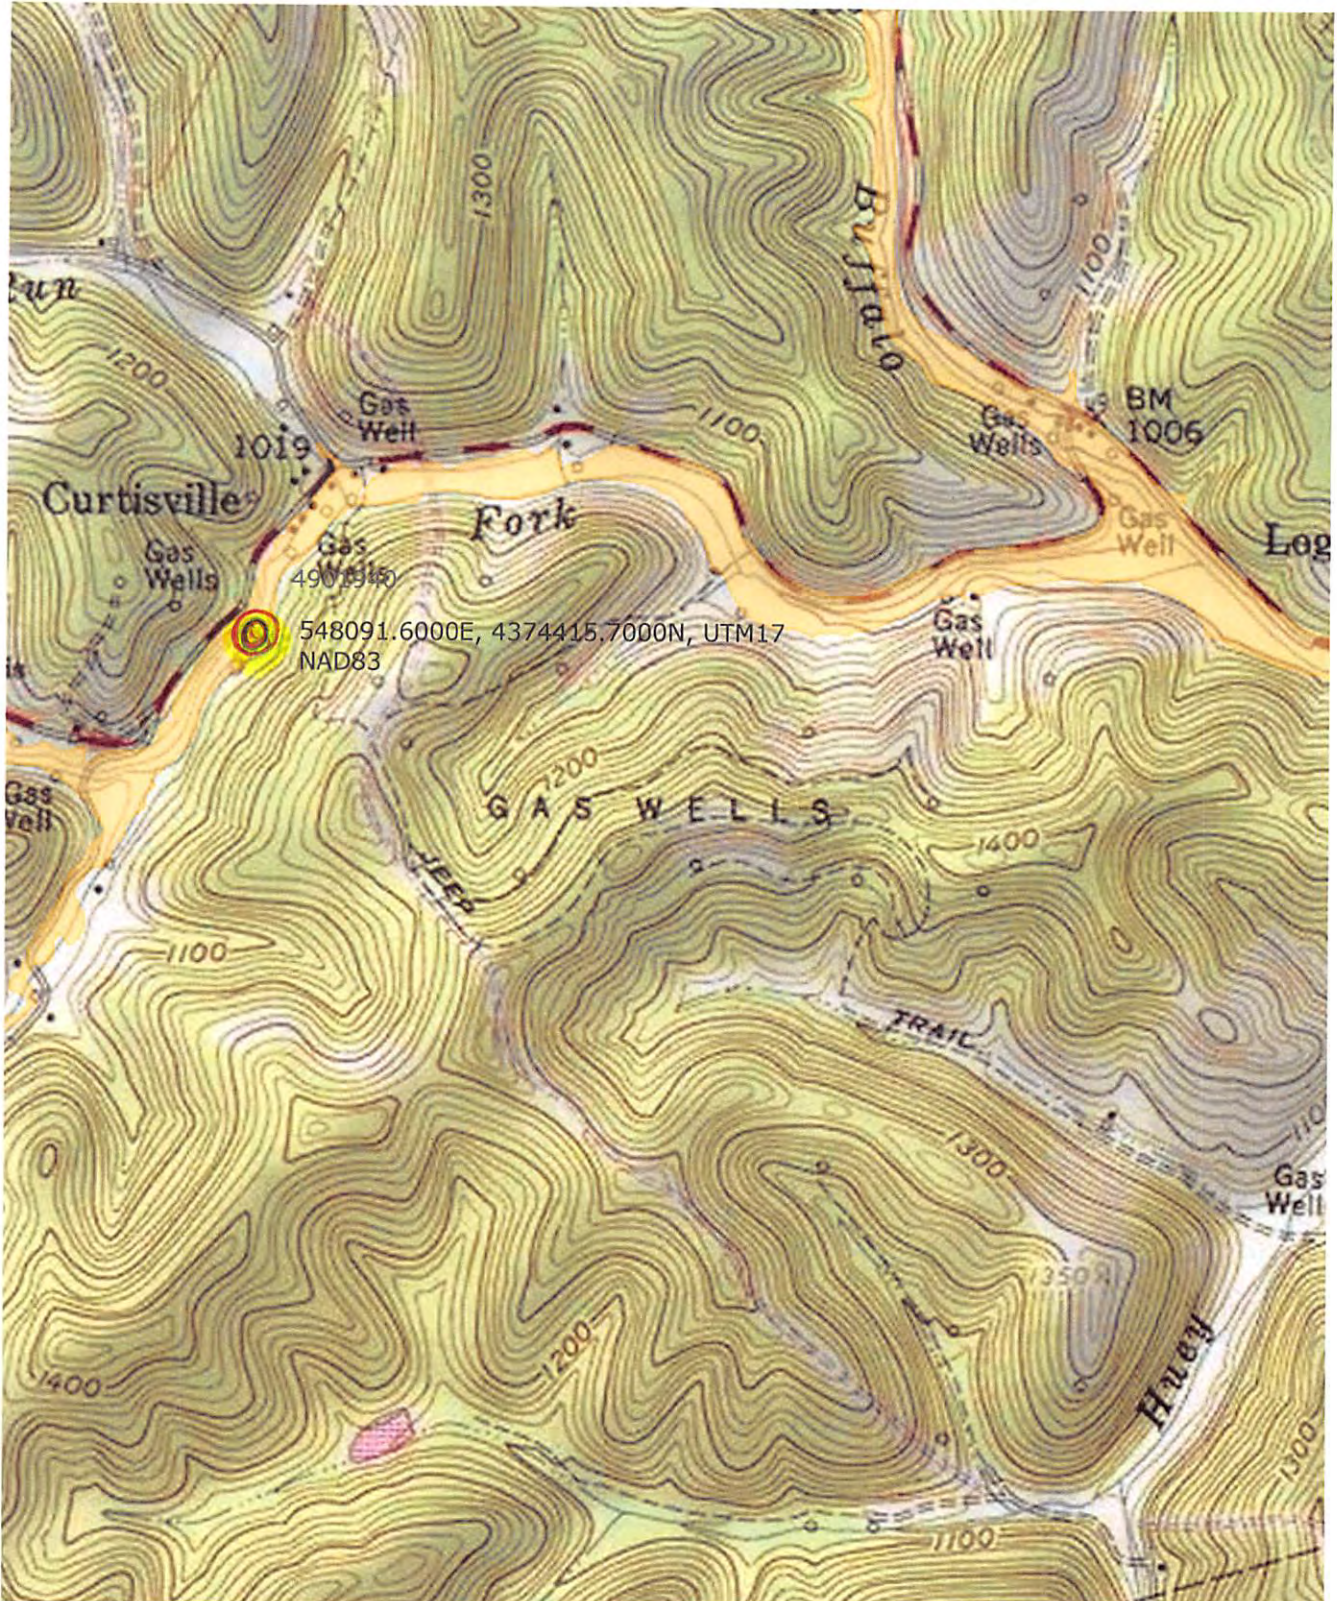

08/05/2016