

27130"

547

548

4963 III NW
(HUNDRED)

549

SHILETON NW
BURTON 1 M

4704902283

551



11/10/2023

4704902283

WW-7
8-30-06



West Virginia Department of Environmental Protection
Office of Oil and Gas

WELL LOCATION FORM: GPS

API: 47-049-02283 WELL NO.: JONES 3

FARM NAME: JONES

RESPONSIBLE PARTY NAME: WEST VIRGINIA LAND RESOURCES INC.

COUNTY: MARION DISTRICT: MANNINGTON

QUADRANGLE: GLOVER GAP WV

SURFACE OWNER: JASON G. & MICHELLE R. STOUT

ROYALTY OWNER: _____

UTM GPS NORTHING: 4,381,937 m

UTM GPS EASTING: 549,192 m GPS ELEVATION: 345 m

The Responsible Party named above has chosen to submit GPS coordinates in lieu of preparing a new well location plat for a plugging permit or assigned API number on the above well. The Office of Oil and Gas will not accept GPS coordinates that do not meet the following requirements:

- Datum: NAD 1983, Zone: 17 North, Coordinate Units: meters, Altitude: height above mean sea level (MSL) – meters.
- Accuracy to Datum – 3.05 meters
- Data Collection Method:

Survey grade GPS _____; Post Processed Differential _____

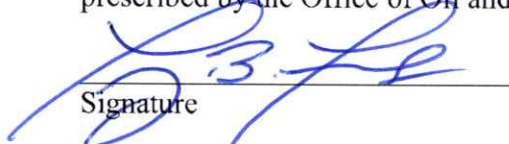
Real-Time Differential _____

Mapping Grade GPS ; Post Processed Differential

Real-Time Differential _____

- Letter size copy of the topography map showing the well location.**

I the undersigned, hereby certify this data is correct to the best of my knowledge and belief and shows all the information required by law and the regulations issued and prescribed by the Office of Oil and Gas.


Signature

PS2002
Title

AUGUST 31, 2023
Date

RECEIVED
Office Of Oil and Gas

OCT 10 2023

WV Department of
Environmental Protection

11/10/2023