

# EQT PRODUCTION

Marion County, WV

Elliott Pad

Elliott 10H L-003932 - Slot Elliott 10H SHL

Main

Design: Elliott 10H As Drilled

## Survey Report - Geographic

12 June, 2025

RECEIVED  
Office of Oil and Gas

JAN 15 2026

WV Department of  
Environmental Protection



[www.scientificdrilling.com](http://www.scientificdrilling.com)



04/24/2026

## Survey Report - Geographic

<b>Company:</b>	EQT PRODUCTION	<b>Local Co-ordinate Reference:</b>	Well Elliott 10H L-003932 - Slot Elliott 10H SHL
<b>Project:</b>	Marion County, WV	<b>TVD Reference:</b>	KB@28 @ 1371.0usft
<b>Site:</b>	Elliott Pad	<b>MD Reference:</b>	KB@28 @ 1371.0usft
<b>Well:</b>	Elliott 10H L-003932	<b>North Reference:</b>	Grid
<b>Wellbore:</b>	Main	<b>Survey Calculation Method:</b>	Minimum Curvature
<b>Design:</b>	Elliott 10H As Drilled	<b>Database:</b>	EQT

<b>Project</b> Marion County, WV			
<b>Map System:</b>	US State Plane 1927 (Exact solution)	<b>System Datum:</b>	Mean Sea Level
<b>Geo Datum:</b>	NAD 1927 (NADCON CONUS)		
<b>Map Zone:</b>	West Virginia North 4701		

<b>Site</b> Elliott Pad			
<b>Site Position:</b>		<b>Northing:</b>	381,889.78 usft
<b>From:</b>	Map	<b>Easting:</b>	1,751,187.95 usft
<b>Position Uncertainty:</b>	0.0 usft	<b>Slot Radius:</b>	13-3/16 "
		<b>Latitude:</b>	39° 32' 42.563 N
		<b>Longitude:</b>	80° 22' 56.331 W
		<b>Grid Convergence:</b>	-0.56 °

<b>Well</b> Elliott 10H L-003932 - Slot Elliott 10H SHL						
<b>Well Position</b>	+N/-S	0.0 usft	<b>Northing:</b>	381,973.81 usft	<b>Latitude:</b>	39° 32' 43.397 N
	+E/-W	0.0 usft	<b>Easting:</b>	1,751,227.36 usft	<b>Longitude:</b>	80° 22' 55.839 W
<b>Position Uncertainty</b>		0.0 usft	<b>Wellhead Elevation:</b>	usft	<b>Ground Level:</b>	1,343.0 usft

<b>Wellbore</b> Main			
----------------------	--	--	--

Magnetics	Model Name	Sample Date	Declination (°)	Dip Angle (°)	Field Strength (nT)
	IFR	5/8/2025	-8.96	66.13	51,410.60000000

<b>Design</b> Elliott 10H As Drilled				
<b>Audit Notes:</b>				
<b>Version:</b>	1.0	<b>Phase:</b>	ACTUAL	
		<b>Tie On Depth:</b>	0.0	
<b>Vertical Section:</b>	<b>Depth From (TVD) (usft)</b>	<b>+N/-S (usft)</b>	<b>+E/-W (usft)</b>	<b>Direction (°)</b>
	0.0	0.0	0.0	153.13

<b>Survey</b>									
Measured Depth (usft)	Inclination (°)	Azimuth (°)	Vertical Depth (usft)	+N/-S (usft)	+E/-W (usft)	Map Northing (usft)	Map Easting (usft)	Latitude	Longitude
0.0	0.00	0.00	0.0	0.0	0.0	381,973.81	1,751,227.36	39° 32' 43.397 N	80° 22' 55.839 W
115.0	0.07	176.92	115.0	-0.1	0.0	381,973.74	1,751,227.37	39° 32' 43.397 N	80° 22' 55.839 W
215.0	0.12	164.36	215.0	-0.2	0.0	381,973.58	1,751,227.40	39° 32' 43.395 N	80° 22' 55.838 W
315.0	0.09	264.38	315.0	-0.3	0.0	381,973.47	1,751,227.35	39° 32' 43.394 N	80° 22' 55.839 W
415.0	0.18	242.03	415.0	-0.4	-0.2	381,973.39	1,751,227.13	39° 32' 43.393 N	80° 22' 55.842 W
515.0	0.21	170.49	515.0	-0.7	-0.3	381,973.13	1,751,227.02	39° 32' 43.391 N	80° 22' 55.843 W
615.0	0.13	127.71	615.0	-0.9	-0.2	381,972.88	1,751,227.14	39° 32' 43.388 N	80° 22' 55.841 W
715.0	0.06	117.11	715.0	-1.0	-0.1	381,972.79	1,751,227.28	39° 32' 43.387 N	80° 22' 55.840 W
815.0	0.07	67.19	815.0	-1.0	0.0	381,972.79	1,751,227.38	39° 32' 43.387 N	80° 22' 55.838 W
915.0	0.08	9.01	915.0	-0.9	0.1	381,972.88	1,751,227.45	39° 32' 43.388 N	80° 22' 55.837 W
1,116.0	0.17	113.17	1,116.0	-0.9	0.4	381,972.90	1,751,227.75	39° 32' 43.388 N	80° 22' 55.834 W
1,159.0	0.24	54.54	1,159.0	-0.9	0.5	381,972.93	1,751,227.88	39° 32' 43.389 N	80° 22' 55.832 W
1,203.0	0.05	293.77	1,203.0	-0.8	0.6	381,972.99	1,751,227.94	39° 32' 43.389 N	80° 22' 55.831 W
1,246.0	0.24	170.24	1,246.0	-0.9	0.6	381,972.91	1,751,227.93	39° 32' 43.388 N	80° 22' 55.831 W
1,289.0	0.46	86.10	1,289.0	-1.0	0.8	381,972.83	1,751,228.12	39° 32' 43.388 N	80° 22' 55.829 W
1,332.0	0.44	94.32	1,332.0	-1.0	1.1	381,972.83	1,751,228.46	39° 32' 43.388 N	80° 22' 55.825 W
1,376.0	1.15	100.60	1,376.0	-1.1	1.7	381,972.74	1,751,229.06	39° 32' 43.387 N	80° 22' 55.817 W
1,419.0	1.55	102.93	1,419.0	-1.3	2.7	381,972.53	1,751,230.05	39° 32' 43.385 N	80° 22' 55.804 W
1,462.0	2.00	95.52	1,462.0	-1.5	4.0	381,972.33	1,751,231.37	39° 32' 43.383 N	80° 22' 55.787 W

Survey Report - Geographic

<b>Company:</b>	EQT PRODUCTION	<b>Local Co-ordinate Reference:</b>	Well Elliott 10H L-003932 - Slot Elliott 10H SHL
<b>Project:</b>	Marion County, WV	<b>TVD Reference:</b>	KB@28 @ 1371.0usft
<b>Site:</b>	Elliott Pad	<b>MD Reference:</b>	KB@28 @ 1371.0usft
<b>Well:</b>	Elliott 10H L-003932	<b>North Reference:</b>	Grid
<b>Wellbore:</b>	Main	<b>Survey Calculation Method:</b>	Minimum Curvature
<b>Design:</b>	Elliott 10H As Drilled	<b>Database:</b>	EQT

Survey

Measured Depth (usft)	Inclination (°)	Azimuth (°)	Vertical Depth (usft)	+N/-S (usft)	+E/-W (usft)	Map Northing (usft)	Map Easting (usft)	Latitude	Longitude
1,506.0	2.29	99.24	1,505.9	-1.7	5.6	381,972.11	1,751,233.00	39° 32' 43.381 N	80° 22' 55.767 W
1,549.0	2.46	111.95	1,548.9	-2.2	7.3	381,971.63	1,751,234.70	39° 32' 43.376 N	80° 22' 55.745 W
1,592.0	3.04	111.64	1,591.8	-2.9	9.3	381,970.86	1,751,236.62	39° 32' 43.369 N	80° 22' 55.720 W
1,635.0	3.28	120.63	1,634.8	-4.0	11.4	381,969.82	1,751,238.74	39° 32' 43.359 N	80° 22' 55.693 W
1,678.0	2.61	123.48	1,677.7	-5.2	13.2	381,968.65	1,751,240.61	39° 32' 43.348 N	80° 22' 55.669 W
1,721.0	2.15	129.11	1,720.7	-6.2	14.7	381,967.60	1,751,242.05	39° 32' 43.337 N	80° 22' 55.650 W
1,764.0	2.30	135.21	1,763.6	-7.3	15.9	381,966.48	1,751,243.29	39° 32' 43.326 N	80° 22' 55.634 W
1,808.0	1.89	135.63	1,807.6	-8.5	17.1	381,965.33	1,751,244.42	39° 32' 43.315 N	80° 22' 55.620 W
1,851.0	1.53	142.23	1,850.6	-9.4	17.9	381,964.37	1,751,245.26	39° 32' 43.306 N	80° 22' 55.609 W
1,894.0	1.21	133.38	1,893.6	-10.2	18.6	381,963.61	1,751,245.95	39° 32' 43.298 N	80° 22' 55.600 W
1,937.0	1.24	91.09	1,936.6	-10.5	19.4	381,963.29	1,751,246.74	39° 32' 43.295 N	80° 22' 55.590 W
1,981.0	1.59	58.12	1,980.6	-10.2	20.4	381,963.60	1,751,247.74	39° 32' 43.298 N	80° 22' 55.577 W
2,024.0	1.93	53.94	2,023.5	-9.5	21.5	381,964.34	1,751,248.83	39° 32' 43.306 N	80° 22' 55.563 W
2,067.0	2.42	58.37	2,066.5	-8.6	22.8	381,965.24	1,751,250.19	39° 32' 43.315 N	80° 22' 55.546 W
2,110.0	2.95	64.11	2,109.5	-7.6	24.6	381,966.20	1,751,251.95	39° 32' 43.324 N	80° 22' 55.524 W
2,153.0	3.28	72.75	2,152.4	-6.8	26.8	381,967.05	1,751,254.12	39° 32' 43.333 N	80° 22' 55.496 W
2,197.0	3.51	77.25	2,196.3	-6.1	29.3	381,967.72	1,751,256.64	39° 32' 43.340 N	80° 22' 55.464 W
2,240.0	3.40	87.24	2,239.2	-5.7	31.8	381,968.07	1,751,259.20	39° 32' 43.344 N	80° 22' 55.432 W
2,283.0	3.73	101.52	2,282.2	-6.0	34.5	381,967.86	1,751,261.84	39° 32' 43.342 N	80° 22' 55.398 W
2,326.0	3.65	117.72	2,325.1	-6.9	37.1	381,966.94	1,751,264.42	39° 32' 43.333 N	80° 22' 55.365 W
2,370.0	3.28	125.80	2,369.0	-8.3	39.3	381,965.55	1,751,266.68	39° 32' 43.319 N	80° 22' 55.336 W
2,412.0	2.82	140.18	2,410.9	-9.8	41.0	381,964.06	1,751,268.32	39° 32' 43.305 N	80° 22' 55.315 W
2,473.0	2.09	154.10	2,471.9	-11.9	42.4	381,961.90	1,751,269.77	39° 32' 43.284 N	80° 22' 55.296 W
2,559.0	1.77	165.34	2,557.8	-14.6	43.4	381,959.21	1,751,270.79	39° 32' 43.257 N	80° 22' 55.282 W
2,602.0	1.85	154.81	2,600.8	-15.9	43.9	381,957.94	1,751,271.25	39° 32' 43.245 N	80° 22' 55.276 W
2,646.0	1.46	146.71	2,644.8	-17.0	44.5	381,956.83	1,751,271.86	39° 32' 43.234 N	80° 22' 55.268 W
2,689.0	1.86	108.15	2,687.8	-17.7	45.5	381,956.15	1,751,272.83	39° 32' 43.227 N	80° 22' 55.256 W
2,732.0	2.22	110.10	2,730.8	-18.2	46.9	381,955.65	1,751,274.27	39° 32' 43.222 N	80° 22' 55.238 W
2,819.0	1.64	101.24	2,817.7	-19.0	49.7	381,954.82	1,751,277.07	39° 32' 43.214 N	80° 22' 55.202 W
2,905.0	1.23	67.30	2,903.7	-18.9	51.8	381,954.94	1,751,279.13	39° 32' 43.216 N	80° 22' 55.175 W
2,991.0	1.53	93.98	2,989.7	-18.6	53.8	381,955.22	1,751,281.13	39° 32' 43.219 N	80° 22' 55.150 W
3,078.0	1.97	106.83	3,076.6	-19.1	56.4	381,954.70	1,751,283.72	39° 32' 43.214 N	80° 22' 55.117 W
3,164.0	1.60	116.71	3,162.6	-20.1	58.8	381,953.74	1,751,286.21	39° 32' 43.205 N	80° 22' 55.085 W
3,251.0	2.12	95.66	3,249.5	-20.8	61.5	381,953.03	1,751,288.89	39° 32' 43.198 N	80° 22' 55.051 W
3,337.0	2.83	94.30	3,335.4	-21.1	65.2	381,952.72	1,751,292.59	39° 32' 43.195 N	80° 22' 55.003 W
3,424.0	2.53	99.56	3,422.3	-21.6	69.3	381,952.24	1,751,296.63	39° 32' 43.191 N	80° 22' 54.952 W
3,510.0	1.97	102.03	3,508.3	-22.2	72.6	381,951.61	1,751,299.95	39° 32' 43.185 N	80° 22' 54.909 W
3,597.0	2.06	84.97	3,595.2	-22.4	75.6	381,951.44	1,751,302.97	39° 32' 43.184 N	80° 22' 54.871 W
3,683.0	2.50	86.16	3,681.2	-22.1	79.0	381,951.70	1,751,306.38	39° 32' 43.186 N	80° 22' 54.827 W
3,769.0	1.88	92.02	3,767.1	-22.0	82.3	381,951.77	1,751,309.66	39° 32' 43.187 N	80° 22' 54.785 W
3,856.0	2.44	81.90	3,854.0	-21.8	85.6	381,951.99	1,751,312.92	39° 32' 43.190 N	80° 22' 54.744 W
3,942.0	2.86	60.33	3,939.9	-20.5	89.2	381,953.31	1,751,316.60	39° 32' 43.203 N	80° 22' 54.697 W
4,028.0	4.05	53.27	4,025.8	-17.6	93.5	381,956.18	1,751,320.89	39° 32' 43.232 N	80° 22' 54.643 W
4,115.0	4.84	44.02	4,112.5	-13.1	98.5	381,960.66	1,751,325.91	39° 32' 43.277 N	80° 22' 54.579 W
4,202.0	5.42	46.53	4,199.2	-7.7	104.1	381,966.13	1,751,331.44	39° 32' 43.331 N	80° 22' 54.509 W
4,288.0	7.27	46.49	4,284.6	-1.1	111.0	381,972.67	1,751,338.33	39° 32' 43.397 N	80° 22' 54.422 W
4,374.0	8.91	45.63	4,369.8	7.3	119.7	381,981.07	1,751,347.04	39° 32' 43.481 N	80° 22' 54.312 W
4,461.0	9.17	42.70	4,455.7	17.1	129.2	381,990.88	1,751,356.56	39° 32' 43.579 N	80° 22' 54.192 W
4,548.0	9.98	38.51	4,541.5	28.1	138.6	382,001.87	1,751,365.95	39° 32' 43.688 N	80° 22' 54.073 W
4,634.0	10.54	37.92	4,626.1	40.1	148.1	382,013.91	1,751,375.43	39° 32' 43.808 N	80° 22' 53.954 W
4,721.0	9.87	35.74	4,711.7	52.4	157.3	382,026.24	1,751,384.67	39° 32' 43.931 N	80° 22' 53.837 W
4,807.0	10.30	35.44	4,796.4	64.7	166.1	382,038.48	1,751,393.44	39° 32' 44.053 N	80° 22' 53.727 W
4,893.0	10.32	35.90	4,881.0	77.2	175.0	382,050.99	1,751,402.41	39° 32' 44.177 N	80° 22' 53.614 W
4,980.0	10.00	35.58	4,966.7	89.6	184.0	382,063.44	1,751,411.38	39° 32' 44.301 N	80° 22' 53.501 W
5,066.0	9.50	33.88	5,051.4	101.6	192.3	382,075.41	1,751,419.68	39° 32' 44.420 N	80° 22' 53.396 W

Survey Report - Geographic

<b>Company:</b>	EQT PRODUCTION	<b>Local Co-ordinate Reference:</b>	Well Elliott 10H L-003932 - Slot Elliott 10H SHL
<b>Project:</b>	Marion County, WV	<b>TVD Reference:</b>	KB@28 @ 1371.0usft
<b>Site:</b>	Elliott Pad	<b>MD Reference:</b>	KB@28 @ 1371.0usft
<b>Well:</b>	Elliott 10H L-003932	<b>North Reference:</b>	Grid
<b>Wellbore:</b>	Main	<b>Survey Calculation Method:</b>	Minimum Curvature
<b>Design:</b>	Elliott 10H As Drilled	<b>Database:</b>	EQT

Survey

Measured Depth (usft)	Inclination (°)	Azimuth (°)	Vertical Depth (usft)	+N/-S (usft)	+E/-W (usft)	Map Northing (usft)	Map Easting (usft)	Latitude	Longitude
5,143.0	10.13	32.53	5,127.3	112.6	199.5	382,086.39	1,751,426.86	39° 32' 44.529 N	80° 22' 53.306 W
5,230.0	10.33	32.62	5,212.9	125.6	207.8	382,099.41	1,751,435.18	39° 32' 44.659 N	80° 22' 53.202 W
5,316.0	10.73	34.09	5,297.5	138.7	216.5	382,112.54	1,751,443.83	39° 32' 44.789 N	80° 22' 53.093 W
5,403.0	10.31	35.47	5,383.0	151.8	225.5	382,125.59	1,751,452.88	39° 32' 44.919 N	80° 22' 52.979 W
5,490.0	11.38	36.74	5,468.4	165.0	235.2	382,138.81	1,751,462.53	39° 32' 45.051 N	80° 22' 52.857 W
5,576.0	11.22	40.27	5,552.8	178.2	245.7	382,151.99	1,751,473.02	39° 32' 45.182 N	80° 22' 52.725 W
5,662.0	10.80	44.11	5,637.2	190.3	256.7	382,164.16	1,751,484.04	39° 32' 45.303 N	80° 22' 52.586 W
5,749.0	10.92	41.46	5,722.6	202.4	267.8	382,176.19	1,751,495.16	39° 32' 45.423 N	80° 22' 52.445 W
5,835.0	10.92	40.23	5,807.1	214.7	278.5	382,188.51	1,751,505.82	39° 32' 45.546 N	80° 22' 52.311 W
5,921.0	10.83	41.09	5,891.5	227.0	289.0	382,200.82	1,751,516.39	39° 32' 45.669 N	80° 22' 52.178 W
6,008.0	10.39	40.24	5,977.1	239.2	299.5	382,212.97	1,751,526.83	39° 32' 45.790 N	80° 22' 52.046 W
6,094.0	10.97	38.39	6,061.6	251.5	309.6	382,225.30	1,751,536.92	39° 32' 45.913 N	80° 22' 51.919 W
6,180.0	10.79	38.23	6,146.0	264.2	319.6	382,238.04	1,751,546.98	39° 32' 46.040 N	80° 22' 51.792 W
6,267.0	10.58	36.54	6,231.5	277.0	329.4	382,250.85	1,751,556.78	39° 32' 46.167 N	80° 22' 51.668 W
6,353.0	10.55	38.77	6,316.0	289.5	339.0	382,263.33	1,751,566.41	39° 32' 46.292 N	80° 22' 51.547 W
6,440.0	10.56	37.24	6,401.6	302.1	348.9	382,275.89	1,751,576.22	39° 32' 46.417 N	80° 22' 51.423 W
6,526.0	10.49	36.90	6,486.1	314.6	358.3	382,288.43	1,751,585.69	39° 32' 46.542 N	80° 22' 51.304 W
6,613.0	10.44	35.68	6,571.7	327.4	367.7	382,301.16	1,751,595.04	39° 32' 46.668 N	80° 22' 51.186 W
6,699.0	10.51	35.94	6,656.2	340.0	376.8	382,313.84	1,751,604.19	39° 32' 46.794 N	80° 22' 51.071 W
6,785.0	8.90	39.22	6,741.0	351.5	385.6	382,325.35	1,751,613.00	39° 32' 46.909 N	80° 22' 50.960 W
6,872.0	7.74	44.62	6,827.1	360.9	394.0	382,334.73	1,751,621.37	39° 32' 47.003 N	80° 22' 50.854 W
6,958.0	8.33	41.71	6,912.3	369.7	402.2	382,343.50	1,751,629.59	39° 32' 47.090 N	80° 22' 50.750 W
7,045.0	9.15	42.33	6,998.2	379.5	411.1	382,353.32	1,751,638.44	39° 32' 47.188 N	80° 22' 50.639 W
7,132.0	9.61	43.52	7,084.1	389.9	420.7	382,363.70	1,751,648.10	39° 32' 47.292 N	80° 22' 50.517 W
7,147.0	10.17	41.90	7,098.9	391.8	422.5	382,365.59	1,751,649.84	39° 32' 47.310 N	80° 22' 50.495 W
7,241.0	10.47	65.46	7,191.4	401.5	435.8	382,375.32	1,751,663.16	39° 32' 47.408 N	80° 22' 50.326 W
7,336.0	10.23	112.69	7,285.0	401.8	451.5	382,375.65	1,751,678.82	39° 32' 47.413 N	80° 22' 50.126 W
7,430.0	16.80	130.67	7,376.4	389.8	469.5	382,363.56	1,751,696.85	39° 32' 47.295 N	80° 22' 49.894 W
7,524.0	24.55	135.18	7,464.3	367.0	493.6	382,340.82	1,751,720.96	39° 32' 47.072 N	80° 22' 49.584 W
7,619.0	31.95	139.00	7,547.9	334.0	524.0	382,307.80	1,751,751.41	39° 32' 46.749 N	80° 22' 49.191 W
7,714.0	41.56	143.24	7,623.9	289.7	559.5	382,263.48	1,751,786.85	39° 32' 46.314 N	80° 22' 48.733 W
7,808.0	50.35	145.90	7,689.2	234.6	598.5	382,208.42	1,751,825.88	39° 32' 45.774 N	80° 22' 48.228 W
7,903.0	61.53	148.34	7,742.4	168.6	641.1	382,142.38	1,751,868.44	39° 32' 45.125 N	80° 22' 47.676 W
7,997.0	66.94	150.27	7,783.2	95.8	684.2	382,069.60	1,751,911.60	39° 32' 44.410 N	80° 22' 47.116 W
8,092.0	75.08	153.13	7,814.1	16.7	726.7	381,990.55	1,751,954.10	39° 32' 43.633 N	80° 22' 46.564 W
8,186.0	83.66	154.81	7,831.4	-66.2	767.2	381,907.61	1,751,994.59	39° 32' 42.817 N	80° 22' 46.037 W
8,280.0	90.79	156.19	7,836.0	-151.6	806.1	381,822.23	1,752,033.49	39° 32' 41.977 N	80° 22' 45.529 W
8,376.0	90.55	155.97	7,834.8	-239.3	845.1	381,734.48	1,752,072.41	39° 32' 41.114 N	80° 22' 45.021 W
8,470.0	90.62	155.05	7,833.9	-324.9	884.0	381,648.94	1,752,111.38	39° 32' 40.272 N	80° 22' 44.513 W
8,565.0	90.79	156.21	7,832.7	-411.4	923.2	381,562.42	1,752,150.57	39° 32' 39.421 N	80° 22' 44.002 W
8,659.0	90.35	155.54	7,831.8	-497.2	961.6	381,476.63	1,752,188.99	39° 32' 38.577 N	80° 22' 43.501 W
8,754.0	90.55	155.30	7,831.0	-583.6	1,001.1	381,390.24	1,752,228.51	39° 32' 37.727 N	80° 22' 42.986 W
8,848.0	89.08	152.71	7,831.3	-668.0	1,042.3	381,305.76	1,752,269.70	39° 32' 36.896 N	80° 22' 42.450 W
8,942.0	90.69	155.91	7,831.5	-752.7	1,083.1	381,221.07	1,752,310.44	39° 32' 36.063 N	80° 22' 41.919 W
9,038.0	90.45	155.23	7,830.6	-840.1	1,122.8	381,133.67	1,752,350.15	39° 32' 35.203 N	80° 22' 41.401 W
9,132.0	90.25	156.37	7,830.0	-925.9	1,161.3	381,047.93	1,752,388.68	39° 32' 34.359 N	80° 22' 40.899 W
9,227.0	92.10	158.21	7,828.1	-1,013.5	1,198.0	380,960.32	1,752,425.34	39° 32' 33.497 N	80° 22' 40.420 W
9,321.0	89.68	155.35	7,826.6	-1,099.8	1,235.0	380,873.96	1,752,462.39	39° 32' 32.647 N	80° 22' 39.936 W
9,415.0	90.38	153.43	7,826.5	-1,184.6	1,275.7	380,789.20	1,752,503.02	39° 32' 31.813 N	80° 22' 39.407 W
9,509.0	90.69	155.41	7,825.7	-1,269.4	1,316.2	380,704.43	1,752,543.61	39° 32' 30.979 N	80° 22' 38.878 W
9,604.0	91.05	155.95	7,824.2	-1,355.9	1,355.4	380,617.87	1,752,582.72	39° 32' 30.127 N	80° 22' 38.368 W
9,699.0	89.91	154.91	7,823.4	-1,442.3	1,394.9	380,531.47	1,752,622.22	39° 32' 29.277 N	80° 22' 37.853 W
9,793.0	91.39	156.93	7,822.4	-1,528.1	1,433.2	380,445.67	1,752,660.57	39° 32' 28.433 N	80° 22' 37.353 W
9,887.0	89.11	153.09	7,822.0	-1,613.3	1,472.9	380,360.49	1,752,700.27	39° 32' 27.595 N	80° 22' 36.836 W
9,981.0	91.32	156.15	7,821.6	-1,698.2	1,513.2	380,275.58	1,752,740.56	39° 32' 26.759 N	80° 22' 36.311 W

Survey Report - Geographic

<b>Company:</b>	EQT PRODUCTION	<b>Local Co-ordinate Reference:</b>	Well Elliott 10H L-003932 - Slot Elliott 10H SHL
<b>Project:</b>	Marion County, WV	<b>TVD Reference:</b>	KB@28 @ 1371.0usft
<b>Site:</b>	Elliott Pad	<b>MD Reference:</b>	KB@28 @ 1371.0usft
<b>Well:</b>	Elliott 10H L-003932	<b>North Reference:</b>	Grid
<b>Wellbore:</b>	Main	<b>Survey Calculation Method:</b>	Minimum Curvature
<b>Design:</b>	Elliott 10H As Drilled	<b>Database:</b>	EQT

Survey

Measured Depth (usft)	Inclination (°)	Azimuth (°)	Vertical Depth (usft)	+N/-S (usft)	+E/-W (usft)	Map Northing (usft)	Map Easting (usft)	Latitude	Longitude
10,076.0	91.39	157.79	7,819.4	-1,785.6	1,550.3	380,188.18	1,752,777.71	39° 32' 25.899 N	80° 22' 35.826 W
10,170.0	89.88	154.63	7,818.3	-1,871.6	1,588.3	380,102.18	1,752,815.62	39° 32' 25.053 N	80° 22' 35.331 W
10,265.0	91.12	157.69	7,817.5	-1,958.5	1,626.6	380,015.30	1,752,854.01	39° 32' 24.198 N	80° 22' 34.830 W
10,360.0	88.07	152.72	7,818.2	-2,044.7	1,666.5	379,929.10	1,752,893.83	39° 32' 23.350 N	80° 22' 34.311 W
10,454.0	90.42	154.46	7,819.4	-2,128.9	1,708.3	379,844.93	1,752,935.63	39° 32' 22.522 N	80° 22' 33.767 W
10,549.0	90.95	154.33	7,818.3	-2,214.5	1,749.3	379,759.26	1,752,976.69	39° 32' 21.679 N	80° 22' 33.233 W
10,644.0	92.67	154.83	7,815.3	-2,300.3	1,790.1	379,673.51	1,753,017.44	39° 32' 20.836 N	80° 22' 32.702 W
10,738.0	92.74	155.54	7,810.8	-2,385.5	1,829.5	379,588.28	1,753,056.85	39° 32' 19.997 N	80° 22' 32.188 W
10,832.0	92.40	154.43	7,806.6	-2,470.6	1,869.2	379,503.19	1,753,096.56	39° 32' 19.160 N	80° 22' 31.671 W
10,927.0	91.06	154.21	7,803.7	-2,556.2	1,910.3	379,417.61	1,753,137.71	39° 32' 18.318 N	80° 22' 31.135 W
11,021.0	91.66	155.53	7,801.5	-2,641.3	1,950.2	379,332.53	1,753,177.61	39° 32' 17.481 N	80° 22' 30.615 W
11,115.0	91.69	155.71	7,798.8	-2,726.9	1,989.0	379,246.95	1,753,216.40	39° 32' 16.639 N	80° 22' 30.109 W
11,210.0	91.29	154.40	7,796.3	-2,813.0	2,029.1	379,160.85	1,753,256.45	39° 32' 15.792 N	80° 22' 29.587 W
11,304.0	91.22	154.09	7,794.2	-2,897.6	2,069.9	379,076.21	1,753,297.29	39° 32' 14.959 N	80° 22' 29.055 W
11,399.0	90.85	153.66	7,792.5	-2,982.9	2,111.7	378,990.92	1,753,339.11	39° 32' 14.120 N	80° 22' 28.511 W
11,492.0	90.65	154.69	7,791.3	-3,066.6	2,152.3	378,907.22	1,753,379.62	39° 32' 13.297 N	80° 22' 27.984 W
11,587.0	91.39	154.50	7,789.6	-3,152.4	2,193.0	378,821.42	1,753,420.37	39° 32' 12.453 N	80° 22' 27.453 W
11,681.0	90.92	154.09	7,787.7	-3,237.1	2,233.8	378,736.74	1,753,461.13	39° 32' 11.620 N	80° 22' 26.922 W
11,775.0	90.38	153.75	7,786.6	-3,321.5	2,275.1	378,652.32	1,753,502.45	39° 32' 10.789 N	80° 22' 26.384 W
11,870.0	91.56	155.26	7,785.0	-3,407.2	2,316.0	378,566.59	1,753,543.34	39° 32' 9.946 N	80° 22' 25.852 W
11,965.0	91.83	154.27	7,782.2	-3,493.1	2,356.5	378,480.69	1,753,583.82	39° 32' 9.101 N	80° 22' 25.324 W
12,059.0	89.68	154.80	7,781.0	-3,578.0	2,396.9	378,395.84	1,753,624.23	39° 32' 8.266 N	80° 22' 24.798 W
12,154.0	90.95	155.27	7,780.5	-3,664.1	2,437.0	378,309.72	1,753,664.32	39° 32' 7.419 N	80° 22' 24.276 W
12,248.0	91.36	155.00	7,778.6	-3,749.4	2,476.5	378,224.45	1,753,703.84	39° 32' 6.580 N	80° 22' 23.761 W
12,342.0	90.85	153.08	7,776.8	-3,833.9	2,517.6	378,139.95	1,753,744.98	39° 32' 5.749 N	80° 22' 23.225 W
12,437.0	91.96	155.48	7,774.4	-3,919.4	2,558.8	378,054.40	1,753,786.19	39° 32' 4.907 N	80° 22' 22.688 W
12,531.0	91.79	155.22	7,771.3	-4,004.8	2,598.0	377,969.01	1,753,825.38	39° 32' 4.067 N	80° 22' 22.178 W
12,626.0	91.89	154.59	7,768.3	-4,090.8	2,638.3	377,883.02	1,753,865.65	39° 32' 3.221 N	80° 22' 21.653 W
12,720.0	91.39	153.51	7,765.6	-4,175.3	2,679.4	377,798.53	1,753,906.76	39° 32' 2.390 N	80° 22' 21.118 W
12,814.0	89.75	154.00	7,764.7	-4,259.6	2,721.0	377,714.23	1,753,948.33	39° 32' 1.561 N	80° 22' 20.577 W
12,910.0	90.25	154.41	7,764.7	-4,346.0	2,762.7	377,627.80	1,753,990.10	39° 32' 0.710 N	80° 22' 20.033 W
13,004.0	91.12	153.47	7,763.5	-4,430.4	2,804.0	377,543.36	1,754,031.39	39° 31' 59.880 N	80° 22' 19.496 W
13,098.0	91.63	155.85	7,761.3	-4,515.4	2,844.2	377,458.44	1,754,071.61	39° 31' 59.044 N	80° 22' 18.972 W
13,193.0	91.36	156.48	7,758.8	-4,602.2	2,882.6	377,371.57	1,754,109.99	39° 31' 58.190 N	80° 22' 18.471 W
13,287.0	91.63	157.16	7,756.4	-4,688.6	2,919.6	377,285.19	1,754,146.97	39° 31' 57.339 N	80° 22' 17.988 W
13,382.0	90.35	154.03	7,754.7	-4,775.1	2,958.8	377,198.70	1,754,186.21	39° 31' 56.488 N	80° 22' 17.477 W
13,477.0	89.85	152.60	7,754.6	-4,860.0	3,001.5	377,113.82	1,754,228.88	39° 31' 55.654 N	80° 22' 16.922 W
13,571.0	90.48	156.97	7,754.3	-4,945.0	3,041.5	377,028.80	1,754,268.91	39° 31' 54.817 N	80° 22' 16.400 W
13,665.0	92.16	154.20	7,752.1	-5,030.6	3,080.4	376,943.24	1,754,307.75	39° 31' 53.975 N	80° 22' 15.894 W
13,760.0	91.22	154.61	7,749.3	-5,116.2	3,121.4	376,857.60	1,754,348.77	39° 31' 53.133 N	80° 22' 15.360 W
13,854.0	90.08	152.78	7,748.3	-5,200.5	3,163.1	376,773.35	1,754,390.42	39° 31' 52.304 N	80° 22' 14.818 W
13,949.0	90.05	154.99	7,748.1	-5,285.8	3,204.9	376,688.05	1,754,432.24	39° 31' 51.465 N	80° 22' 14.274 W
14,043.0	89.88	154.96	7,748.2	-5,370.9	3,244.6	376,602.88	1,754,472.00	39° 31' 50.627 N	80° 22' 13.756 W
14,138.0	89.75	153.56	7,748.5	-5,456.5	3,285.9	376,517.30	1,754,513.26	39° 31' 49.785 N	80° 22' 13.219 W
14,232.0	90.89	155.36	7,748.0	-5,541.3	3,326.4	376,432.50	1,754,553.78	39° 31' 48.951 N	80° 22' 12.691 W
14,327.0	88.77	154.58	7,748.3	-5,627.4	3,366.6	376,346.42	1,754,593.97	39° 31' 48.104 N	80° 22' 12.167 W
14,422.0	88.10	154.62	7,750.9	-5,713.2	3,407.3	376,260.64	1,754,634.70	39° 31' 47.260 N	80° 22' 11.637 W
14,516.0	87.30	155.20	7,754.6	-5,798.2	3,447.2	376,175.58	1,754,674.53	39° 31' 46.423 N	80° 22' 11.118 W
14,610.0	89.11	154.13	7,757.6	-5,883.1	3,487.4	376,090.67	1,754,714.73	39° 31' 45.588 N	80° 22' 10.595 W
14,705.0	88.94	155.31	7,759.2	-5,969.0	3,527.9	376,004.78	1,754,755.30	39° 31' 44.743 N	80° 22' 10.066 W
14,800.0	87.09	155.02	7,762.5	-6,055.2	3,567.8	375,918.62	1,754,795.17	39° 31' 43.895 N	80° 22' 9.547 W
14,894.0	89.01	154.90	7,765.7	-6,140.3	3,607.6	375,833.51	1,754,834.93	39° 31' 43.058 N	80° 22' 9.029 W
14,989.0	89.88	156.58	7,766.6	-6,226.9	3,646.6	375,746.90	1,754,873.96	39° 31' 42.205 N	80° 22' 8.520 W
15,083.0	88.10	155.36	7,768.3	-6,312.7	3,684.9	375,661.07	1,754,912.23	39° 31' 41.361 N	80° 22' 8.021 W
15,177.0	88.00	156.17	7,771.5	-6,398.4	3,723.4	375,575.40	1,754,950.79	39° 31' 40.518 N	80° 22' 7.518 W

### Survey Report - Geographic

<b>Company:</b>	EQT PRODUCTION	<b>Local Co-ordinate Reference:</b>	Well Elliott 10H L-003932 - Slot Elliott 10H SHL
<b>Project:</b>	Marion County, WV	<b>TVD Reference:</b>	KB@28 @ 1371.0usft
<b>Site:</b>	Elliott Pad	<b>MD Reference:</b>	KB@28 @ 1371.0usft
<b>Well:</b>	Elliott 10H L-003932	<b>North Reference:</b>	Grid
<b>Wellbore:</b>	Main	<b>Survey Calculation Method:</b>	Minimum Curvature
<b>Design:</b>	Elliott 10H As Drilled	<b>Database:</b>	EQT

#### Survey

Measured Depth (usft)	Inclination (°)	Azimuth (°)	Vertical Depth (usft)	+N/-S (usft)	+E/-W (usft)	Map Northing (usft)	Map Easting (usft)	Latitude	Longitude
15,271.0	87.09	156.15	7,775.5	-6,484.3	3,761.4	375,489.50	1,754,988.75	39° 31' 39.672 N	80° 22' 7.023 W
15,365.0	88.17	155.34	7,779.4	-6,569.9	3,800.0	375,403.88	1,755,027.33	39° 31' 38.830 N	80° 22' 6.520 W
15,460.0	88.17	156.03	7,782.4	-6,656.5	3,839.1	375,317.35	1,755,066.43	39° 31' 37.978 N	80° 22' 6.011 W
15,554.0	87.46	156.52	7,786.0	-6,742.5	3,876.9	375,231.36	1,755,104.22	39° 31' 37.132 N	80° 22' 5.518 W
15,648.0	87.66	156.17	7,790.0	-6,828.5	3,914.5	375,145.33	1,755,141.90	39° 31' 36.285 N	80° 22' 5.026 W
15,743.0	87.12	154.13	7,794.3	-6,914.6	3,954.4	375,059.22	1,755,181.78	39° 31' 35.438 N	80° 22' 4.507 W
15,838.0	87.06	156.63	7,799.1	-7,000.8	3,993.9	374,972.98	1,755,221.31	39° 31' 34.590 N	80° 22' 3.992 W
15,932.0	87.93	156.19	7,803.2	-7,086.9	4,031.5	374,886.92	1,755,258.89	39° 31' 33.743 N	80° 22' 3.502 W
16,026.0	87.23	153.82	7,807.2	-7,172.0	4,071.2	374,801.80	1,755,298.57	39° 31' 32.905 N	80° 22' 2.985 W
16,121.0	87.46	155.20	7,811.6	-7,257.7	4,112.0	374,716.14	1,755,339.41	39° 31' 32.062 N	80° 22' 2.453 W
16,216.0	86.79	154.61	7,816.4	-7,343.6	4,152.3	374,630.22	1,755,379.65	39° 31' 31.217 N	80° 22' 1.929 W
16,310.0	87.66	153.45	7,820.9	-7,428.0	4,193.4	374,545.81	1,755,420.76	39° 31' 30.387 N	80° 22' 1.394 W
16,404.0	88.00	154.18	7,824.5	-7,512.3	4,234.8	374,461.52	1,755,462.21	39° 31' 29.558 N	80° 22' 0.854 W
16,499.0	89.14	155.12	7,826.9	-7,598.1	4,275.5	374,375.70	1,755,502.87	39° 31' 28.713 N	80° 22' 0.325 W
16,594.0	88.94	154.80	7,828.5	-7,684.2	4,315.7	374,289.64	1,755,543.07	39° 31' 27.867 N	80° 21' 59.801 W
16,688.0	89.61	155.06	7,829.6	-7,769.3	4,355.5	374,204.50	1,755,582.90	39° 31' 27.029 N	80° 21' 59.283 W
16,783.0	89.41	154.57	7,830.5	-7,855.3	4,396.0	374,118.54	1,755,623.32	39° 31' 26.183 N	80° 21' 58.756 W
16,878.0	90.08	155.15	7,830.9	-7,941.3	4,436.3	374,032.54	1,755,663.68	39° 31' 25.337 N	80° 21' 58.231 W
16,973.0	88.87	155.47	7,831.8	-8,027.6	4,476.0	373,946.23	1,755,703.36	39° 31' 24.488 N	80° 21' 57.714 W
17,067.0	89.14	154.91	7,833.4	-8,112.9	4,515.4	373,860.92	1,755,742.80	39° 31' 23.648 N	80° 21' 57.200 W
17,162.0	89.64	155.70	7,834.4	-8,199.2	4,555.1	373,774.61	1,755,782.49	39° 31' 22.799 N	80° 21' 56.683 W
17,256.0	89.94	155.15	7,834.7	-8,284.7	4,594.2	373,689.13	1,755,821.58	39° 31' 21.958 N	80° 21' 56.173 W
17,351.0	90.25	155.27	7,834.6	-8,370.9	4,634.0	373,602.88	1,755,861.41	39° 31' 21.109 N	80° 21' 55.655 W
17,446.0	90.38	155.01	7,834.1	-8,457.1	4,674.0	373,516.69	1,755,901.35	39° 31' 20.261 N	80° 21' 55.134 W
17,540.0	91.12	156.42	7,832.8	-8,542.8	4,712.6	373,431.01	1,755,940.00	39° 31' 19.418 N	80° 21' 54.630 W
17,635.0	89.94	154.00	7,832.0	-8,629.0	4,752.5	373,344.78	1,755,979.83	39° 31' 18.570 N	80° 21' 54.112 W
17,730.0	90.25	154.99	7,831.8	-8,714.8	4,793.4	373,259.04	1,756,020.74	39° 31' 17.726 N	80° 21' 53.579 W
17,824.0	90.45	155.07	7,831.2	-8,800.0	4,833.1	373,173.83	1,756,060.42	39° 31' 16.888 N	80° 21' 53.062 W
17,918.0	90.68	155.42	7,830.3	-8,885.3	4,872.4	373,088.47	1,756,099.78	39° 31' 16.048 N	80° 21' 52.550 W
18,014.0	90.72	154.65	7,829.1	-8,972.4	4,912.9	373,001.45	1,756,140.29	39° 31' 15.192 N	80° 21' 52.022 W
18,108.0	90.68	154.51	7,828.0	-9,057.3	4,953.3	372,916.55	1,756,180.64	39° 31' 14.356 N	80° 21' 51.497 W
18,203.0	90.41	154.86	7,827.1	-9,143.1	4,993.9	372,830.68	1,756,221.26	39° 31' 13.512 N	80° 21' 50.968 W
18,297.0	91.29	155.19	7,825.7	-9,228.3	5,033.6	372,745.48	1,756,260.94	39° 31' 12.673 N	80° 21' 50.451 W
18,392.0	91.05	155.20	7,823.7	-9,314.5	5,073.4	372,659.26	1,756,300.79	39° 31' 11.825 N	80° 21' 49.932 W
18,486.0	90.85	155.23	7,822.2	-9,399.9	5,112.8	372,573.93	1,756,340.19	39° 31' 10.985 N	80° 21' 49.419 W
18,582.0	90.82	155.11	7,820.8	-9,487.0	5,153.1	372,486.82	1,756,380.50	39° 31' 10.128 N	80° 21' 48.894 W
18,677.0	91.32	155.29	7,819.0	-9,573.2	5,193.0	372,400.59	1,756,420.34	39° 31' 9.280 N	80° 21' 48.375 W
18,772.0	91.45	154.66	7,816.7	-9,659.3	5,233.2	372,314.54	1,756,460.51	39° 31' 8.433 N	80° 21' 47.851 W
18,866.0	91.49	154.70	7,814.3	-9,744.2	5,273.3	372,229.59	1,756,500.70	39° 31' 7.597 N	80° 21' 47.328 W
18,961.0	91.62	157.27	7,811.7	-9,831.0	5,312.0	372,142.86	1,756,539.35	39° 31' 6.744 N	80° 21' 46.824 W
19,055.0	91.86	158.89	7,808.9	-9,918.1	5,347.1	372,055.70	1,756,574.42	39° 31' 5.886 N	80° 21' 46.366 W
19,150.0	92.33	162.18	7,805.4	-10,007.6	5,378.7	371,966.20	1,756,606.05	39° 31' 5.004 N	80° 21' 45.952 W
19,245.0	91.99	164.53	7,801.8	-10,098.6	5,405.9	371,875.25	1,756,633.24	39° 31' 4.108 N	80° 21' 45.593 W
19,341.0	92.26	164.67	7,798.2	-10,191.0	5,431.4	371,782.76	1,756,658.72	39° 31' 3.196 N	80° 21' 45.257 W
19,436.0	91.72	164.16	7,794.9	-10,282.5	5,456.9	371,691.31	1,756,684.23	39° 31' 2.295 N	80° 21' 44.920 W
19,530.0	91.35	159.66	7,792.4	-10,371.8	5,486.0	371,602.01	1,756,713.40	39° 31' 1.415 N	80° 21' 44.537 W
19,625.0	91.42	156.55	7,790.1	-10,459.9	5,521.4	371,513.90	1,756,748.81	39° 31' 0.547 N	80° 21' 44.075 W
19,719.0	90.75	154.74	7,788.4	-10,545.5	5,560.2	371,428.29	1,756,787.57	39° 30' 59.705 N	80° 21' 43.570 W
19,814.0	90.68	151.93	7,787.2	-10,630.4	5,602.8	371,343.40	1,756,830.19	39° 30' 58.870 N	80° 21' 43.015 W
19,909.0	91.59	151.85	7,785.3	-10,714.2	5,647.6	371,259.63	1,756,874.94	39° 30' 58.046 N	80° 21' 42.434 W
20,004.0	92.36	152.48	7,782.0	-10,798.1	5,691.9	371,175.67	1,756,919.27	39° 30' 57.221 N	80° 21' 41.858 W
20,099.0	91.86	151.19	7,778.5	-10,881.8	5,736.7	371,091.98	1,756,964.08	39° 30' 56.398 N	80° 21' 41.276 W
20,194.0	91.86	150.57	7,775.4	-10,964.8	5,782.9	371,009.03	1,757,010.29	39° 30' 55.582 N	80° 21' 40.676 W
20,288.0	91.42	150.15	7,772.7	-11,046.4	5,829.4	370,927.36	1,757,056.76	39° 30' 54.779 N	80° 21' 40.073 W
20,382.0	91.96	148.77	7,770.0	-11,127.4	5,877.1	370,846.44	1,757,104.50	39° 30' 53.984 N	80° 21' 39.454 W

Survey Report - Geographic

<b>Company:</b>	EQT PRODUCTION	<b>Local Co-ordinate Reference:</b>	Well Elliott 10H L-003932 - Slot Elliott 10H SHL
<b>Project:</b>	Marion County, WV	<b>TVD Reference:</b>	KB@28 @ 1371.0usft
<b>Site:</b>	Elliott Pad	<b>MD Reference:</b>	KB@28 @ 1371.0usft
<b>Well:</b>	Elliott 10H L-003932	<b>North Reference:</b>	Grid
<b>Wellbore:</b>	Main	<b>Survey Calculation Method:</b>	Minimum Curvature
<b>Design:</b>	Elliott 10H As Drilled	<b>Database:</b>	EQT

Survey									
Measured Depth (usft)	Inclination (°)	Azimuth (°)	Vertical Depth (usft)	+N/-S (usft)	+E/-W (usft)	Map Northing (usft)	Map Easting (usft)	Latitude	Longitude
20,478.0	91.89	148.89	7,766.7	-11,209.5	5,926.8	370,764.35	1,757,154.16	39° 30' 53.178 N	80° 21' 38.811 W
20,572.0	92.13	148.18	7,763.4	-11,289.6	5,975.8	370,684.22	1,757,203.20	39° 30' 52.390 N	80° 21' 38.175 W
20,666.0	92.02	146.66	7,760.0	-11,368.7	6,026.4	370,605.06	1,757,253.78	39° 30' 51.613 N	80° 21' 37.520 W
20,760.0	92.13	150.04	7,756.6	-11,448.7	6,075.7	370,525.11	1,757,303.06	39° 30' 50.827 N	80° 21' 36.881 W
20,855.0	92.90	152.66	7,752.5	-11,532.0	6,121.2	370,441.83	1,757,348.56	39° 30' 50.008 N	80° 21' 36.291 W
20,949.0	92.70	153.43	7,747.9	-11,615.7	6,163.8	370,358.14	1,757,391.12	39° 30' 49.185 N	80° 21' 35.737 W
21,044.0	93.64	154.27	7,742.6	-11,700.8	6,205.6	370,273.00	1,757,432.93	39° 30' 48.348 N	80° 21' 35.194 W
21,139.0	92.56	156.04	7,737.5	-11,786.9	6,245.4	370,186.92	1,757,472.78	39° 30' 47.501 N	80° 21' 34.675 W
21,233.0	92.30	155.69	7,733.5	-11,872.6	6,283.8	370,101.22	1,757,511.18	39° 30' 46.657 N	80° 21' 34.174 W
21,328.0	92.36	154.75	7,729.6	-11,958.8	6,323.6	370,015.03	1,757,550.97	39° 30' 45.809 N	80° 21' 33.656 W
21,422.0	91.15	153.86	7,726.8	-12,043.4	6,364.3	369,930.37	1,757,591.70	39° 30' 44.976 N	80° 21' 33.126 W
21,517.0	90.31	154.13	7,725.5	-12,128.8	6,406.0	369,845.00	1,757,633.35	39° 30' 44.137 N	80° 21' 32.584 W
21,612.0	91.62	155.79	7,723.9	-12,214.9	6,446.2	369,758.94	1,757,673.55	39° 30' 43.290 N	80° 21' 32.061 W
21,707.0	91.59	156.02	7,721.3	-12,301.6	6,485.0	369,672.26	1,757,712.32	39° 30' 42.437 N	80° 21' 31.555 W
21,802.0	91.72	154.63	7,718.5	-12,387.8	6,524.6	369,585.97	1,757,751.96	39° 30' 41.588 N	80° 21' 31.039 W
21,896.0	91.69	156.19	7,715.7	-12,473.3	6,563.7	369,500.53	1,757,791.06	39° 30' 40.747 N	80° 21' 30.530 W
21,991.0	91.62	155.17	7,713.0	-12,559.8	6,602.8	369,414.00	1,757,830.17	39° 30' 39.895 N	80° 21' 30.020 W
22,086.0	91.35	155.48	7,710.5	-12,646.1	6,642.4	369,327.70	1,757,869.81	39° 30' 39.046 N	80° 21' 29.504 W
22,181.0	91.42	155.35	7,708.2	-12,732.5	6,682.0	369,241.34	1,757,909.33	39° 30' 38.196 N	80° 21' 28.989 W
22,276.0	91.66	155.88	7,705.7	-12,819.0	6,721.2	369,154.85	1,757,948.53	39° 30' 37.345 N	80° 21' 28.479 W
22,370.0	91.52	155.71	7,703.1	-12,904.7	6,759.7	369,069.15	1,757,987.06	39° 30' 36.502 N	80° 21' 27.977 W
22,464.0	91.49	155.77	7,700.6	-12,990.3	6,798.3	368,983.48	1,758,025.67	39° 30' 35.659 N	80° 21' 27.474 W
22,559.0	91.35	155.75	7,698.3	-13,076.9	6,837.3	368,896.88	1,758,064.66	39° 30' 34.807 N	80° 21' 26.966 W
22,654.0	91.79	156.28	7,695.7	-13,163.7	6,875.9	368,810.11	1,758,103.26	39° 30' 33.953 N	80° 21' 26.462 W
22,750.0	90.41	154.95	7,693.8	-13,251.1	6,915.5	368,722.70	1,758,142.89	39° 30' 33.092 N	80° 21' 25.946 W
22,846.0	90.82	155.09	7,692.8	-13,338.1	6,956.1	368,635.68	1,758,183.43	39° 30' 32.236 N	80° 21' 25.418 W
22,941.0	90.82	154.83	7,691.4	-13,424.2	6,996.3	368,549.62	1,758,223.63	39° 30' 31.389 N	80° 21' 24.895 W
23,037.0	90.88	154.90	7,690.0	-13,511.1	7,037.0	368,462.72	1,758,264.40	39° 30' 30.534 N	80° 21' 24.364 W
23,133.0	90.65	154.95	7,688.7	-13,598.0	7,077.7	368,375.78	1,758,305.09	39° 30' 29.679 N	80° 21' 23.835 W
23,228.0	90.78	154.93	7,687.5	-13,684.1	7,118.0	368,289.73	1,758,345.32	39° 30' 28.832 N	80° 21' 23.311 W
23,324.0	90.65	154.84	7,686.3	-13,771.0	7,158.7	368,202.81	1,758,386.06	39° 30' 27.977 N	80° 21' 22.780 W
23,419.0	90.38	155.23	7,685.5	-13,857.1	7,198.8	368,116.69	1,758,426.16	39° 30' 27.130 N	80° 21' 22.258 W
23,515.0	90.51	154.63	7,684.7	-13,944.1	7,239.5	368,029.74	1,758,466.83	39° 30' 26.274 N	80° 21' 21.729 W
23,611.0	90.65	155.76	7,683.8	-14,031.2	7,279.7	367,942.60	1,758,507.11	39° 30' 25.417 N	80° 21' 21.204 W
23,706.0	90.48	155.20	7,682.8	-14,117.6	7,319.2	367,856.17	1,758,546.53	39° 30' 24.566 N	80° 21' 20.691 W
23,802.0	90.65	155.06	7,681.9	-14,204.7	7,359.5	367,769.08	1,758,586.90	39° 30' 23.709 N	80° 21' 20.165 W
23,898.0	90.95	154.52	7,680.5	-14,291.6	7,400.4	367,682.23	1,758,627.79	39° 30' 22.855 N	80° 21' 19.633 W
23,993.0	91.49	154.32	7,678.5	-14,377.2	7,441.4	367,596.56	1,758,668.80	39° 30' 22.012 N	80° 21' 19.100 W
24,089.0	91.62	154.87	7,675.9	-14,463.9	7,482.6	367,509.88	1,758,709.97	39° 30' 21.159 N	80° 21' 18.564 W
24,185.0	90.92	154.94	7,673.8	-14,550.8	7,523.3	367,422.96	1,758,750.67	39° 30' 20.304 N	80° 21' 18.034 W
24,280.0	91.15	153.68	7,672.1	-14,636.4	7,564.5	367,337.37	1,758,791.85	39° 30' 19.462 N	80° 21' 17.498 W
24,376.0	91.15	154.98	7,670.1	-14,722.9	7,606.1	367,250.86	1,758,833.42	39° 30' 18.611 N	80° 21' 16.957 W
24,472.0	91.15	154.72	7,668.2	-14,809.8	7,646.9	367,163.98	1,758,874.21	39° 30' 17.756 N	80° 21' 16.426 W
24,567.0	91.29	154.96	7,666.2	-14,895.8	7,687.2	367,078.01	1,758,914.59	39° 30' 16.910 N	80° 21' 15.901 W
24,663.0	91.36	154.94	7,664.0	-14,982.7	7,727.9	366,991.07	1,758,955.23	39° 30' 16.054 N	80° 21' 15.372 W
24,759.0	91.12	155.93	7,661.9	-15,070.0	7,767.8	366,903.78	1,758,995.13	39° 30' 15.195 N	80° 21' 14.852 W
24,854.0	91.02	155.68	7,660.1	-15,156.7	7,806.7	366,817.14	1,759,034.06	39° 30' 14.343 N	80° 21' 14.345 W
24,950.0	90.99	155.16	7,658.4	-15,244.0	7,846.6	366,729.85	1,759,073.99	39° 30' 13.484 N	80° 21' 13.825 W
25,046.0	90.92	155.32	7,656.8	-15,331.1	7,886.8	366,642.69	1,759,114.19	39° 30' 12.626 N	80° 21' 13.302 W
25,141.0	90.45	155.64	7,655.7	-15,417.5	7,926.2	366,556.26	1,759,153.61	39° 30' 11.776 N	80° 21' 12.788 W
25,237.0	90.38	154.04	7,655.0	-15,504.4	7,967.1	366,469.38	1,759,194.42	39° 30' 10.921 N	80° 21' 12.257 W
25,332.0	90.18	154.71	7,654.5	-15,590.1	8,008.1	366,383.72	1,759,235.51	39° 30' 10.078 N	80° 21' 11.723 W
25,428.0	89.68	155.62	7,654.7	-15,677.2	8,048.5	366,296.60	1,759,275.83	39° 30' 9.221 N	80° 21' 11.198 W
25,524.0	89.95	155.20	7,655.0	-15,764.5	8,088.4	366,209.31	1,759,315.77	39° 30' 8.362 N	80° 21' 10.677 W
25,619.0	91.05	155.78	7,654.1	-15,850.9	8,127.8	366,122.87	1,759,355.18	39° 30' 7.511 N	80° 21' 10.164 W

Survey Report - Geographic

<b>Company:</b>	EQT PRODUCTION	<b>Local Co-ordinate Reference:</b>	Well Elliott 10H L-003932 - Slot Elliott 10H SHL
<b>Project:</b>	Marion County, WV	<b>TVD Reference:</b>	KB@28 @ 1371.0usft
<b>Site:</b>	Elliott Pad	<b>MD Reference:</b>	KB@28 @ 1371.0usft
<b>Well:</b>	Elliott 10H L-003932	<b>North Reference:</b>	Grid
<b>Wellbore:</b>	Main	<b>Survey Calculation Method:</b>	Minimum Curvature
<b>Design:</b>	Elliott 10H As Drilled	<b>Database:</b>	EQT

Survey

Measured Depth (usft)	Inclination (°)	Azimuth (°)	Vertical Depth (usft)	+N/-S (usft)	+E/-W (usft)	Map Northing (usft)	Map Easting (usft)	Latitude	Longitude
25,715.0	91.02	155.54	7,652.4	-15,938.4	8,167.4	366,035.42	1,759,394.74	39° 30' 6.650 N	80° 21' 9.649 W
25,810.0	90.82	155.26	7,650.9	-16,024.8	8,206.9	365,949.05	1,759,434.28	39° 30' 5.801 N	80° 21' 9.134 W
25,906.0	90.82	154.99	7,649.5	-16,111.8	8,247.3	365,861.97	1,759,474.66	39° 30' 4.944 N	80° 21' 8.608 W
26,002.0	91.25	155.51	7,647.8	-16,199.0	8,287.5	365,774.80	1,759,514.85	39° 30' 4.086 N	80° 21' 8.085 W
26,097.0	91.12	154.92	7,645.8	-16,285.2	8,327.3	365,688.57	1,759,554.66	39° 30' 3.237 N	80° 21' 7.567 W
26,193.0	91.05	155.22	7,644.0	-16,372.3	8,367.8	365,601.53	1,759,595.12	39° 30' 2.381 N	80° 21' 7.040 W
26,289.0	90.92	155.28	7,642.3	-16,459.4	8,407.9	365,514.36	1,759,635.30	39° 30' 1.523 N	80° 21' 6.517 W
26,384.0	90.92	155.41	7,640.8	-16,545.8	8,447.6	365,428.04	1,759,674.93	39° 30' 0.674 N	80° 21' 6.001 W
26,480.0	90.75	155.25	7,639.4	-16,633.0	8,487.6	365,340.81	1,759,714.99	39° 29' 59.815 N	80° 21' 5.479 W
26,576.0	90.28	155.88	7,638.5	-16,720.4	8,527.3	365,253.41	1,759,754.70	39° 29' 58.955 N	80° 21' 4.962 W
26,671.0	90.68	155.19	7,637.8	-16,806.9	8,566.7	365,166.94	1,759,794.05	39° 29' 58.104 N	80° 21' 4.450 W
26,767.0	90.52	155.24	7,636.7	-16,894.0	8,606.9	365,079.79	1,759,834.29	39° 29' 57.247 N	80° 21' 3.926 W
26,862.0	90.48	154.27	7,635.9	-16,979.9	8,647.4	364,993.87	1,759,874.80	39° 29' 56.401 N	80° 21' 3.399 W
26,957.0	90.48	155.91	7,635.1	-17,066.1	8,687.4	364,907.71	1,759,914.81	39° 29' 55.553 N	80° 21' 2.878 W
27,051.0	90.55	154.53	7,634.3	-17,151.4	8,726.8	364,822.37	1,759,954.21	39° 29' 54.714 N	80° 21' 2.365 W
27,146.0	91.19	154.44	7,632.8	-17,237.2	8,767.8	364,736.65	1,759,995.13	39° 29' 53.870 N	80° 21' 1.833 W
27,241.0	90.92	155.30	7,631.1	-17,323.2	8,808.1	364,650.66	1,760,035.46	39° 29' 53.024 N	80° 21' 1.308 W
27,335.0	90.99	154.93	7,629.5	-17,408.4	8,847.6	364,565.40	1,760,075.01	39° 29' 52.185 N	80° 21' 0.793 W
27,430.0	90.85	155.17	7,628.0	-17,494.5	8,887.7	364,479.27	1,760,115.08	39° 29' 51.338 N	80° 21' 0.271 W
27,525.0	90.15	155.12	7,627.2	-17,580.7	8,927.6	364,393.08	1,760,155.01	39° 29' 50.490 N	80° 20' 59.752 W
27,620.0	90.25	154.58	7,626.8	-17,666.7	8,968.0	364,307.08	1,760,195.38	39° 29' 49.643 N	80° 20' 59.226 W
27,715.0	90.52	155.43	7,626.2	-17,752.8	9,008.2	364,220.98	1,760,235.52	39° 29' 48.796 N	80° 20' 58.704 W
27,810.0	90.48	155.64	7,625.4	-17,839.3	9,047.5	364,134.52	1,760,274.86	39° 29' 47.945 N	80° 20' 58.192 W
27,906.0	90.48	155.33	7,624.6	-17,926.6	9,087.3	364,047.17	1,760,314.70	39° 29' 47.086 N	80° 20' 57.673 W
28,002.0	90.35	155.00	7,623.9	-18,013.8	9,127.7	363,960.05	1,760,355.02	39° 29' 46.228 N	80° 20' 57.148 W
28,016.0	90.35	155.36	7,623.8	-18,026.5	9,133.5	363,947.35	1,760,360.89	39° 29' 46.103 N	80° 20' 57.072 W
28,038.0	90.35	155.36	7,623.6	-18,046.5	9,142.7	363,927.35	1,760,370.06	39° 29' 45.907 N	80° 20' 56.952 W





Elliott Pad  
 Elliott 10H As Drilled  
 KB@28 @ 1371.0usft  
 Marion County, WV  
 Main

PROJECT DETAILS:  
 Geodetic System: US State Plane 1927 (Exact solution)  
 Datum: NAD 1927 (NADCON CONUS)  
 Ellipsoid: Clarke 1866  
 Zone: West Virginia North 4701  
 System Datum: Mean Sea Level



WELL DETAILSElliott 10H L-003932					
+N/-S	+E/-W	Northing	Easting	Latitude	Longitude
0.0	0.0	381973.81	1751227.36	39° 32' 43.397 N	80° 22' 55.839 W

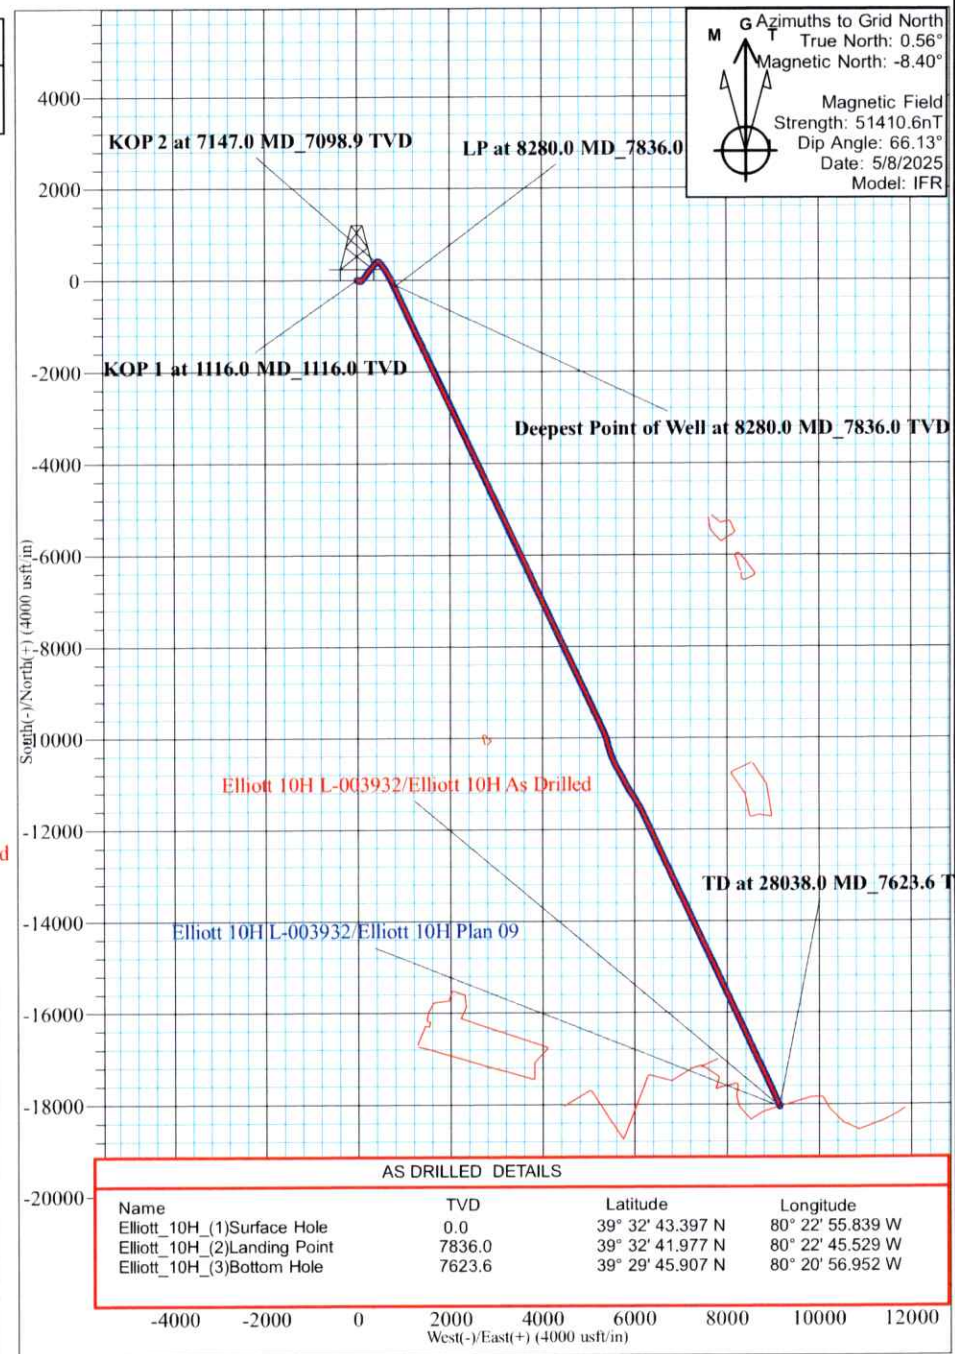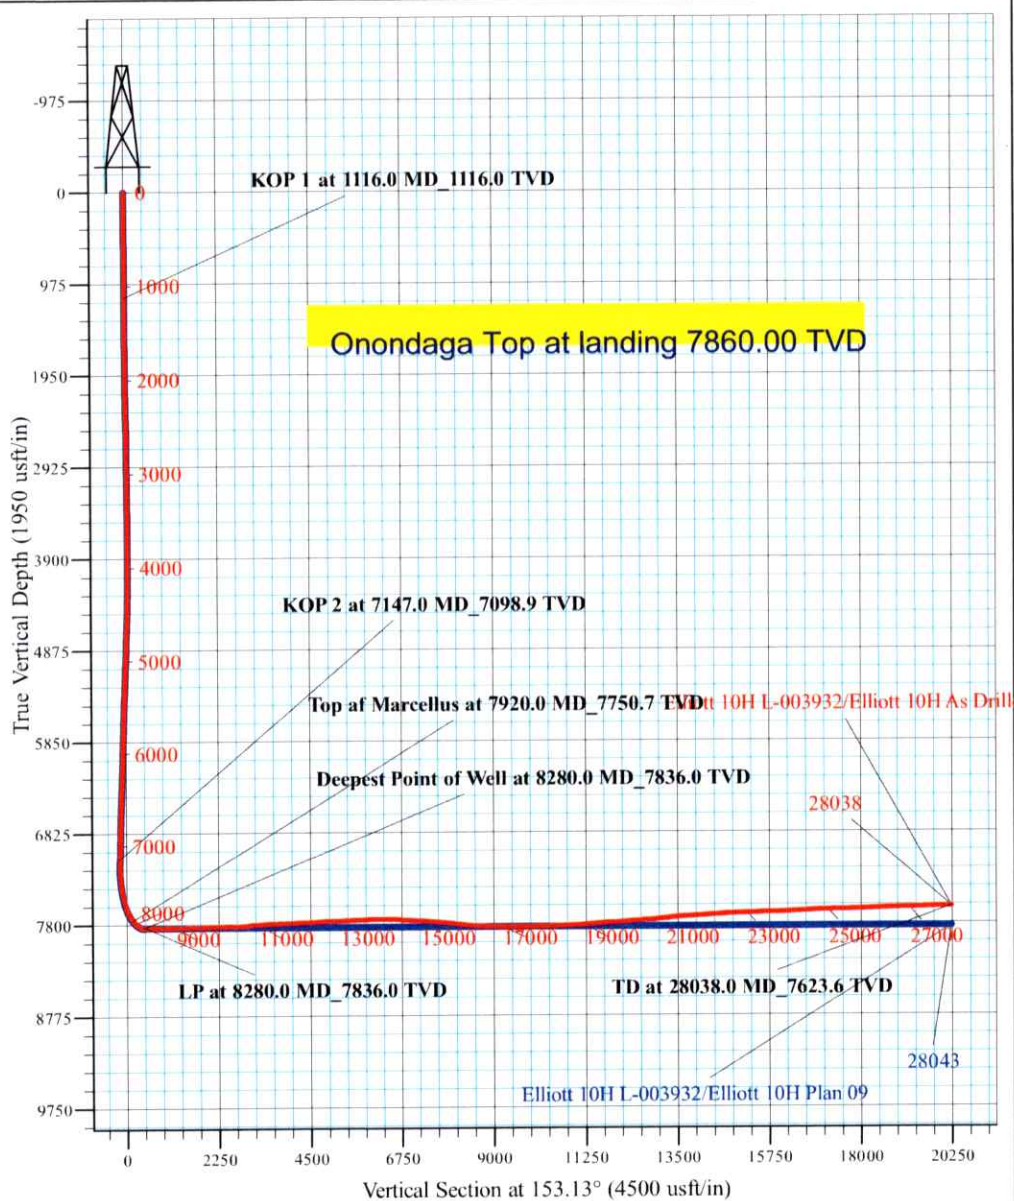

G Azimuths to Grid North  
 True North: 0.56°  
 Magnetic North: -8.40°  
 Magnetic Field  
 Strength: 51410.6nT  
 Dip Angle: 66.13°  
 Date: 5/8/2025  
 Model: IFR