



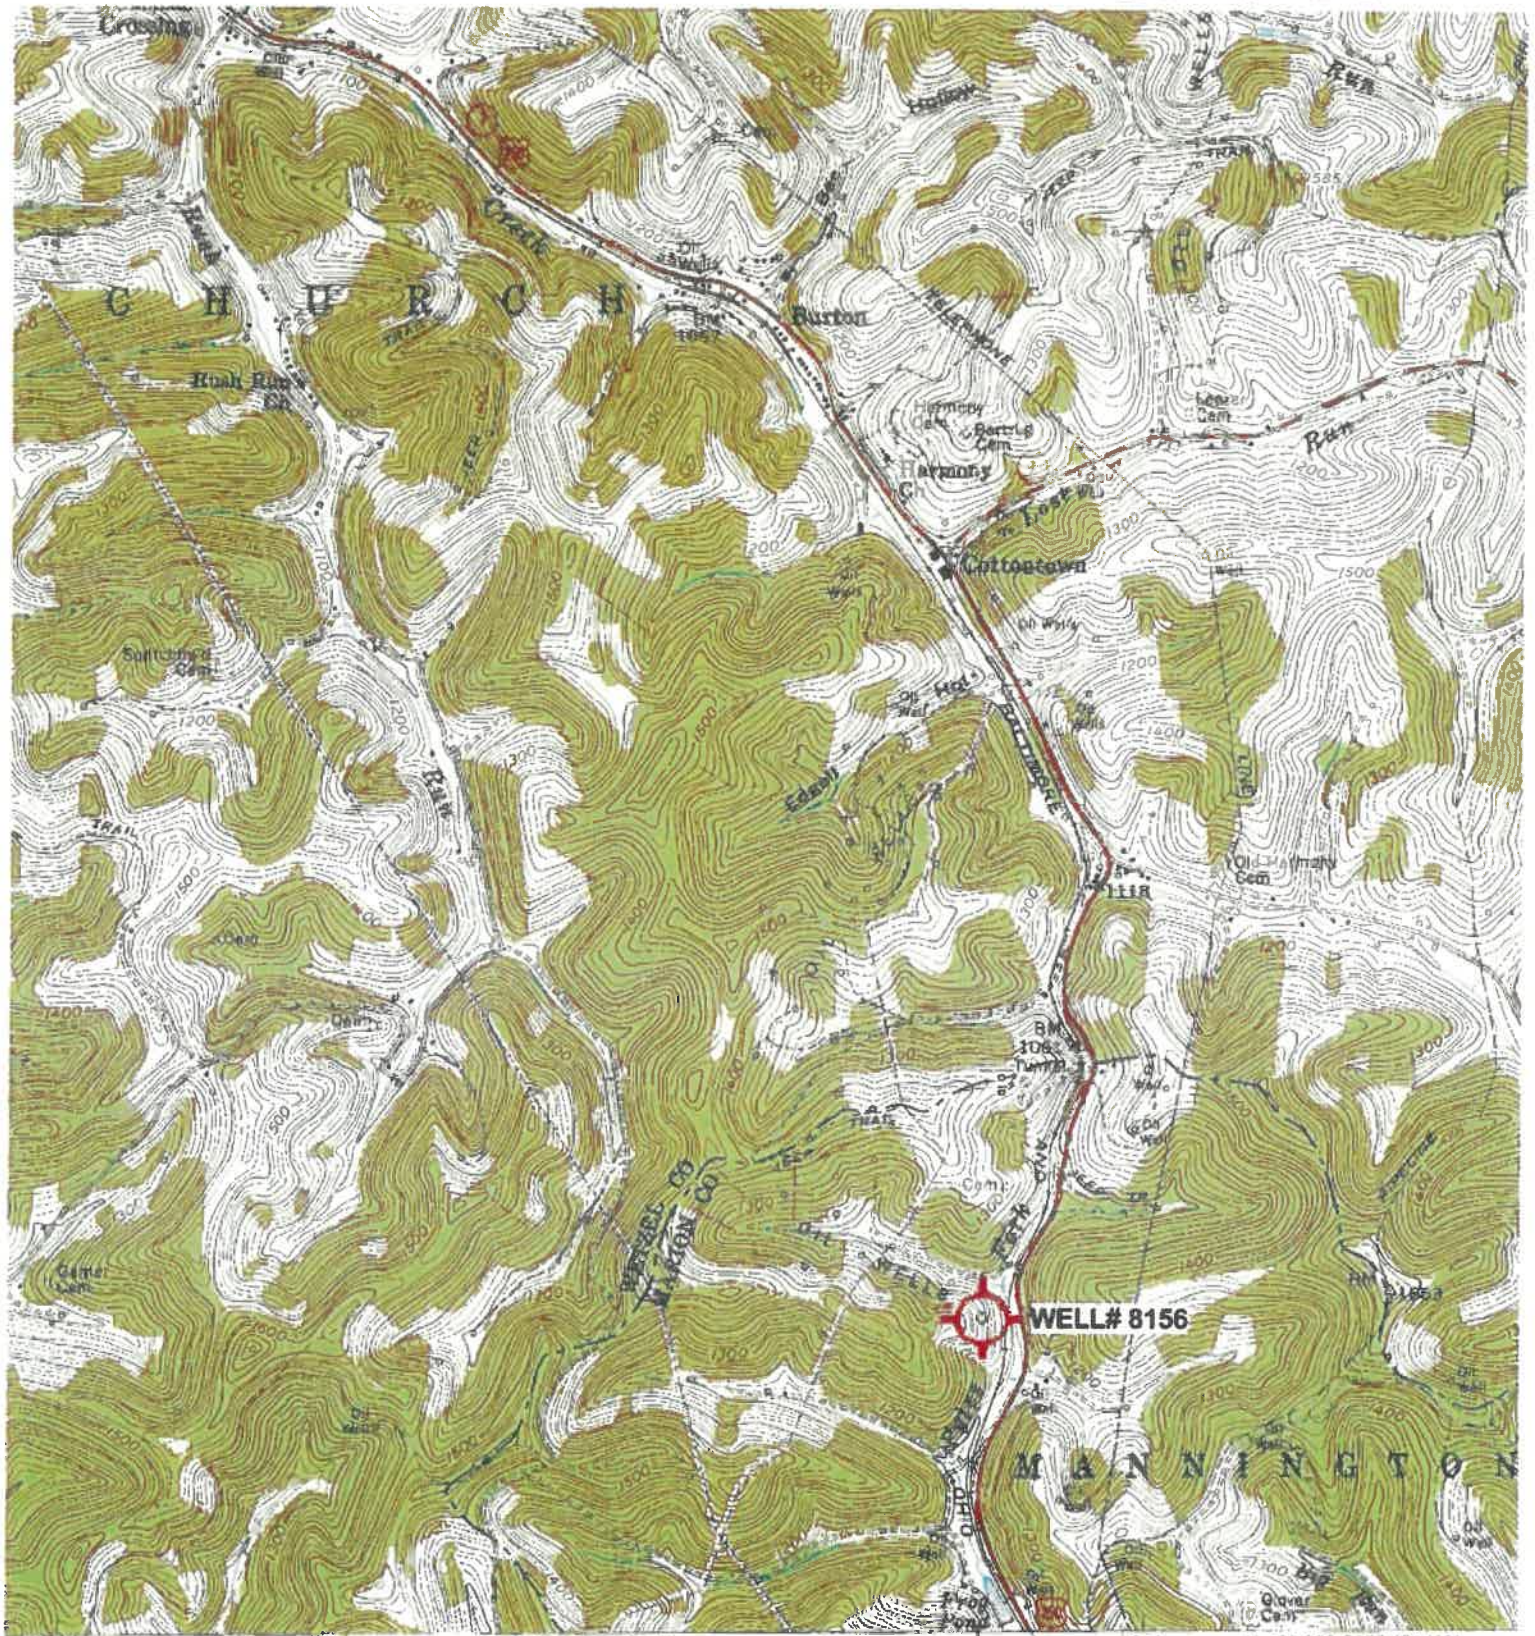

27°30' 47' 48' (GLOVER GAP) 49' 25' 125000 FEET (PA) 51

SCALE 1:24 000

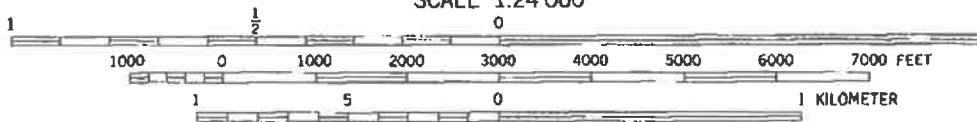


CONTOUR INTERVAL 20 FEET
NATIONAL GEODETIC VERTICAL DATUM OF 1929

RECEIVED
Office of Oil and Gas

JUL 10 2026


WV Department of
Environmental Protection

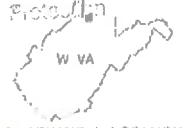

'Hundred; WV, PA' Scale: 1" = 0.379Mi 609Mi 1,999Fi, 1 Mi = 2.642" , 1 cm = 240Mt

08/21/2026

4204902615

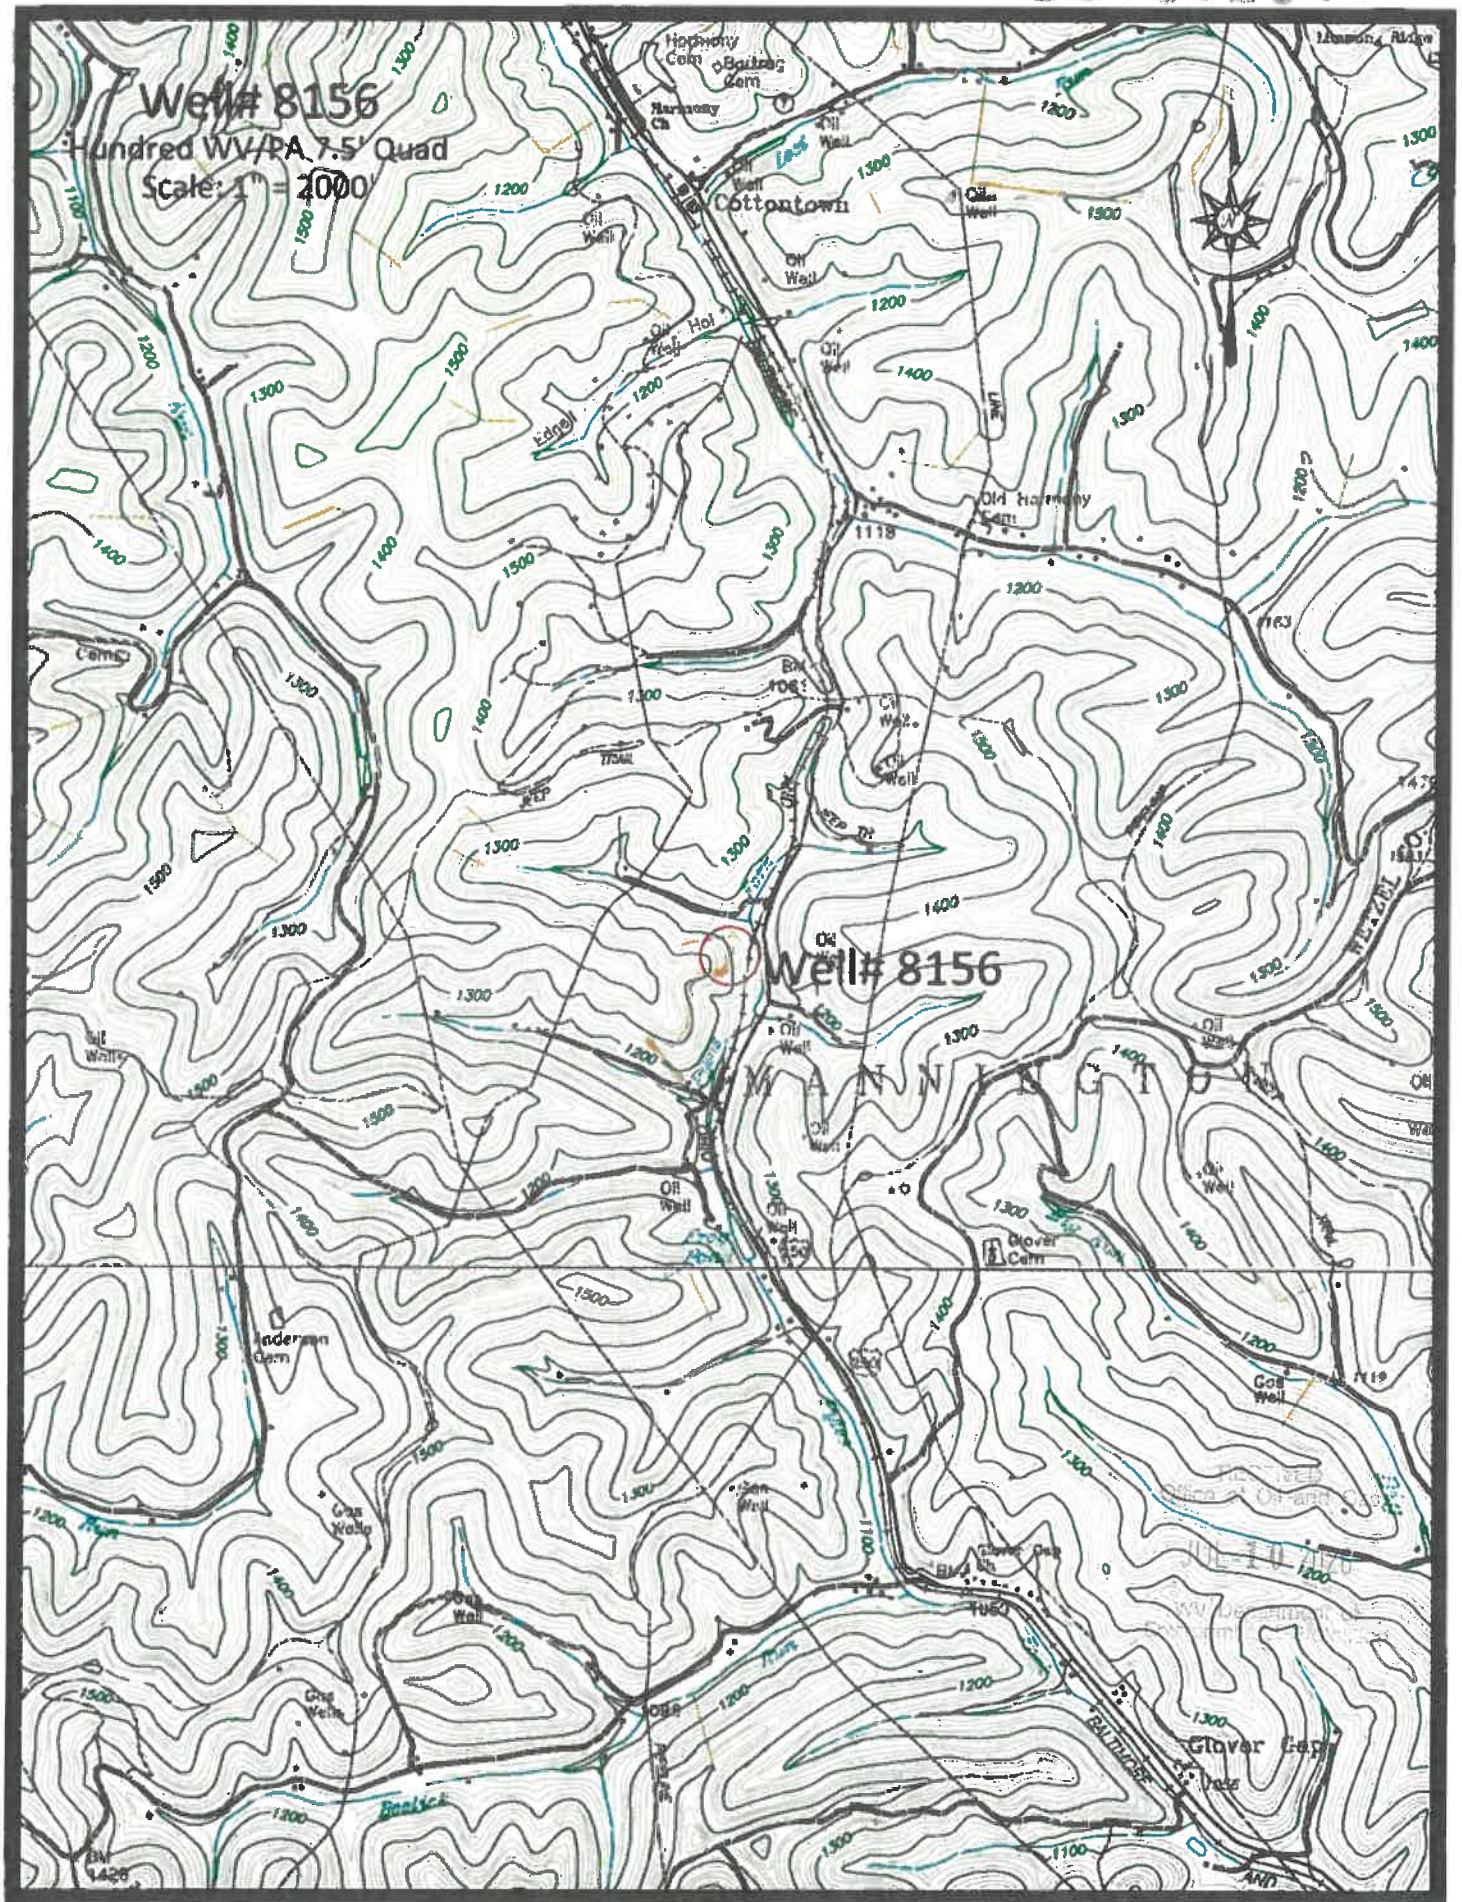

Arise River

08/21/2026

08/21/2026

WW-7
8-30-06



West Virginia Department of Environmental Protection
Office of Oil and Gas

WELL LOCATION FORM: GPS

API: 47-049-70492 WELL NO.: 8156
FARM NAME: WELLS #3
RESPONSIBLE PARTY NAME: WEST VIRGINIA LAND RESOURCES INC.
COUNTY: MARION DISTRICT: MANNINGTON
QUADRANGLE: HUNDRED, WV
SURFACE OWNER: GEORGE NEVILLE
ROYALTY OWNER: _____
UTM GPS NORTHING: 4,387,340 m
UTM GPS EASTING: 549,549 m GPS ELEVATION: 371 m

The Responsible Party named above has chosen to submit GPS coordinates in lieu of preparing a new well location plat for a plugging permit or assigned API number on the above well. The Office of Oil and Gas will not accept GPS coordinates that do not meet the following requirements:

1. Datum: NAD 1983, Zone: 17 North, Coordinate Units: meters, Altitude: height above mean sea level (MSL) – meters.
2. Accuracy to Datum – 3.05 meters
3. Data Collection Method:

Survey grade GPS x : Post Processed Differential X

Real-Time Differential _____

Mapping Grade GPS _____ : Post Processed Differential _____

Real-Time Differential _____

4. Letter size copy of the topography map showing the well location.

I the undersigned, hereby certify this data is correct to the best of my knowledge and belief and shows all the information required by law and the regulations issued and prescribed by the Office of Oil and Gas.

Signature

PS 2002

Title

JANUARY 28, 2026

Date

RECEIVED
Office of Oil and Gas

JUL 10 2026

WV Department of
Environmental Protection

08/21/2026