


LATITUDE 39 37 30

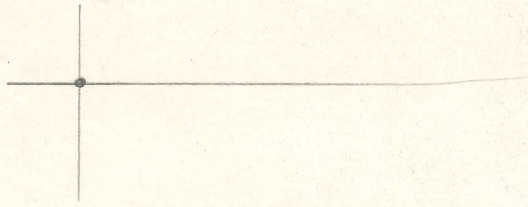

.69s  
2.2w

80 22 30

LONGITUDE 80 15

7'5 OGIS topo location

7.5' loc \_\_\_\_\_ 15' loc \_\_\_\_\_  
(calc.) \_\_\_\_\_

Company \_\_\_\_\_

Farm SAMUEL OLIVER HEIRS I

Quad GLOVER GAP

County MARION

District MANNINGTON

WELL LOCATION MAP

File No. 30084





I, the undersigned, hereby certify this map is correct and shows all the information to the best of my knowledge, as required by the Oil & Gas section of the Mining Laws of West Virginia. David Weed, Engineer.  
 Acknowledged before me a Notary Public this 8th day of November, 1933.



Mannington District, Marion County, W. Va.  
 By Thomas W. Hanley, Mannington, W. Va.  
 On 3/4 acre, Pyles Fork of Buffalo Creek; surface and mineral  
 rights owned by Samuel Oliver Heirs, Glover Gap, W. Va.  
 Elevation, 1118' L.  
 No casing record available.  
 Coal was encountered at 765-770 and 860-867'.  
 Abandonment reported to Dept. of Mines Nov. 24, 1933.  
 Well was shot at 2894-2912'.  
 Oil well.

MAR-84-A

	Top.	Bottom.	Thickness.
Conductor	0	13	13
Mapletown (Sewickley) Coal	765	770	5
Pittsburgh Coal	860	867	7
Little Dunkard Sand	1290	1310	20
Big Dunkard Sand	1345	1390	45
Salt Sand	1550	1875	325
Little Lime	2060	2075	15
Big Lime	2085	2175	90
Big Injun Sand	2175	2375	200
50-Ft. Sand	2773	2843	70
30-Ft. Sand (oil, 2894')	2894	2906	12
Total depth		2912	