


LATITUDE 39 35

LONGITUDE 80 17 30

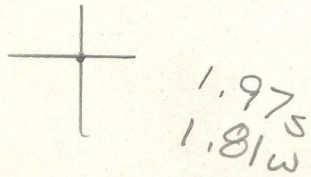

7'5 OGIS topo location

7.5' loc _____ 15' loc _____
 _____ (calc.) _____

Company _____ 939 _____

Farm OZIAS KUHN

Quad MANNINGTON

County MARLON

District MANNINGTON

WELL LOCATION MAP

File No. 30129









Name	Color	Character	Oil, Gas or Water	Top	Bottom	Thickness	Total Depth	Remarks
<i>[Redacted]</i>				777	782	5		<i>Keen Lenses by Natural Gas</i>
<i>[Redacted]</i>				1208	1250	42		
<i>[Redacted]</i>				264	1342	78		
<i>[Redacted]</i>				1465	1580	115		
<i>[Redacted]</i>				1600	1666	66		
<i>[Redacted]</i>				1738	1774	36		
<i>[Redacted]</i>				1882	1902	20		
<i>[Redacted]</i>				2025	2044	9		
<i>[Redacted]</i>				2044	2048	4		
<i>[Redacted]</i>				2048	2089	41		
<i>[Redacted]</i>				2089				
<i>[Redacted]</i>			<i>oil</i>	2214	2246			
								<i>Total Depth 2276</i>

*Richard
P. Dyer*

75 1/2

Well was shot at *Super Day* feet; well was shot at _____ feet.
 Fresh water at *no water* feet; fresh water at _____ feet.

Producing hole
 Date *April 9, 1934* Approved *[Signature]* Owner




PRELIMINARY DATA SHEET NO. 1

File No. _____ Well No. 939
Lowell Dillinger Company of Blacksville W. Va.
on the Ozias Tubbs Farm

containing 160 1/2 acres. Location
Mannington District, in Marietta County, West Virginia

The surface of the above tract is owned in fee by Ozias Tubbs
Mannington W. Va. address, and the mineral rights are owned by
Ozias Tubbs of Mannington W. Va.

The oil and gas privileges are held under lease by the above named company, and this well is drilled under permit
Not required issued by the West Virginia Department of Mines, Oil and Gas Division

Elevation of surface at top of well, 1302 Spirit
Barometric.

The number of feet of the different sized casings used in the well.

feet	size	Wood conductor
<u>296</u>	<u>10"</u> size, csg.	<u>2226</u> feet <u>2"</u> sized csg.
<u>65 1/5</u>	<u>1803</u> size, csg.	feet sized csg.
<u>53 1/16</u>	<u>2001</u> size, csg.	feet sized csg.

_____ packer of _____ size, set at _____

_____ packer of _____ size, set at _____

_____ in casing perforated at _____ feet to _____ feet.

_____ in casing perforated at _____ feet to _____ feet.

Coal was encountered at 777 feet, thick ness 5 1/4 inches, and at _____

feet; thickness _____ inches; and at _____ feet; thickness _____ inches.

Liners were used as follows: (Give details)

5/4 casing was
ported and 436 left in rest
was pulled.

April 8, 1936.

Date. _____
Approved Lowell Dillinger
By _____

