LATITUDE 39° 35'

LONGITUDE 80° 20'

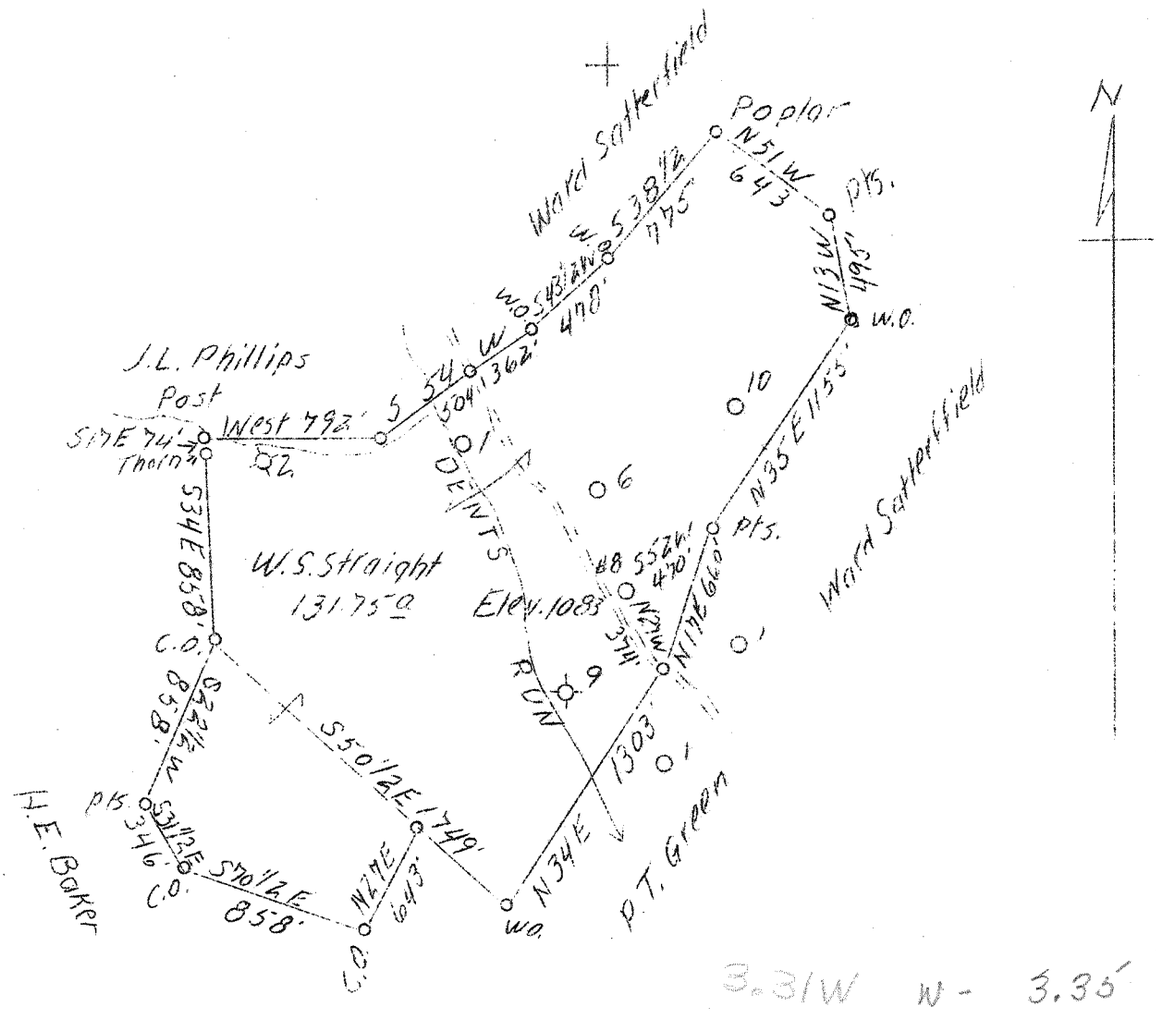

ABD.

Company	William Moses
Address	Salem, W. Va.
Farm	W. S. Straight
Tract	1
Elevation (SL)	1083
Quadrangle	Mannington S.
County	Marion
District	Mannington
Engineer	O. D. Nutter
Eng. Reg. No.	-
Date	Feb. 10, 1937
Scale	1" - 800'

STATE OF WEST VIRGINIA
Department of Mines
OIL & GAS DIVISION
Charleston

WELL LOCATION MAP

File No. Mar-217-A

x Denotes location of well on U. S. Topographic Maps, scale 1 to 62,500, latitude and longitude lines being represented by border lines as shown.

- Denotes one inch spaces on border line of original tracing.