39°32'30"

Latitude

80°25'00"

.60S
.11W

Longitude

Topo Location

7.5' Loc. _____ 15' Loc. _____

_____ (calc.) _____

Company _____

Farm _____

15' Quad _____
(sec.)

7.5' Quad Glover Gap

District Mannington

WELL LOCATION PLAT

County 049 Permit 30363

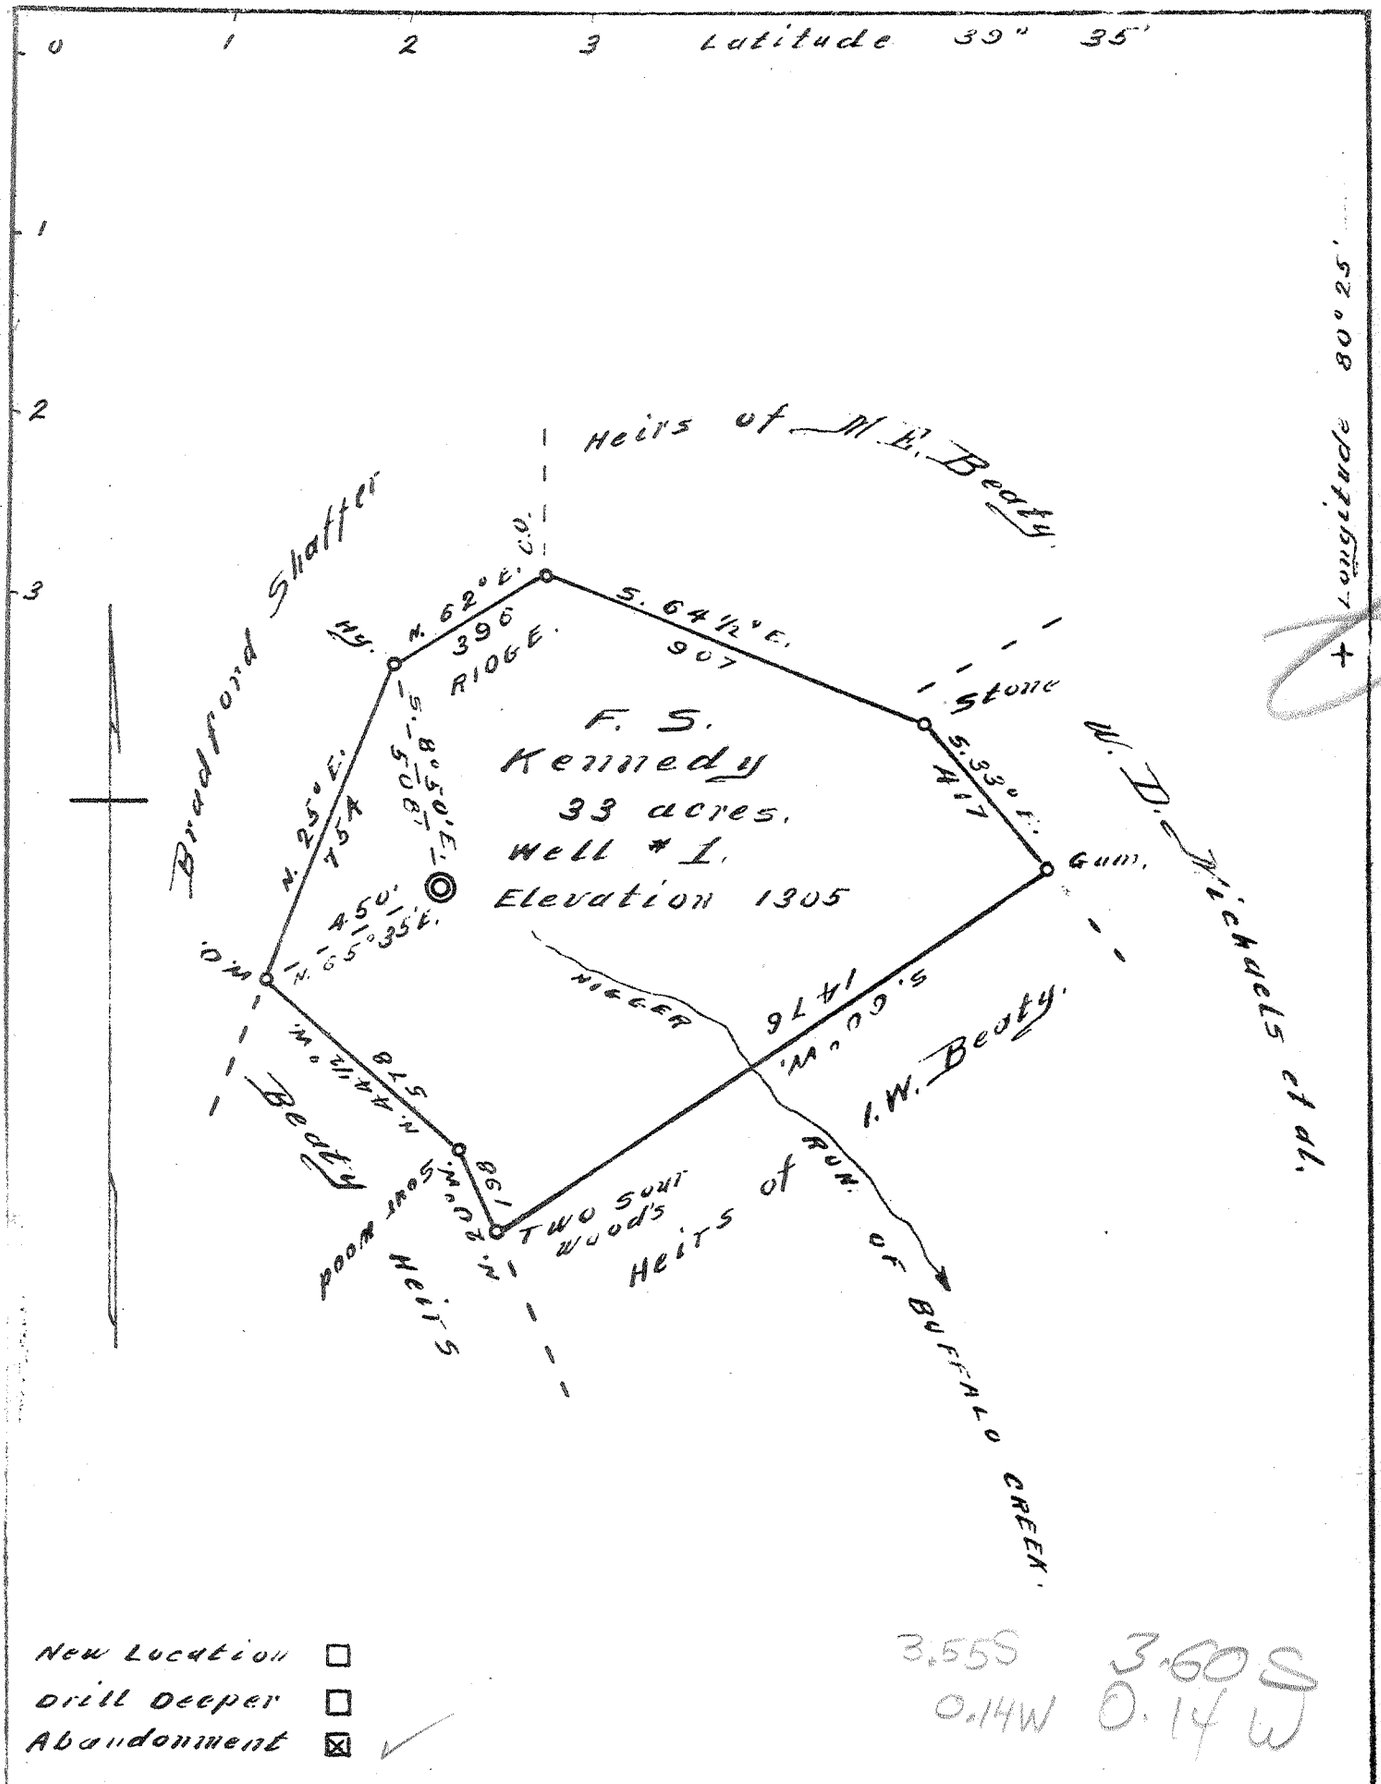

New Location ☐
Drill Deeper ☐
Abandonment ☒ ✓

3.55S 3.60S
0.14W 0.14W

COMPANY Hanley, Beaty, Beaty,
ADDRESS Mannington, W.Va.
FARM F. S. Kennedy
TRACT 33 acres
WELL No. 1
ELEVATION 1305 Spirit Level
QUADRANGLE Mannington, S.W.
COUNTY Marion DIST. Mannington
ENGINEER David Weed
FILE No. ____ DRAWING No. ____
DATE 8-4-42 SCALE 1" = 400'

State of West Virginia.
Department of Mines
Oil & Gas Division
Charleston
Well Location Map
File No. MAR-363-A

+ Denotes location of well on U.S. Topographic Maps, scale 1 to 62,500, latitude & longitude lines being represented by lines on border
— Denotes 1" spaces on border