



Reference:-- Deed from Charles Hamilton to Elmus J. Swiger and Agnes L. Swiger, his wife, recorded in Merrens County Clerk Office, in Book Book No. 377, of page 134.

Surface owned by Elmus J. Swiger and Agnes L. Swiger, his wife, whose postoffice address is Welles, West Va. Coal owned by the Little Kanawha Syndicate. Notify Mr Bernard Sampson, Fairmont, W. Va.

- New Location
- Drill Deeper
- Abandonment


Well purchased from South Penn Natural Gas Co South Penn Map No N-50E N-S, E-13

Company	VALLEY STEEL PRODUCTS CO.
Address	St. Louis, Missouri
Farm	Snodgrass Heirs
Tract	Acres 54.1 Lease No.

STATE OF WEST VIRGINIA  
DEPARTMENT OF MINES  
OIL AND GAS DIVISION  
CHARLESTON

LATITUDE 39 32 30

LONGITUDE 80 22 30

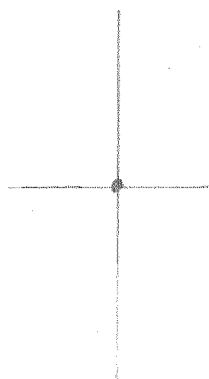

1.996  
0.42W

7'5 OGIS topo location

7.5' loc \_\_\_\_\_ 15' loc \_\_\_\_\_  
 \_\_\_\_\_ (calc.) \_\_\_\_\_

Company \_\_\_\_\_

Farm SNOODGRASS HEIRS 1

Quad GLOVER GAP

County MARION

District MANNINGTON

WELL LOCATION MAP

File No. 30725

SNODGRASS HEIRS NO. 1 WELL.

125A

Hannington District, Marion County, W. Va.  
 By Valley Steel Products Co., St. Louis, Mo.  
 Abandoned under permit Mar-.....-51  
 On 54.1 acres, on Little Knotstone Run.  
 Elevation, 1265' L.  
 Surface owned by B. J. and A. L. Swiger, Wallace, W. Va., and minerals by  
 Little Kanawha Syndicate, Bernard Simpson, Fairmont, W. Va.  
 Date of completion, etc., no record available.  
 Shot with 30 qts.  
 8 1/2" casing, 1304'; 6 1/2", 2088'; all left in.  
 Coal was encountered at 689-697'.  
 Oil well. Record to Dept. of Mines stamped June 6, 1951.  
 Record to EOT from Mrs. Griffith Nov. 28, 1951. Old File No. 820.

	Top.	Bottom.
Pittsburgh Coal	689	- 697
Big Bunkard Sand	1192	- 1273
Salt Sand	1439	- 1609
Big Injun Sand	2071	- 2174
Gantz Sand	2639	- 2657
Gordon Sand	2908	- 2932
Total depth		2933

There is no record available for this well.  
 This estimated record made from a true record of  
 the R. P. Conway No. 2, located near the Snodgrass,  
 which we abandoned for Strauss & Beron, October 14, 1947.  
 Records adjusted to the difference in elevation of the  
 above two wells.

R. P. Conway No. 2 - Elevation, floor	1178.58'
Ground	1176.38'
Snodgrass Heirs No. 1	1265'



STATE OF WEST VIRGINIA  
DEPARTMENT OF MINES  
OIL AND GAS DIVISION

820

WELL RECORD

Permit No. MAR-725-A

Oil or Gas Well \_\_\_\_\_  
(KIND)

Company Valley Steel Products Company  
Address Saint Louis, Mo.  
Farm Snodgrass Heirs Acres 54.1  
Location (waters) Little Whetstone Run  
Well No. 1 Elev. 1265'  
District Mannington County Marion  
The surface of tract is owned in fee by E. J. & A. L. Swiger  
Address Wallace, W. Va.

Casing and Tubing	Used in Drilling	Left in Well	Packers
Size			
16			Kind of Packer
13			
10			Size of
8 1/4	1304'	1304'	
6 3/8	2088'	2088'	Depth set
5 3/16			
3			Perf. top
2			Perf. bottom
Liners Used			Perf. top
			Perf. bottom

Mineral rights are owned by Little Kanawha Syndicate  
Mr. Bernard Sampson Address Fairmont, W. Va.  
Drilling commenced No record available  
Drilling completed "  
Date Shot " From " To "  
With 30 qts.  
Open Flow /10ths Water in Inch  
/10ths Merc. in Inch  
Volume \_\_\_\_\_ Cu. Ft.  
Rock Pressure \_\_\_\_\_ lbs. \_\_\_\_\_ hrs.  
Oil \_\_\_\_\_ bbls., 1st 24 hrs.  
Fresh water \_\_\_\_\_ feet \_\_\_\_\_ feet  
Salt water \_\_\_\_\_ feet \_\_\_\_\_ feet

CASING CEMENTED \_\_\_\_\_ SIZE \_\_\_\_\_ No. Ft. \_\_\_\_\_ Date \_\_\_\_\_  
COAL WAS ENCOUNTERED AT 689 FEET \_\_\_\_\_ INCF  
\_\_\_\_\_ FEET \_\_\_\_\_ INCHES \_\_\_\_\_ FEET \_\_\_\_\_ INC'  
\_\_\_\_\_ FEET \_\_\_\_\_ INCHES \_\_\_\_\_ FEET \_\_\_\_\_ INC'

Formation	Color	Hard or Soft	Top	Bottom	Oil, Gas or Water	Depth Found	Remarks
Pittsburgh Coal			689'	697'			
Big Dunkard			1192'	1273'			
Salt Sand			1489'	1609'			
Big Injun			2071'	2174'			
Gant Sand			2639'	2657'			
Gordon Sand			2908'	2932'			
TOTAL DEPTH				2933'			

There is no record available for this well.  
This estimated record made from a true record of the  
E. P. Conoway # 2, located near the Snodgrass, which  
we abandoned for Strauss & Beren, October 14, 1947.  
Records adjusted to the difference in elevation of the  
above two wells.  
E. P. Conoway # 2 - Elevation, floor 1178.58  
gr'nd 1176.38  
Snodgrass Hrs. # 1 1265.

