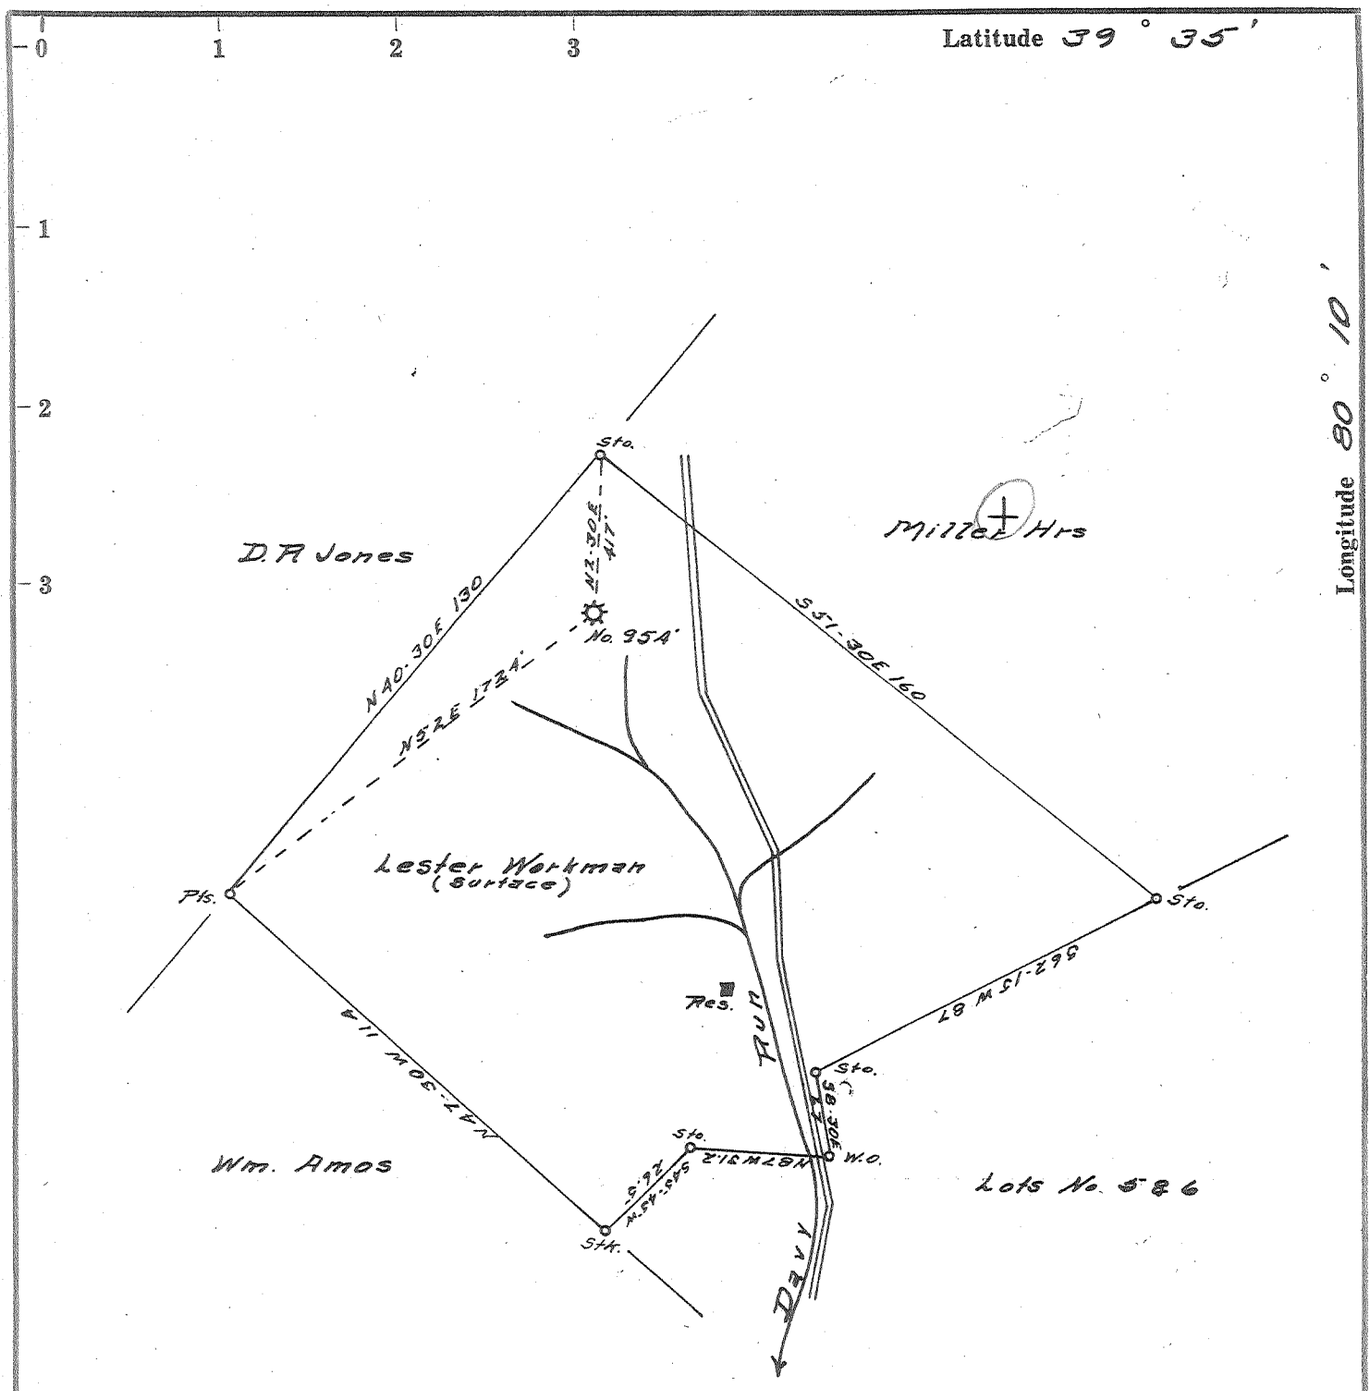

2.80S
2.00W

7102 A

7185 R

New Location. ☐
Drill Deeper..... ☐
Redrill..... ☐
Abandonment..... ☒

NOV 28 1960

Company CARNEGIE NATURAL GAS
Address PITTSBURGH, Pa.
Farm E. L. MORGAN
Tract Acres 62 Lease No. E 10130-10
Well (Farm) No. 1 Serial No. E 954
Elevation (Spirit Level) 1260
Quadrangle BLACKSVILLE S.W.
County MARION District LINCOLN
Engineer John Orth Book
Engineer's Registration No. 1850
File No. Drawing No.
Date 10-16-61 Scale 1" = 40 Poles

STATE OF WEST VIRGINIA
DEPARTMENT OF MINES
OIL AND GAS DIVISION
CHARLESTON

WELL LOCATION MAP

FILE NO. MAR-895-A

+ Denotes location of well on United States Topographic Maps, scale 1 to 62,500, latitude and longitude lines being represented by border lines as shown.

— Denotes one inch spaces on border line of original tracing.

E. L. MORGAN No. 1 (E-954) CARNEGIE NG 6, MAR-895-A