


LATITUDE 39 37 30

LONGITUDE 80 22 30

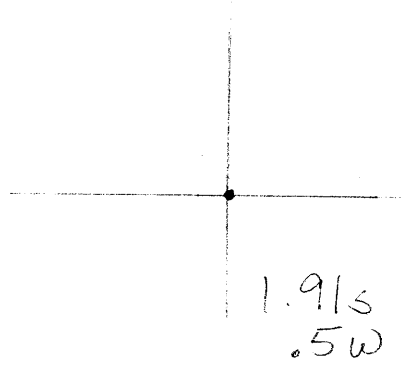

7'5 OGIS topo location

7.5' loc	<u>1.91S</u>	15' loc	_____
	<u>.5W</u>	(calc.)	_____

Company _____

Farm FARRELL HEIRS 3

Quad GLOVER GAP

County MARION

District MANNINGTON

WELL LOCATION MAP

File No. 70064

FARRELL HEIRS NO. 3 WELL.

70064
No. 25 O.P.-Marion.
No. 401 M-M-T Rept.,
tabulated only.

See map C 27
Mannington District, Marion County, W. Va.
By Hartman Oil Co.
1.4 mi. W. W. of Metz.
Elevation, 1015' B.

401 mmt
Co Rep

	Top.	Bottom.
Pittsburgh Coal		755
Big Injun Sand		2080
Gordon Sand		2936 - 2938
Total depth		2957½