


39° 30'

LATITUDE 39 30

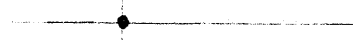

.77S
.83W

LONGITUDE 80 20 80 20

7'5 OGIS topo location

7.5' loc .77S 15' loc _____
 .83W (calc.) _____

Company _____ 1885

Farm ANNA GLOVER
 (H. R. GLOVER)
 70353

Quad SHINNSTON Shinnston

County MARION

District LINCOLN

WELL LOCATION MAP

File No. 70084

MAR

M-001
70084
265.

PITTSBURGH AND WEST VIRGINIA GAS COMPANY

Well No. 1885

Lessor - Anna Glover Lincoln Dist., Marion Co.

Clks. NE 1(1)

Completed 6/21/06

Elevation - ?

Abandoned 5/22/26

<u>Formation</u>	<u>Top</u>	<u>Bottom</u>
Unrecorded	0	105
Sand - Bluff	105	160
Lime	160	340
Red Rock	340	350
Lime	350	445
Coal - Mapletown	445	450
Slate	450	485
Lime	485	560
Coal - <i>192</i>	560	573
Slate	573	585
Sand	585	615
Lime	615	645
Red Rock	645	660
Lime	660	700
Red Rock	700	735
Slate	735	750
Lime	750	770
Slate	770	800
Lime	800	850
Red Rock	850	890
Lime	890	900
Red Rock	900	915
Lime	915	955
Slate	955	1000
Sand	1000	1015
Slate	1015	1025
Sand	1025	1050
Slate	1050	1100
Sand & Big Dun.	1100	1140
Slate & Lime	1140	1215
Sand - 1st Gas	1215	1320
Slate	1320	1330
Sand - 2nd Gas	1330	1360
Slate	1360	1365
Lime	1365	1385
Sand - Salt	1385	1645
Red Rock	1645	1745
Slate	1745	1800
Slate	1800	1805
Lime	1805	1810
Slate	1810	1820
Lime - Lit. Lime	1820	1846
Pencil Cave	1846	1850
Lime - Big Lime	1850	1925
Sand - Big In.	1925	2070
Slate	2070	2100
Lime	2100	2140
Slate	2140	2200
Lime	2200	2215
Slate	2215	2250
Lime	2250	2300
Slate	2300	2360
Shells	2360	2425
Sand - 50'	2425	2445
Slate	2445	2465
Sand	2465	2540
Slate	2540	2545
Sand - 30'	2545	2580
Slate	2580	2600
Lime	2600	2620
Slate	2620	2650
Sand - Boulder	2650	2675

(C)

Gas at 2025

Gas at 2435

Gas at 2517

(C)

Well #1885

<u>Formation</u>	<u>Top</u>	<u>Bottom</u>	<u>Remarks</u>
Slate	2675	2710	
Sand - Stray	2710	2750	
Slate	2750	2753	
Sand - Gordon	2753	2780	
Slate	2780	2783	
Sand - 4th	2783	2849	
Lime	2849	2930	
Slate	2930	2935	
Lime	2935	2975	
Slate	2975	2991	
TOTAL DEPTH		<u>2991</u>	

No volume or pressure data on hand for original tests.

Mannington District, Marion County, W. Va.
By Philadelphia Company.
2.2 mi. N. 70° W. of Amabelle.
Elevation, 1210' B.

	Top.	Bottom.	Thickness.
Mapletown (Sewickley) Coal	445	- 450	5
Pittsburgh Coal	560	- 573	13