


39 35 LATITUDE 80 20

LONGITUDE 80 20 80 20

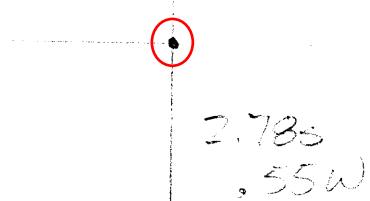

7'5 OGIS topo location

7.5' loc 2.785 15' loc _____
 .55W (calc.) _____

Company _____
 Paddy Hopkins 2
 Farm Paddy Hopkins 2

 Quad MANNINGTON
 District MANNINGTON

WELL LOCATION MAP
 File No. 73112

PADBY HOPKINS NO. 2 WELL.

70112

Pt. No. 36 O.F.-Marion.
Vol. I(a), p. 159.
No. 495 M-M-T Rept.,
tabulated only.

495

Mannington District, Marion County, W. Va.

By Bart Oil Co.

Conductor, 24"; 10" casing, 220'; 8", 1000'; 6-5/8", 1486';
5-3/16", 1970'.

	Top.	Bottom.
Pittsburgh Coal (bottom)		471
Stray Sand (bottom)		2668
Gordon Sand (1st pay, 2687')	2678'	