


Latitude

39° 35'

80° 22' 30"

Longitude

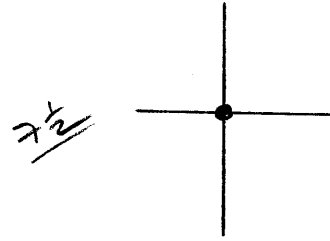

Topo Location

7.5' Loc. <u>1.42S</u>	15' Loc. <u>1.42S</u>
<u>.49W</u>	(calc.) <u>2.71W</u>
	<u>2.71W</u>

#438 on Co Rept. MAP

Company _____

Farm Isaac Hibbs

15' Quad MANNINGTON SE
(sec.)

7.5' Quad Glover Gap

District MANNINGTON

WELL LOCATION PLAT

County 049 Permit 70235