


Latitude

39° 35'

80° 17' 30"

Longitude

7 1/2

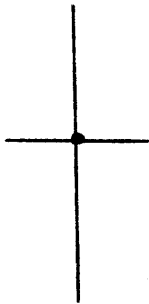

Topo Location

1.49s

3.94w

7.5' Loc. 1.63E 15' Loc. 1.03S

1.70W (calc.) 3.92W

#500 ON Co REF MAP

Company 1 SOUTH PENN

Farm C.A. Kuhn 1

15' Quad MANNINGTON SE
(sec.)

7.5' Quad MANNINGTON

District MANNINGTON

WELL LOCATION PLAT

County 049 Permit 70273