


Latitude 39 35

39° 35'

88° 15'

Longitude

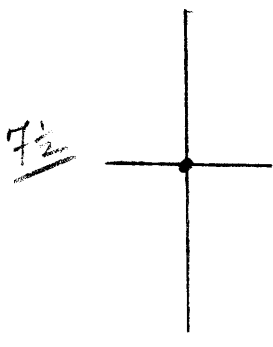

Topo Location

7.5' Loc. 1.805 15' Loc. 1.808
2.170 (calc.) 2.170

#594 on Co. REPT MAP

Company SOUTH POND

Farm BENJ. HUFFMAN 3

15' Quad MANNINGTON SE
(sec.)

7.5' Quad MANNINGTON

District LINCOLN

WELL LOCATION PLAT

County 049 Permit 70329