


Latitude

39° 32' 30"

80° 17' 30"

Longitude

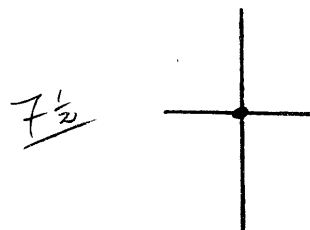

Topo Location

7.5' Loc. 1.482 15' Loc. 4.365
.71W (calc.) 2.93W

#609 ex Co Rept Map

Company Philadelphia

Farm F. (O.M.) Freeland I

15' Quad MANNINGTON SE
(sec.)

7.5' Quad MANNINGTON

District LINCOLN

WELL LOCATION PLAT

County 049 Permit 70335