

WW-7
8-30-06



West Virginia Department of Environmental Protection
Office of Oil and Gas

WELL LOCATION FORM: GPS

API: 47-051-00010 WELL NO.: M-1567

FARM NAME: B.R. & ALICE CHAMBERS

RESPONSIBLE PARTY NAME: WEST VIRGINIA LAND RESOURCES INC.

COUNTY: MARSHALL DISTRICT: CAMERON

QUADRANGLE: CAMERON WV, PA

SURFACE OWNER: ALLEN L. WENDT ET UX

ROYALTY OWNER: _____

UTM GPS NORTHING: 4,409,496 m (1214')

UTM GPS EASTING: 541,008 m GPS ELEVATION: 370 m

The Responsible Party named above has chosen to submit GPS coordinates in lieu of preparing a new well location plat for a plugging permit or assigned API number on the above well. The Office of Oil and Gas will not accept GPS coordinates that do not meet the following requirements:

- Datum: NAD 1983, Zone: 17 North, Coordinate Units: meters, Altitude: height above mean sea level (MSL) – meters.
- Accuracy to Datum – 3.05 meters
- Data Collection Method:

Survey grade GPS : Post Processed Differential _____
Real-Time Differential

Mapping Grade GPS _____ : Post Processed Differential _____
Real-Time Differential _____

4. **Letter size copy of the topography map showing the well location.**

I the undersigned, hereby certify this data is correct to the best of my knowledge and belief and shows all the information required by law and the regulations issued and prescribed by the Office of Oil and Gas.

Signature

Professional Surveyor
Title

SEPTEMBER 26, 2022
Date

RECEIVED
Office of Oil and Gas
OCT 06 2022
WV Department of
Environmental Protection

4705100010P

CAMERON QUADRANGLE
WEST VIRGINIA-PENNSYLVANIA
7.5 MINUTE SERIES (TOPOGRAPHIC)
SE/4 CAMERON 15' QUADRANGLE

4963 IV NW
(WIND RIDGE)


39 32'30"

1710 000 FEET (W. VA.)

WAYNESBURG, PA. 23 MI.
GRAYSVILLE, PA. 8.4 MI.

542

80°30'
39°52'30"

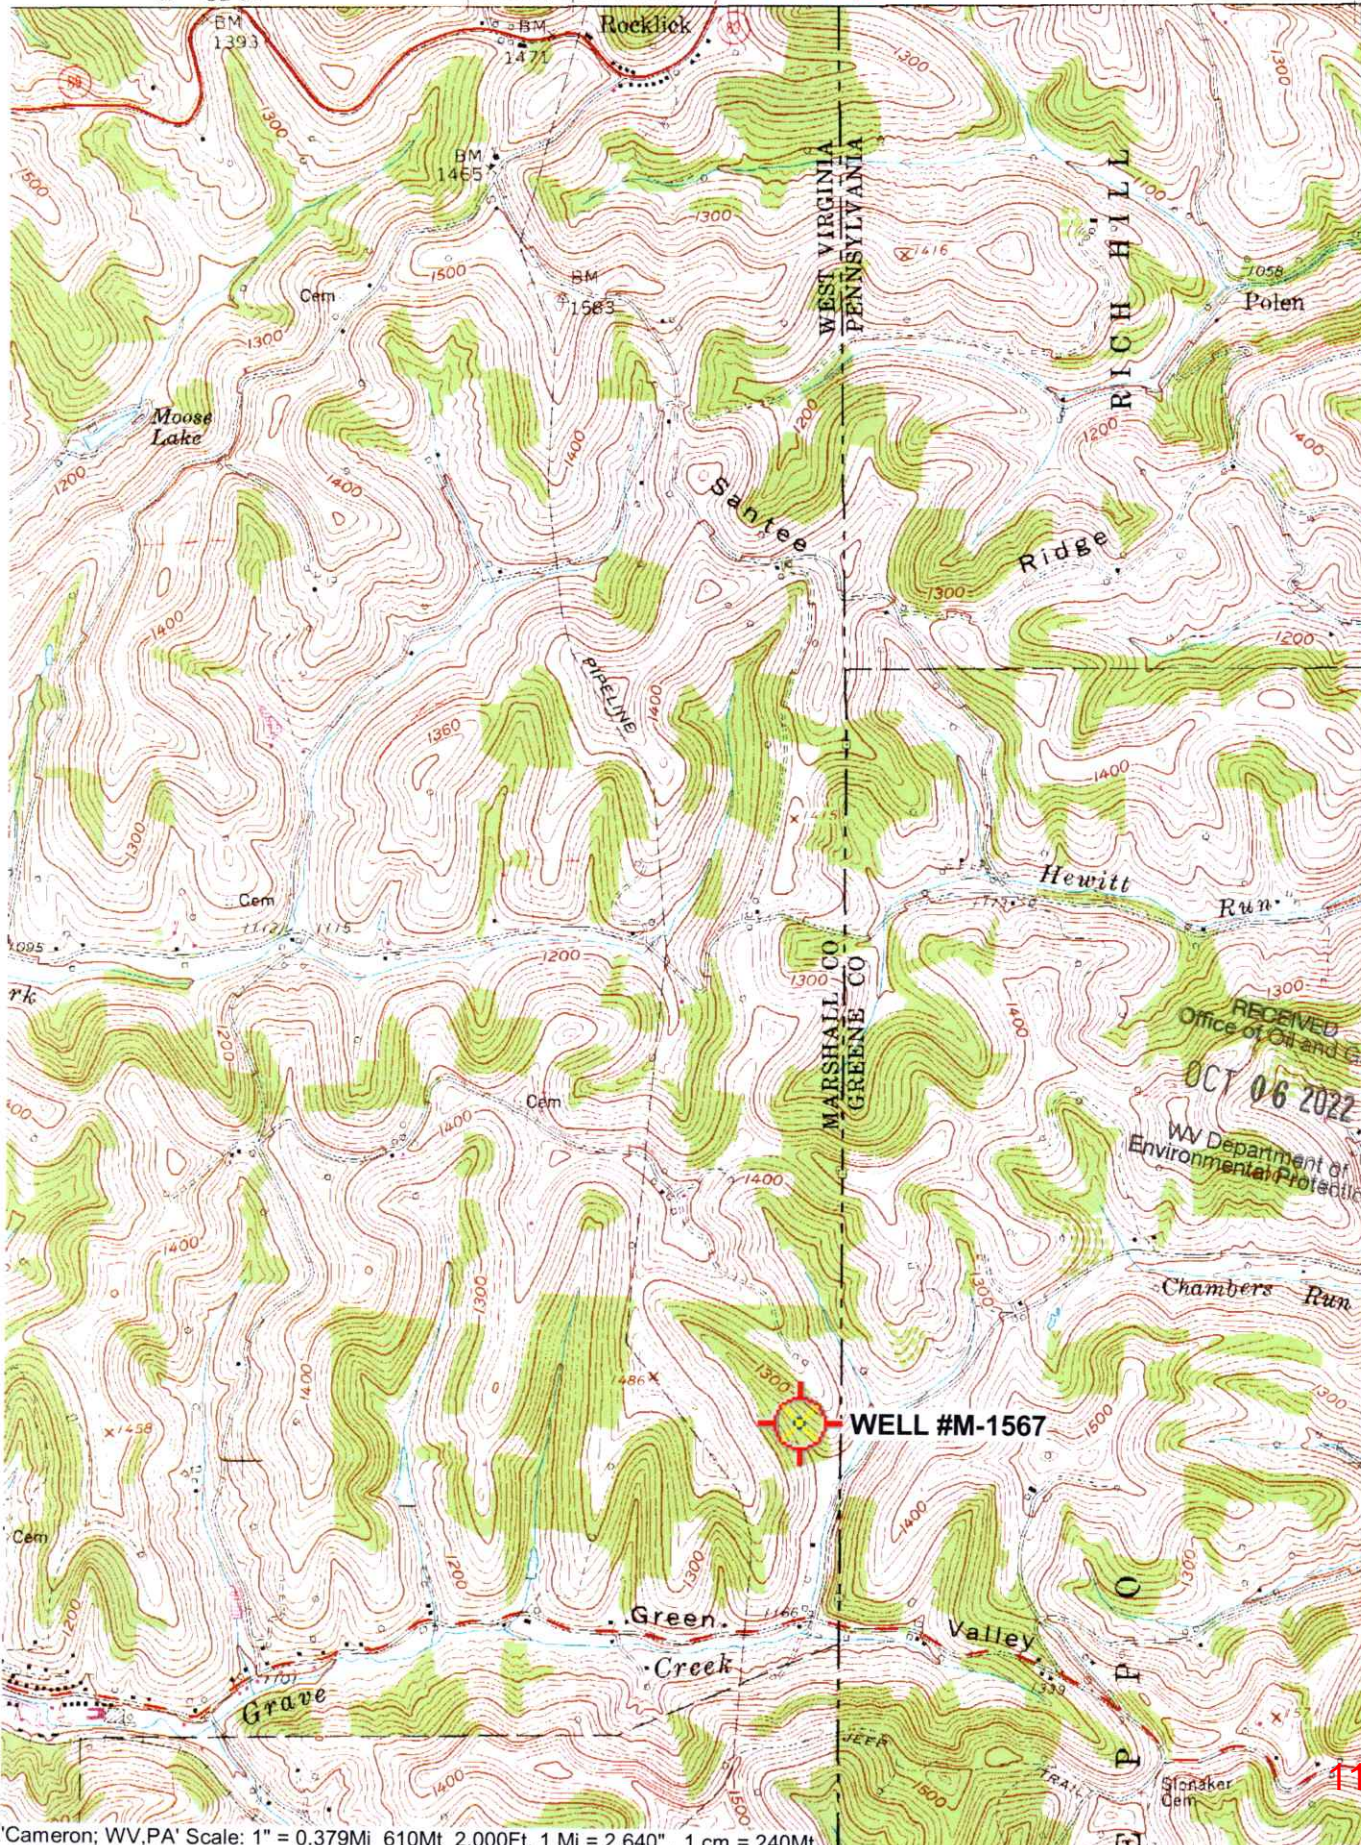

500 000 FEET
(W. VA.)

4412

4411

4410

50'

4409

4408

RECEIVED
Office of Oil and Gas
OCT 06 2022
WV Department of
Environmental Protection

WELL #M-1567

11/04/2022