WR-38
Rev. 5/08

API # 47-051-00162-00-00

STATE OF WEST VIRGINIA
DEPARTMENT OF ENVIRONMENTAL PROTECTION
OFFICE OF OIL AND GAS

AFFIDAVIT OF PLUGGING AND FILLING WELL

AFFIDAVIT SHOULD BE IN TRIPLICATE, one copy mailed to the Department, one copy to be retained by the Well Operator and the third copy (and extra copies if required) should be mailed to each coal operator at their respective addresses.

Farm name: Pyles, Vincent B. Operator Well No.: Victory B 3848

LOCATION: Elevation: 1170' Quadrangle: Littleton, WV
District: Meade County: Marshall
Latitude: 6465 Feet South of 39 Deg. 45 Min. 00 Sec.
Longitude: 3895 Feet West of 80 Deg. 35 Min. 30 Sec.

Well Type: OIL _____ GAS X

Company: Columbia Gas Transmission, LLC
1700 MacCorkle Avenue S.E., P.O. Box 1273
Charleston, WV 25325

Agent: Brad Nelson, Storage Engineer

Permit Issued Date: 12/29/2025

Coal Operator or Owner: Consol RCPC, LLC
275 Technology Drive, Suite 101
Canonsburg, PA 15317

Coal Operator or Owner: Marshall County Coal Resources, Inc.
46226 National Road West
St. Clairsville, OH 43950

AFFIDAVIT

STATE OF WEST VIRGINIA,
County of Marshall ss:

Brad Nelson and William Shoemaker being first duly sworn according to law depose and say that they are experienced in the work of plugging and filling oil and gas wells and were employed by the above named well operator, and participated in the work of plugging and filling the above well say that said work was commenced on the 3rd day of September, 2026, and the well was plugged and filled in the following manner:

TYPE	FROM	TO	PIPE REMOVED	LEFT
Class A Cement	0'	293'	N/A	7", 8-5/8", 10-3/4"
Class A Cement	293'	1427'	N/A	7", 8-5/8"
Class A Cement	1427'	1630'	N/A	7"
Cast Iron Bridge Plug (CIBP)	1630'	1633'	N/A	7"
Class A Cement	1633'	2043'	N/A	7"
Class A Cement	2043'	2274'	N/A	N/A

RECEIVED
Office Of Oil and Gas
OCT 13 2026
WV Department of
Environmental Protection

Description of monument: 7" diameter pipe, 4' above GL, API affixed and that the work of plugging and filling said well was completed on the 29th day of September, 2026.

And further deponents saith not. Brad Nelson / Will Shoemaker

Sworn and subscribe before me this 6th day of October, 2026

Commonwealth of Pennsylvania - Notary Seal
EMILY KALE LEACH, Notary Public
Washington County
My Commission Expires November 18, 2027
Commission Number 1359854

My commission expires: 11/18/2027


Emily Leach
Notary Public

Affidavit reviewed by the Office of Oil and Gas: Strader Gower Title: Oil & Gas Inspector

10/23/2026

~ not to scale ~

Victory B 3848
API 47-051-00162
Post P&A
(as of 9/30/2026)

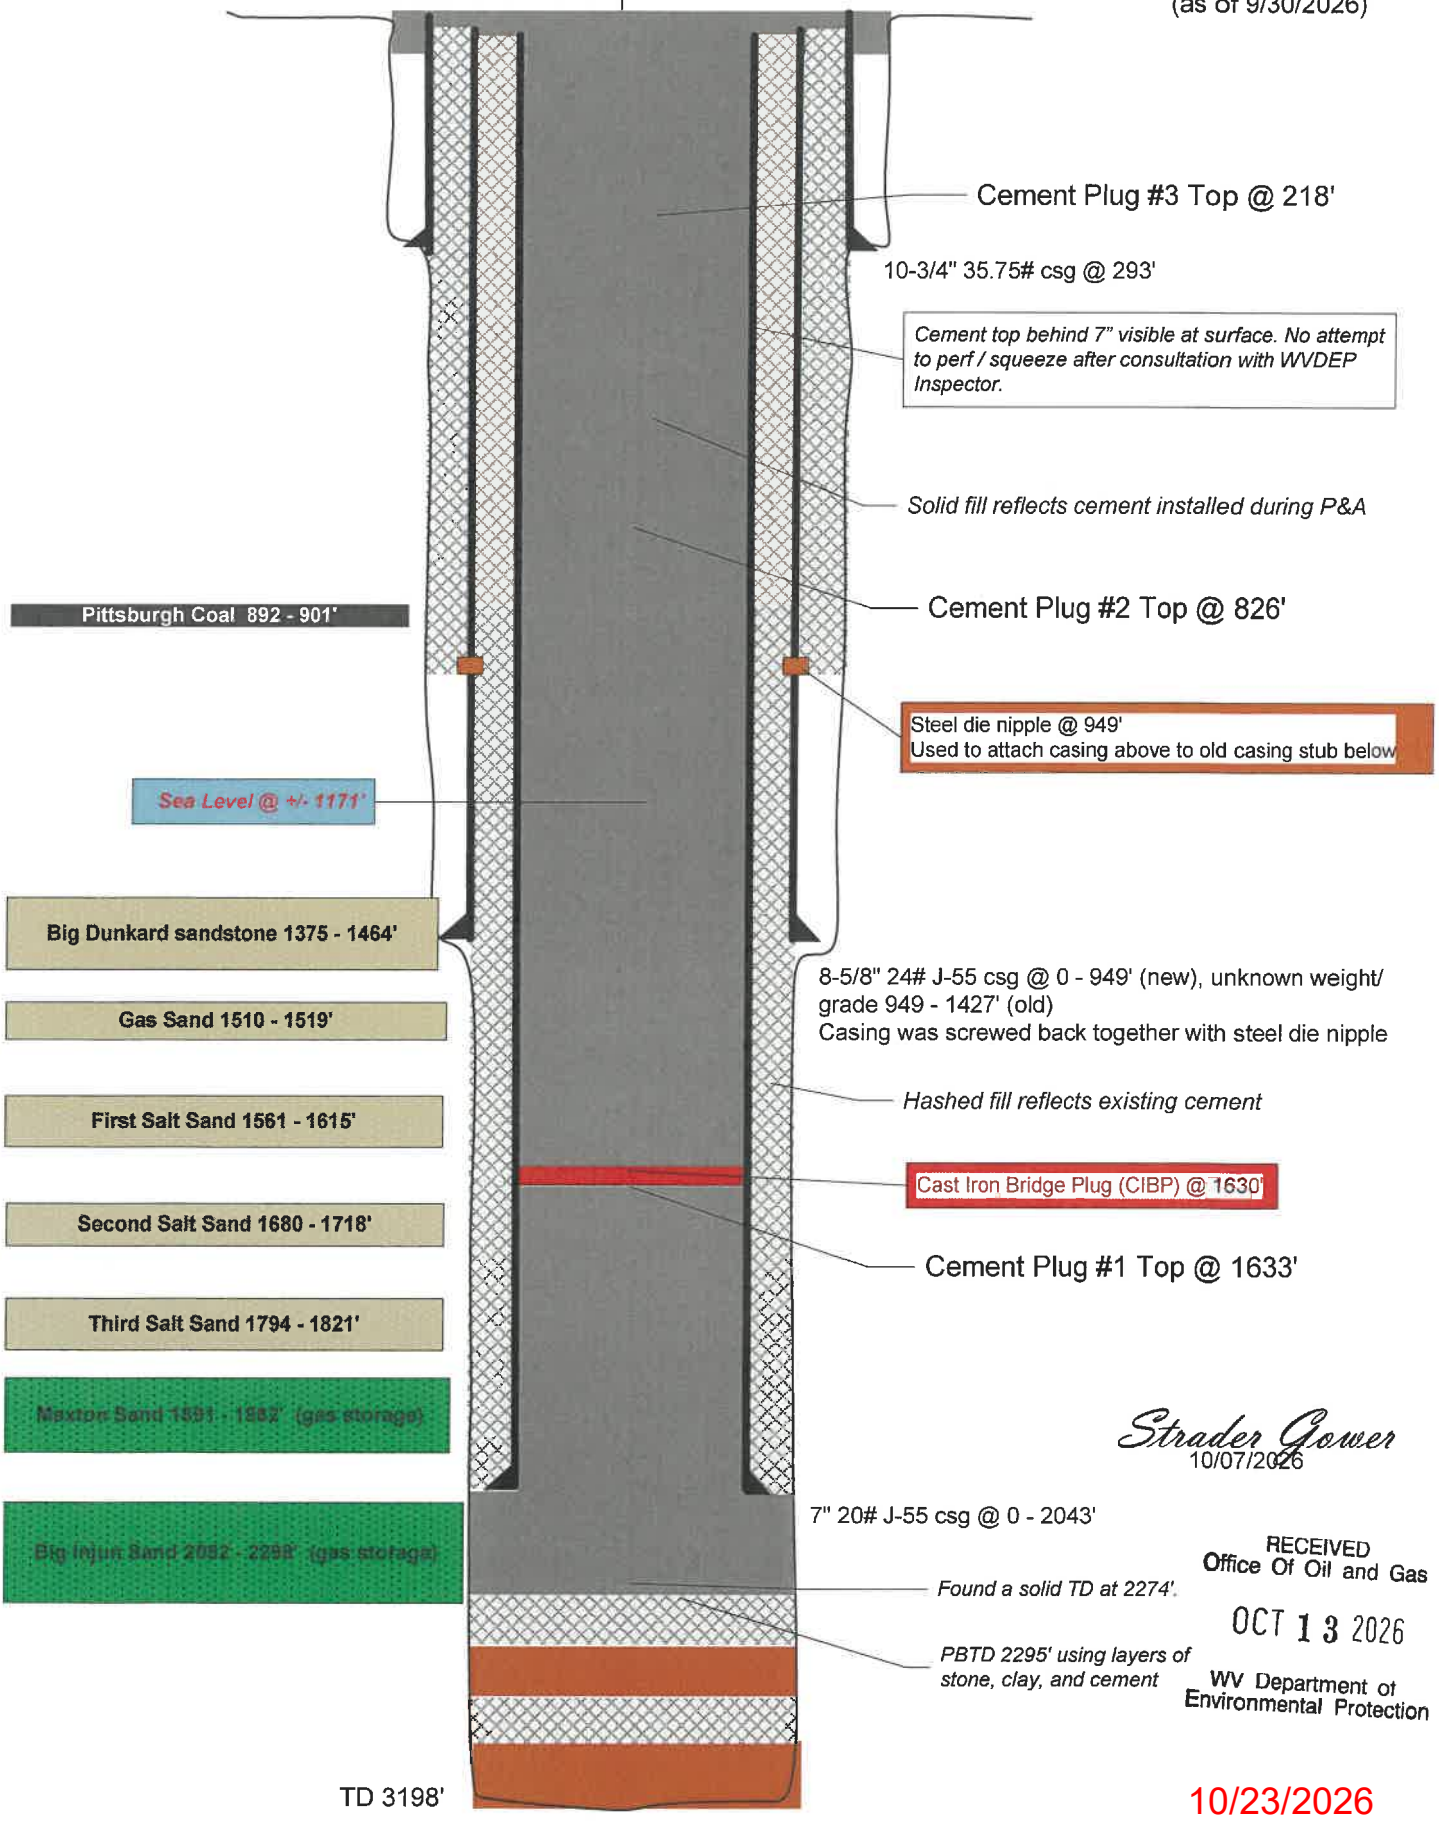


Strader Gower
10/07/2026

RECEIVED
Office Of Oil and Gas
OCT 13 2026
WV Department of
Environmental Protection

10/23/2026

~ not to scale ~

Victory B 3848
API 47-051-00162
Prior to P&A
(as of 2/28/24)

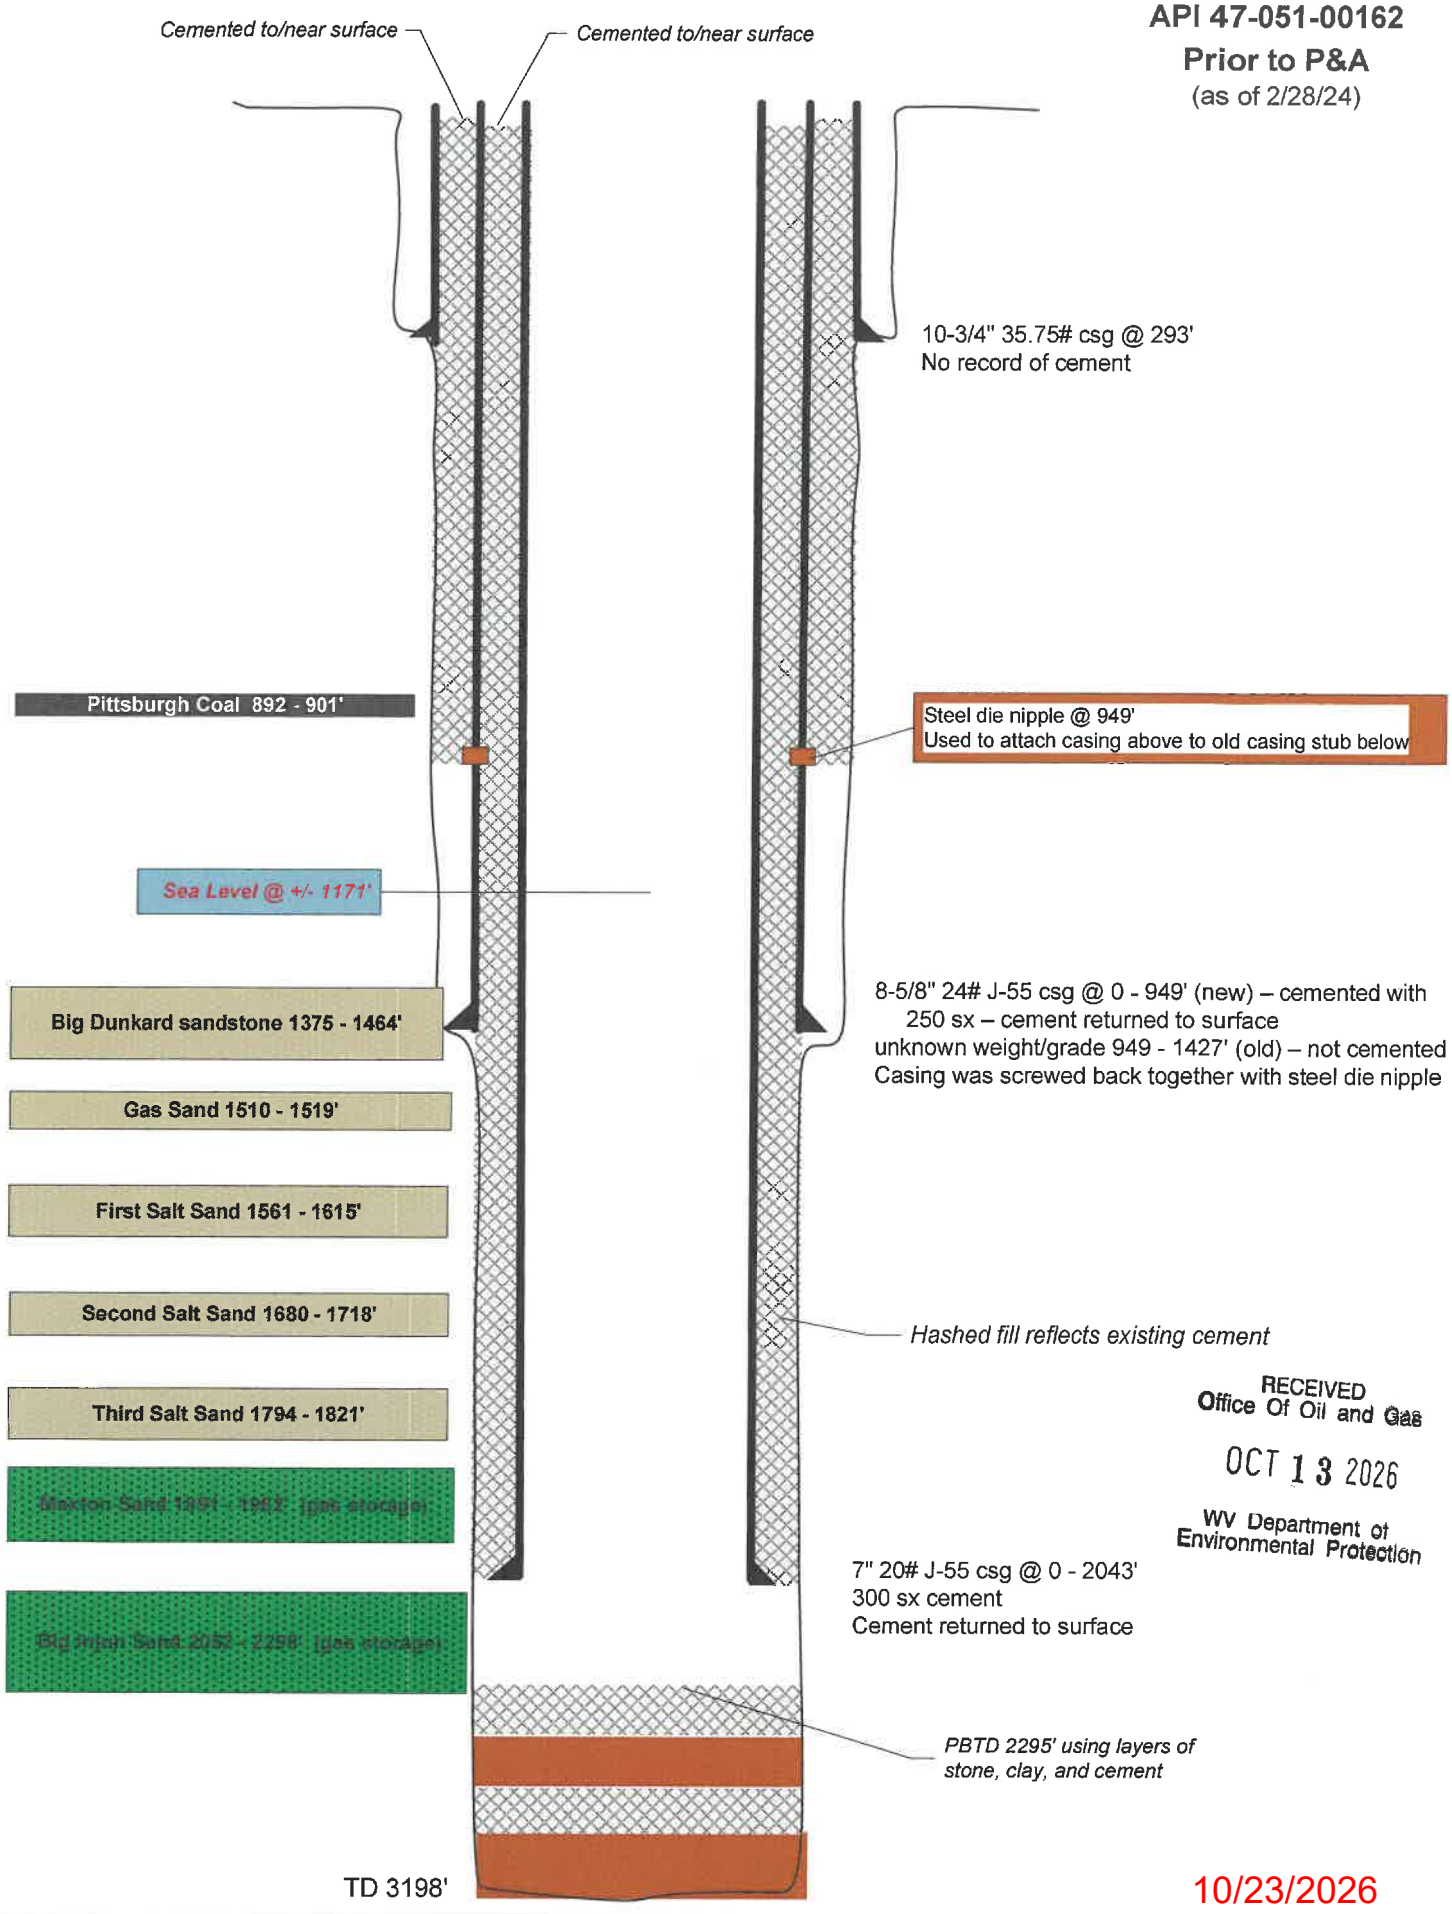

RECEIVED
Office Of Oil and Gas
OCT 13 2026
WV Department of
Environmental Protection

10/23/2026