

**WVDEP Reclamation Plan Site Overview / Detail**  
 Victory B 4480 (API # 47-051-00315-00-00)


- BMP's and erosion control devices to be utilized per WVDEP guidelines and Columbia's WV Environmental Construction Standards.
- Existing drainage, culverts, and road ditches to be maintained.
- Minor grading and surface material to be applied as needed.

47-051-00315P

GLEN EASTON

CAMERON

NEW FREEPORT

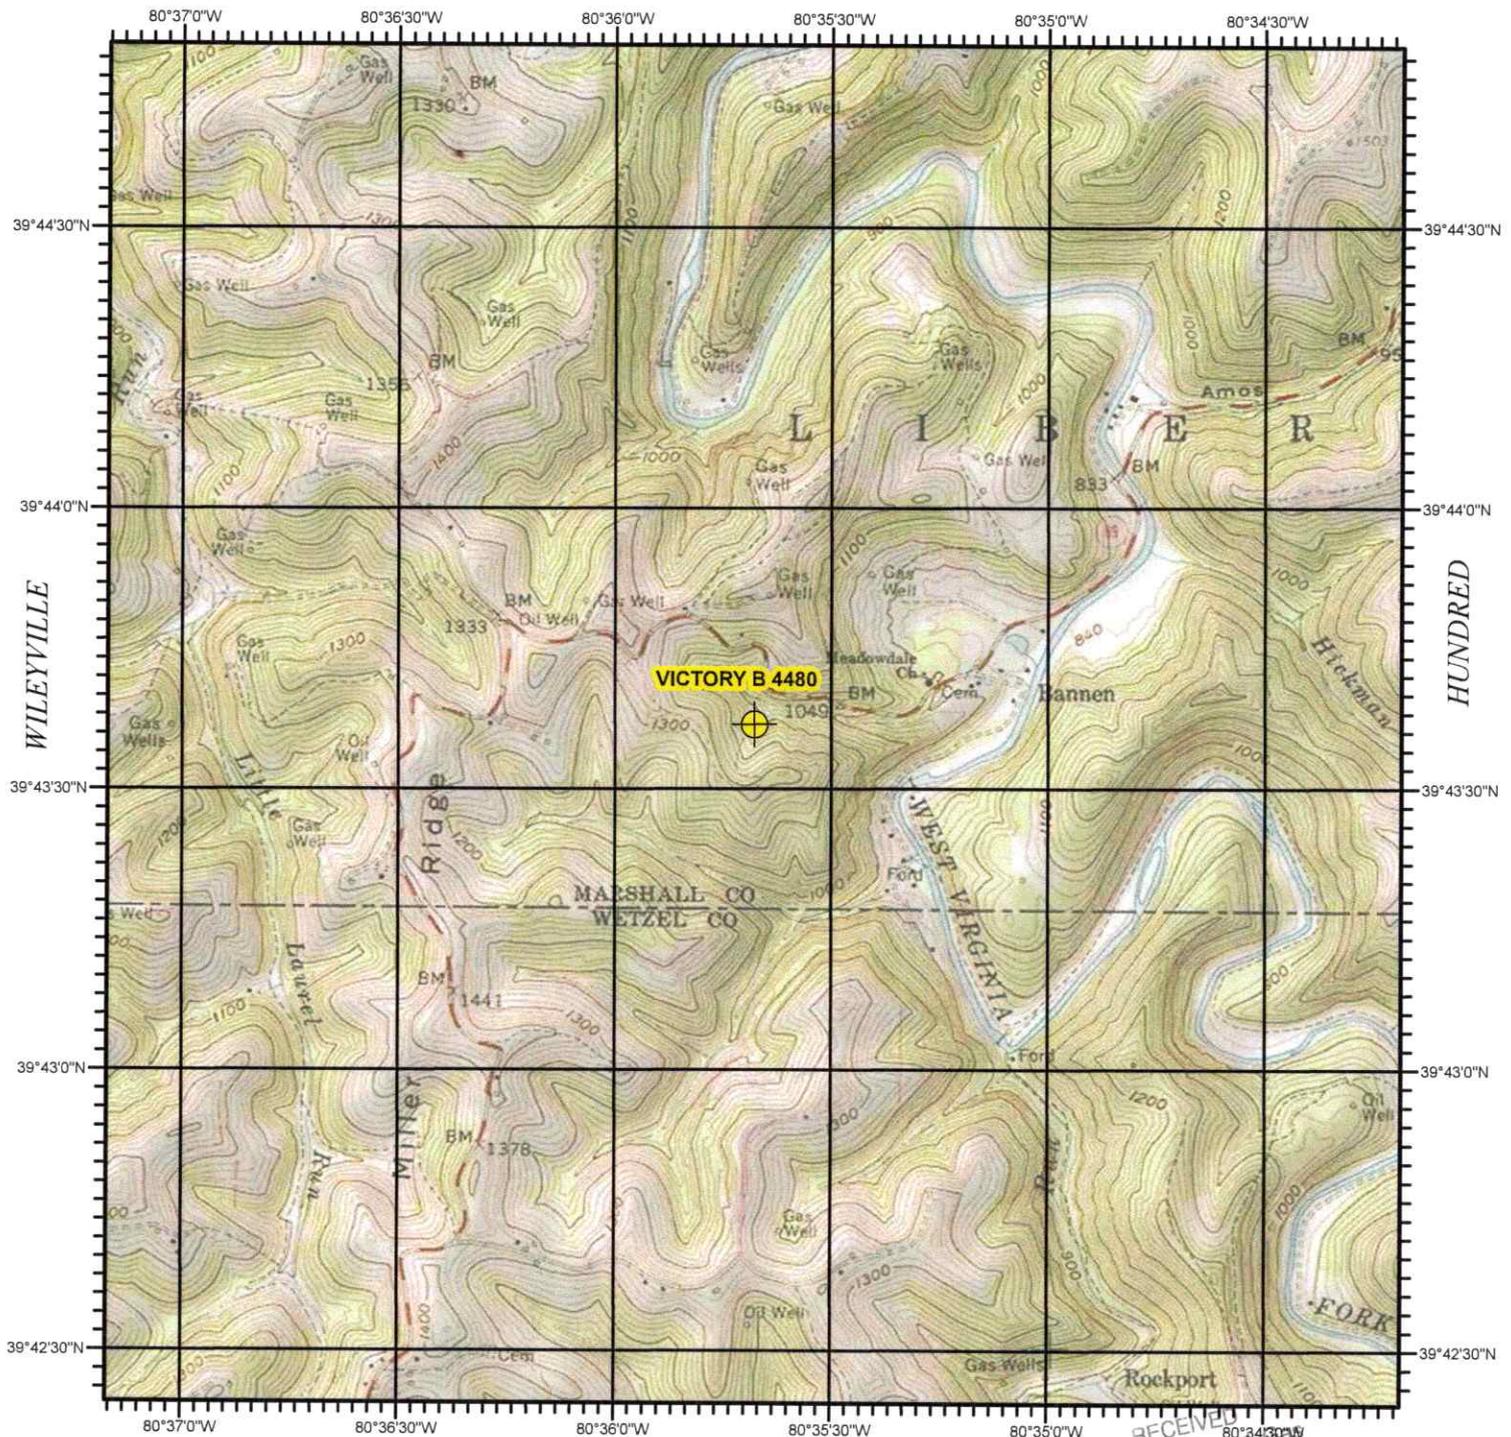

VICTORY B 4480



PINE GROVE

BIG RUN

RECEIVED  
Office of Oil and Gas




GLOVER GAP

FEB 05 2026

WV Department of  
Environmental Protection



**VICTORY B 4480**  
**MARSHALL COUNTY, WV**

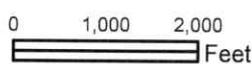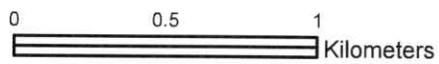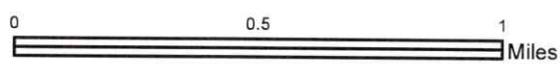

SCALE 1:24,000

USGS TOPOGRAPHIC QUADRANGLE  
LITTLETON, WV - 1976  
North American 1983 Datum (NAD83)

02/27/2026

WW-7  
8-30-06



West Virginia Department of Environmental Protection  
Office of Oil and Gas  
**WELL LOCATION FORM: GPS**

API: 47-051-00315-00-00 WELL NO.: Victory B 4480

FARM NAME: PARROTT, W.

RESPONSIBLE PARTY NAME: Columbia Gas Transmission, LLC

COUNTY: Marshall DISTRICT: Liberty

QUADRANGLE: Littleton

SURFACE OWNER: Joseph L. Schanck

ROYALTY OWNER: Joseph D. Parriott, Agent

UTM GPS NORTHING: 4,397,527.232

UTM GPS EASTING: 534,739.959 GPS ELEVATION: 1,142'

The Responsible Party named above has chosen to submit GPS coordinates in lieu of preparing a new well location plat for a plugging permit or assigned API number on the above well. The Office of Oil and Gas will not accept GPS coordinates that do not meet the following requirements:

- Datum: NAD 1983, Zone: 17 North, Coordinate Units: meters, Altitude: height above mean sea level (MSL) – meters.
- Accuracy to Datum – 3.05 meters
- Data Collection Method:

Survey grade GPS  : Post Processed Differential

Real-Time Differential

Mapping Grade GPS  : Post Processed Differential

Real-Time Differential

- Letter size copy of the topography map showing the well location.**

I the undersigned, hereby certify this data is correct to the best of my knowledge and belief and shows all the information required by law and the regulations issued and prescribed by the Office of Oil and Gas.

*Paul Nelson*  
Signature

Storage Engineer  
Title

1/16/2026  
Date

RECEIVED  
Office of Oil and Gas  
FEB 05 2026  
WV Department of  
Environmental Protection