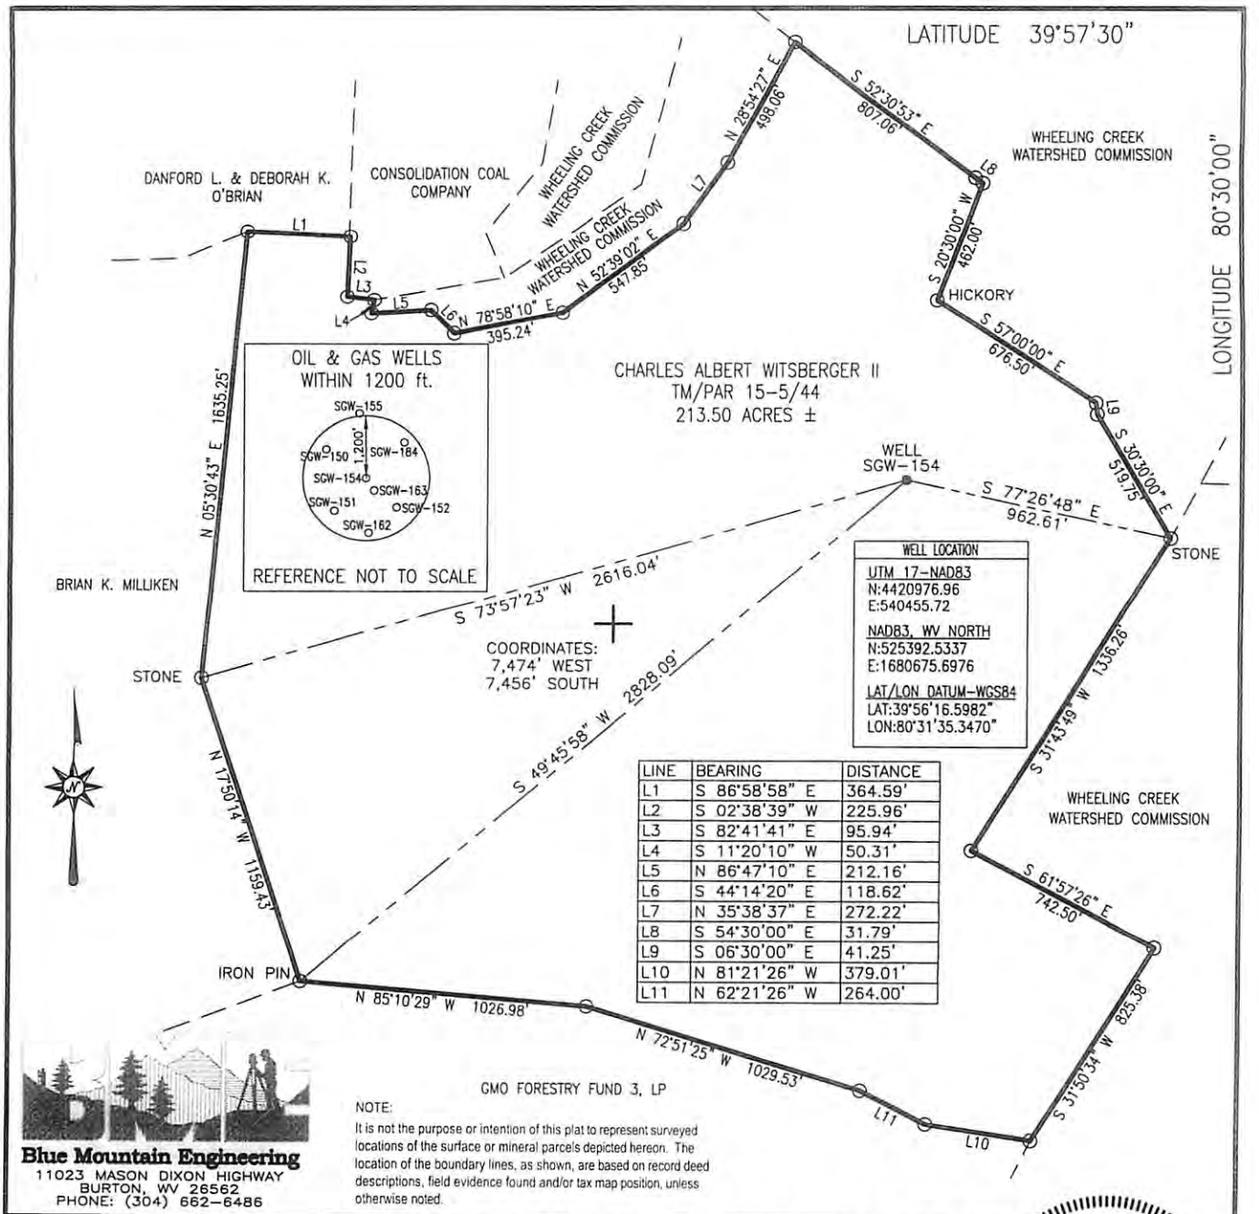

LINE	BEARING	DISTANCE
L1	S 86°58'58" E	364.59'
L2	S 02°38'39" W	225.96'
L3	S 82°41'41" E	95.94'
L4	S 11°20'10" W	50.31'
L5	N 86°47'10" E	212.16'
L6	S 44°14'20" E	118.62'
L7	N 35°38'37" E	272.22'
L8	S 54°30'00" E	31.79'
L9	S 06°30'00" E	41.25'
L10	N 81°21'26" W	379.01'
L11	N 62°21'26" W	264.00'

Blue Mountain Engineering
11023 MASON DIXON HIGHWAY
BURTON, WV 26562
PHONE: (304) 662-6486

NOTE:
It is not the purpose or intention of this plat to represent surveyed locations of the surface or mineral parcels depicted hereon. The location of the boundary lines, as shown, are based on record deed descriptions, field evidence found and/or tax map position, unless otherwise noted.

FILE #: SGW-154
DRAWING #: SGW-154
SCALE: 1" = 600'
MINIMUM DEGREE OF ACCURACY: 1/2500
PROVEN SOURCE OF ELEVATION: U.S.G.S. MONUMENT THOMAS 1498.81'

I, THE UNDERSIGNED, HEREBY CERTIFY THAT THIS PLAT IS CORRECT TO THE BEST OF MY KNOWLEDGE AND BELIEF AND SHOWS ALL THE INFORMATION REQUIRED BY LAW AND THE REGULATIONS ISSUED AND PRESCRIBED BY THE DEPARTMENT OF ENVIRONMENTAL PROTECTION.

Signed: _____
R.P.E.: _____ L.L.S.: P.S. No. 2000

GEORGE D. SIX LICENSED No. 2000 STATE OF WEST VIRGINIA PROFESSIONAL SURVEYOR

PLACE SEAL HERE

(+) DENOTES LOCATION OF WELL ON UNITED STATES TOPOGRAPHIC MAPS
WVDEP
OFFICE OF OIL & GAS
601 57TH STREET
CHARLESTON, WV 25304

DATE: OCTOBER 4, 2012
OPERATOR'S WELL #: SGW-154
API WELL #: 47 (STATE) 51 (COUNTY) 00342 (PERMIT)

Well Type: ☐ Oil ☐ Waste Disposal ☐ Production ☐ Deep ☐ Gas ☐ Liquid Injection ☐ Storage ☒ Shallow

WATERSHED: UNNAMED TRIBUTARY TO DUNKARD FORK ELEVATION: 1231.76'
COUNTY/DISTRICT: MARSHALL/WEBSTER QUADRANGLE: MAJORSVILLE, WV-PA 7.5'
SURFACE OWNER: CHARLES ALBERT WITSBERGER II ACREAGE: 213.50±
OIL & GAS ROYALTY OWNER: _____ ACREAGE: _____

DRILL ☐ CONVERT ☐ DRILL DEEPER ☐ REDRILL ☐ FRACTURE OR STIMULATE ☐
PLUG OFF OLD FORMATION ☐ PERFORATE NEW FORMATION ☐ PLUG & ABANDON ☒
CLEAN OUT & REPLUG ☐ OTHER CHANGE ☐ (SPECIFY): _____

TARGET FORMATION: NONE ESTIMATED DEPTH: _____

WELL OPERATOR CONSOLIDATION COAL CO., OHIO VALLEY OPERATIONS
Address 6126 ENERGY DRIVE
City MOUNDSVILLE State WV Zip Code 26041

DESIGNATED AGENT MICHELE O'NEIL
Address 6126 ENERGY DRIVE
City MOUNDSVILLE State WV Zip Code 26041

12/07/2012

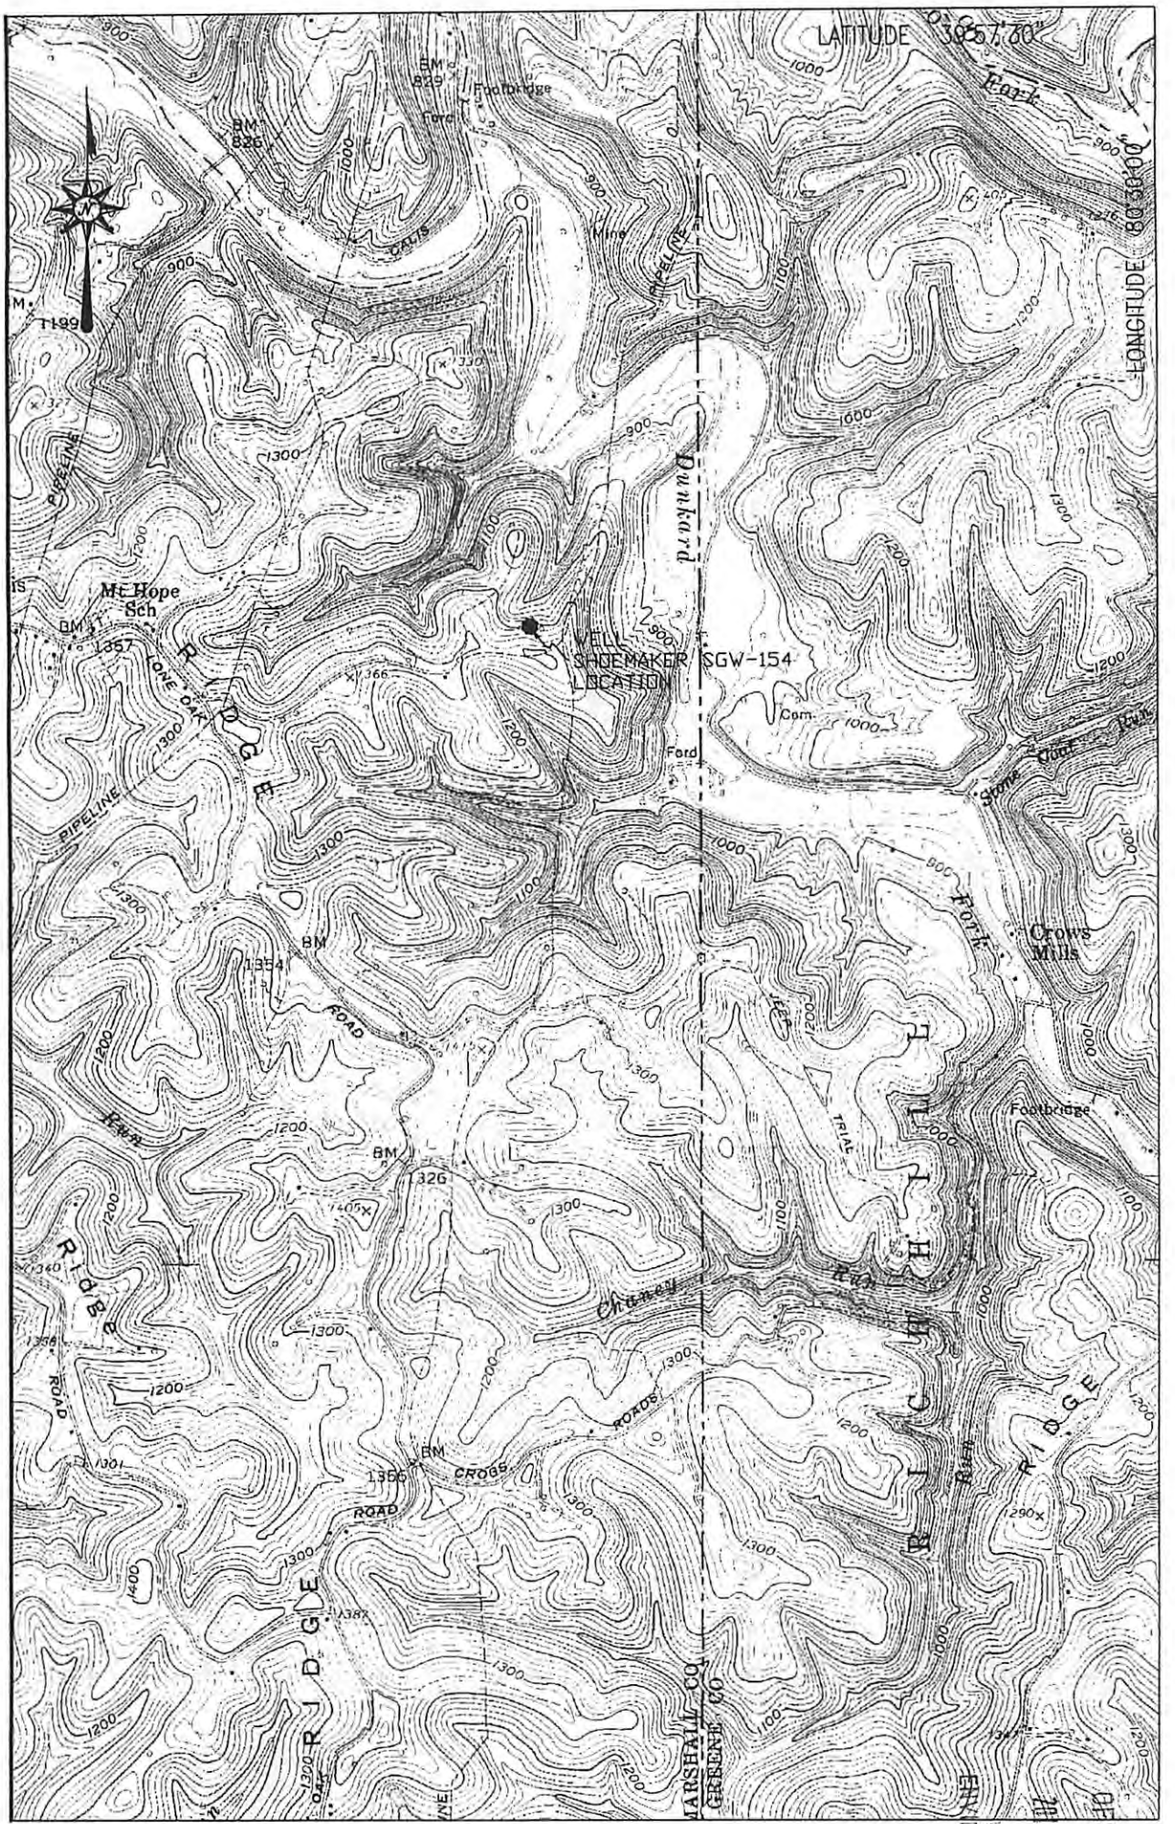

Blue Mountain Engineering
11023 MASON DIXON HIGHWAY
BURTON, WV 26562
PHONE: (304) 662-6486

SHOEMAKER WELL # SGW-154
MAJORSVILLE QUADRANGLE
WEST VIRGINIA – PENNSYLVANIA

LOCATION MAP

OCTOBER 4, 2012

SCALE 1" = 2000'

0' 2000' 4000' 6000'

RECEIVED
OFFICE OF OIL & GAS
2012 NOV 21 P 1:12
ENVIRONMENTAL PROTECTION

BLUE MOUNTAIN ENGINEERING

12/07/2012