



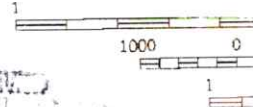

Mapped, edited, and published by the Geological Survey
 Control by USGS and USC&GS
 Topography from aerial photographs by photogrammetric methods
 Aerial photographs taken 1956. Field check 1960
 Polyconic projection. 1927 North American datum
 10,000-foot grids based on West Virginia coordinate system,
 north zone, and Pennsylvania coordinate system, south zone
 1000 meter Universal Transverse Mercator grid ticks
 'Cameron; WV,PA' Scale: 1" = 0.379Mi 610Mt 2,000Ft, 1 Mi = 2,640' , 1 cm = 240Mt

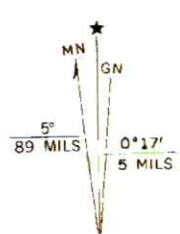

MAR 3 2026
 04/17/2026

ILEYVILLE
 4863 II NW

WW-7
8-30-06



West Virginia Department of Environmental Protection
Office of Oil and Gas

WELL LOCATION FORM: GPS

API: 47-051-00391 WELL NO.: M-2103

FARM NAME: J. N. Quigley

RESPONSIBLE PARTY NAME: West Virginia Land Resources INC

COUNTY: Marshall DISTRICT: Liberty

QUADRANGLE: Cameron WV, PA

SURFACE OWNER: Larry C. Williams ET UX

ROYALTY OWNER: _____

UTM GPS NORTHING: 4,404,166 m

UTM GPS EASTING: 535,672 m GPS ELEVATION: 354 m

The Responsible Party named above has chosen to submit GPS coordinates in lieu of preparing a new well location plat for a plugging permit or assigned API number on the above well. The Office of Oil and Gas will not accept GPS coordinates that do not meet the following requirements:

- Datum: NAD 1983, Zone: 17 North, Coordinate Units: meters, Altitude: height above mean sea level (MSL) – meters.
- Accuracy to Datum – 3.05 meters
- Data Collection Method:

Survey grade GPS : Post Processed Differential _____


Real-Time Differential

Mapping Grade GPS _____ : Post Processed Differential _____

Real-Time Differential _____

- Letter size copy of the topography map showing the well location.**

I the undersigned, hereby certify this data is correct to the best of my knowledge and belief and shows all the information required by law and the regulations issued and prescribed by the Office of Oil and Gas.

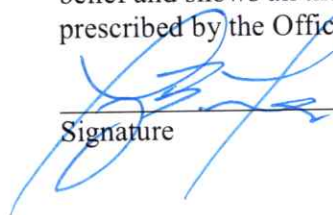

Signature

PS2002

Title
MAR 3 2026

2/5/2026
Date

04/17/2026