WR-38
Rev. 5/08

API # 47-051-00507-00-00

STATE OF WEST VIRGINIA
DEPARTMENT OF ENVIRONMENTAL PROTECTION
OFFICE OF OIL AND GAS

AFFIDAVIT OF PLUGGING AND FILLING WELL

AFFIDAVIT SHOULD BE IN TRIPLICATE, one copy mailed to the Department, one copy to be retained by the Well Operator and the third copy (and extra copies if required) should be mailed to each coal operator at their respective addresses.

Farm name: Evans, Clell Operator Well No.: Victory B 4798

LOCATION: Elevation: 893' Quadrangle: Cameron, WV
District: Liberty County: Marshall
Latitude: 1140 Feet South of 39 Deg. 45 Min. 00 Sec.
Longitude: 10730 Feet West of 80 Deg. 35 Min. 00 Sec.

Well Type: OIL _____ GAS X

Company: Columbia Gas Transmission, LLC
1700 MacCorkle Avenue S.E., P.O. Box 1273
Charleston, WV 25325

Agent: Brad Nelson, Storage Engineer
Permit Issued Date: 5/4/2026

Coal Operator or Owner: Consol RCPC, LLC
275 Technology Drive, Suite 101
Canonsburg, PA 15317

Coal Operator or Owner: Marshall County Resources, Inc.
46226 National Road West
St. Clairsville, OH 43950

AFFIDAVIT

STATE OF WEST VIRGINIA,
County of Marshall ss:

Brad Nelson and Garrett Miller being first duly sworn according to law depose and say that they are experienced in the work of plugging and filling oil and gas wells and were employed by the above named well operator, and participated in the work of plugging and filling the above well say that said work was commenced on the 7th day of October, 2026, and the well was plugged and filled in the following manner:

TYPE	FROM	TO	PIPE REMOVED	LEFT
Class A Cement	0'	31'	N/A	5-1/2", 8-5/8", 13-3/8"
Class A Cement	31'	615'	N/A	5-1/2", 8-5/8"
Class A Cement	615'	635'	5-1/2" (section milled)	8-5/8"
Class A Cement	635'	660'	N/A	5-1/2", 8-5/8"
Class A Cement	660	1331'	N/A	5-1/2"
Cast Iron Bridge Plug (CIBP)	1331'	1337'	N/A	5-1/2"
Class A Cement	1337'	1985'	N/A	5-1/2"

Description of monument: 7" diameter pipe, 4' above GL, API affixed and that the work of plugging and filling said well was completed on the 19th day of October, 2026.

And further deponents saith not.

Brad Nelson
D. [illegible]

Commonwealth of Pennsylvania - Notary Seal
Susanne Dellere, Notary Public
Washington County
My commission expires January 15, 2029
Commission number 1382332
Member, Pennsylvania Association of Notaries

Sworn and subscribe before me this 19th day of OCTOBER, 2026

My commission expires: 1/15/2029

Susanne Dellere
Notary Public

Affidavit reviewed by the Office of Oil and Gas: Strader Gower 10/21/2026 Title: Oil & Gas Inspector 10/30/2026

~ not to scale ~

Victory B 4798
API 47-051-00507
Post P&A
(as of 10/21/2026)

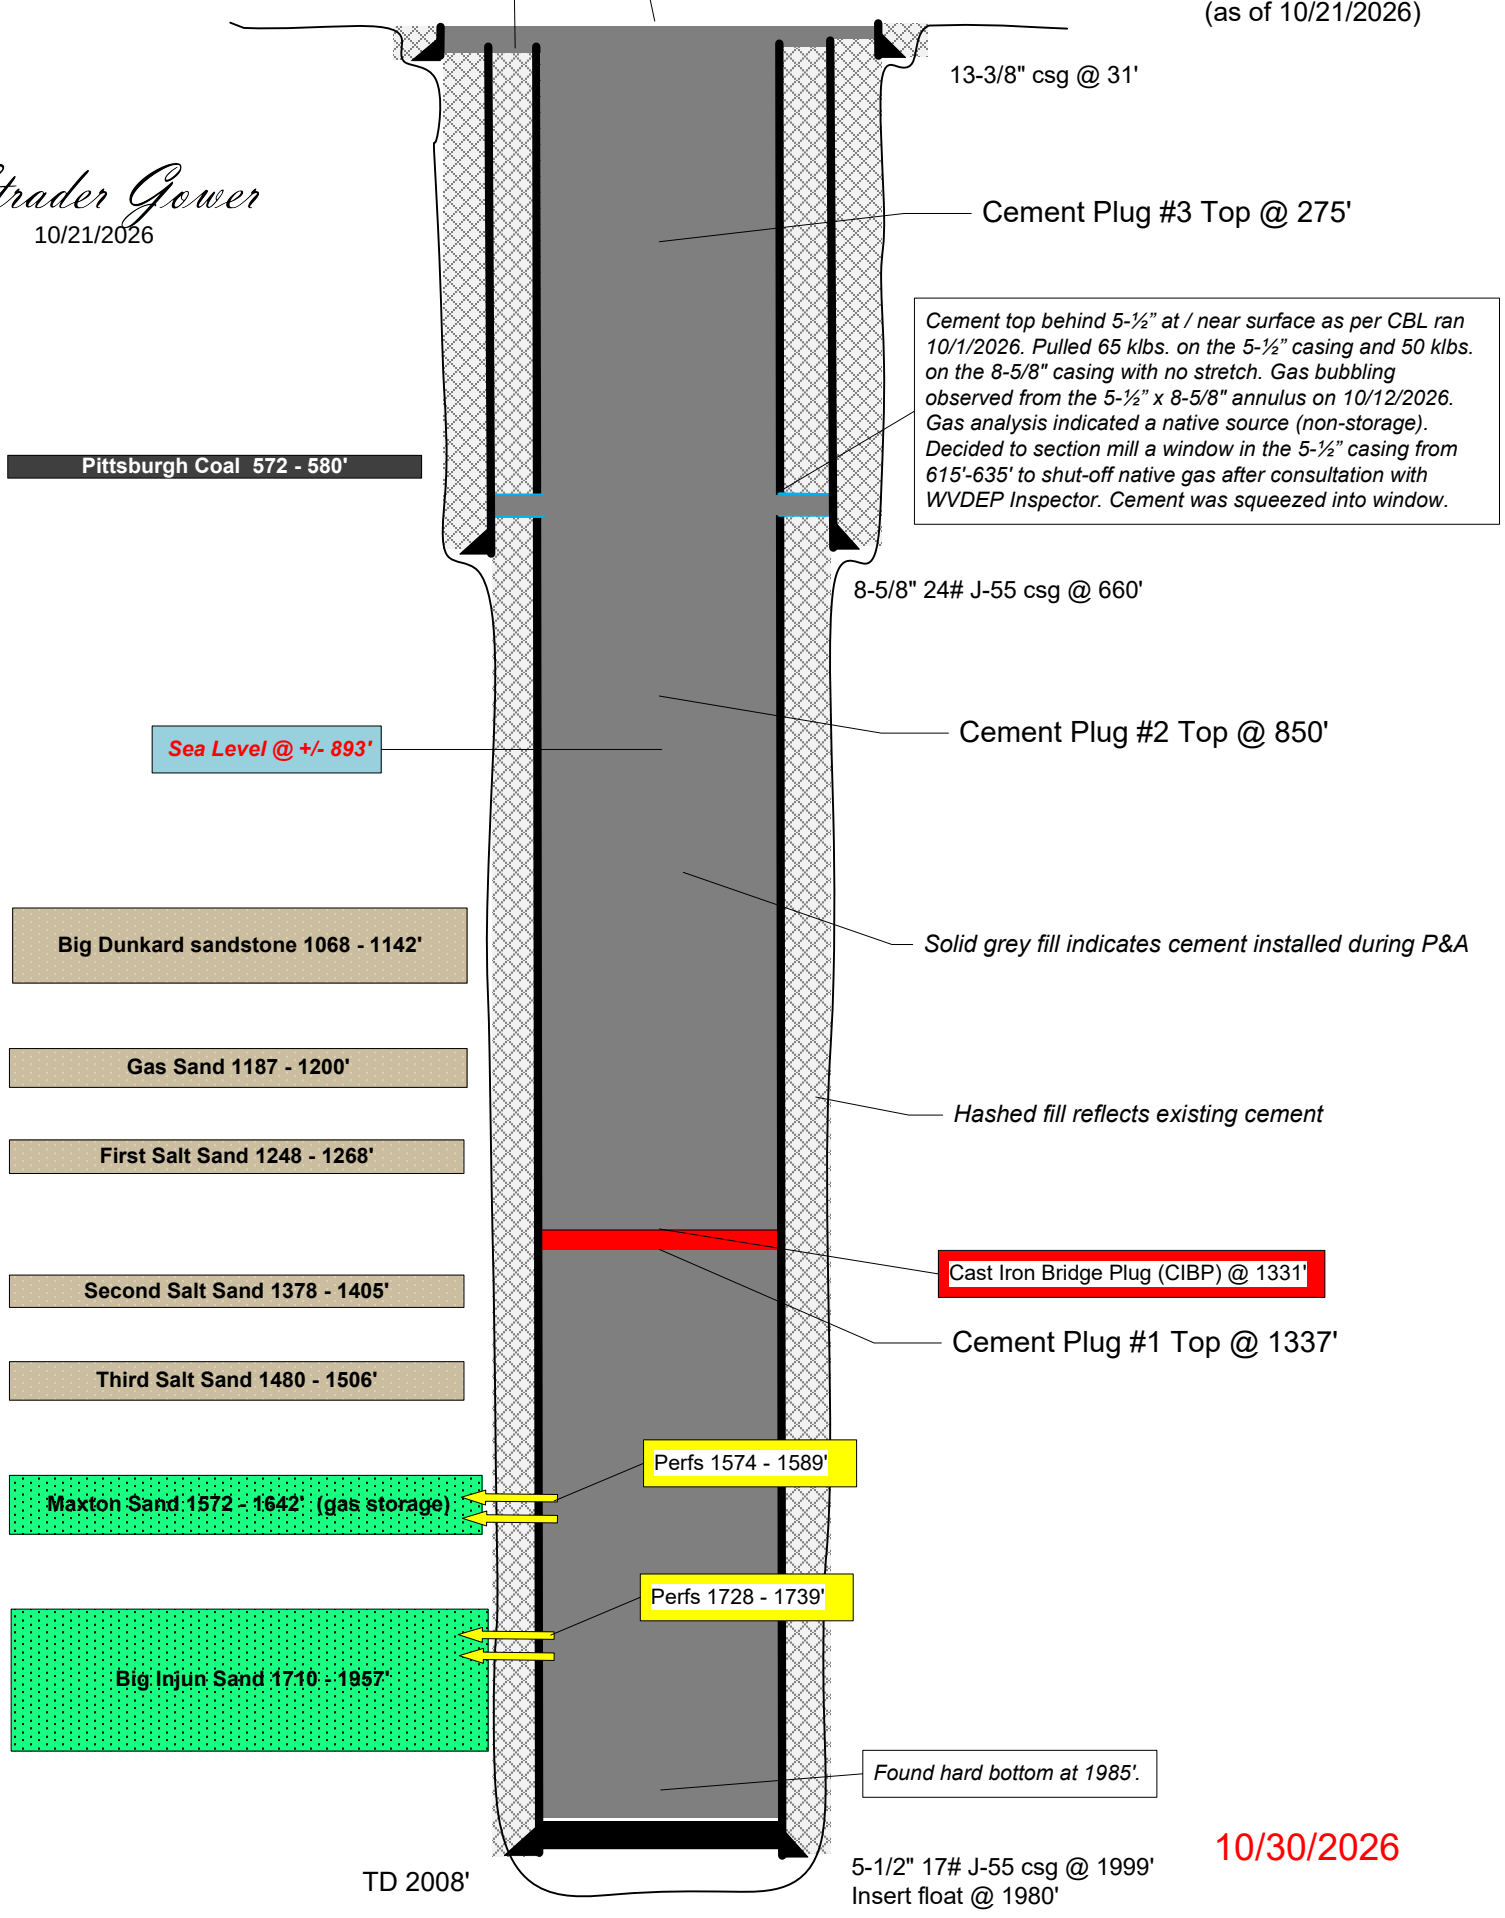

10/30/2026