


47051005 80P
Chambers 02/10/2023

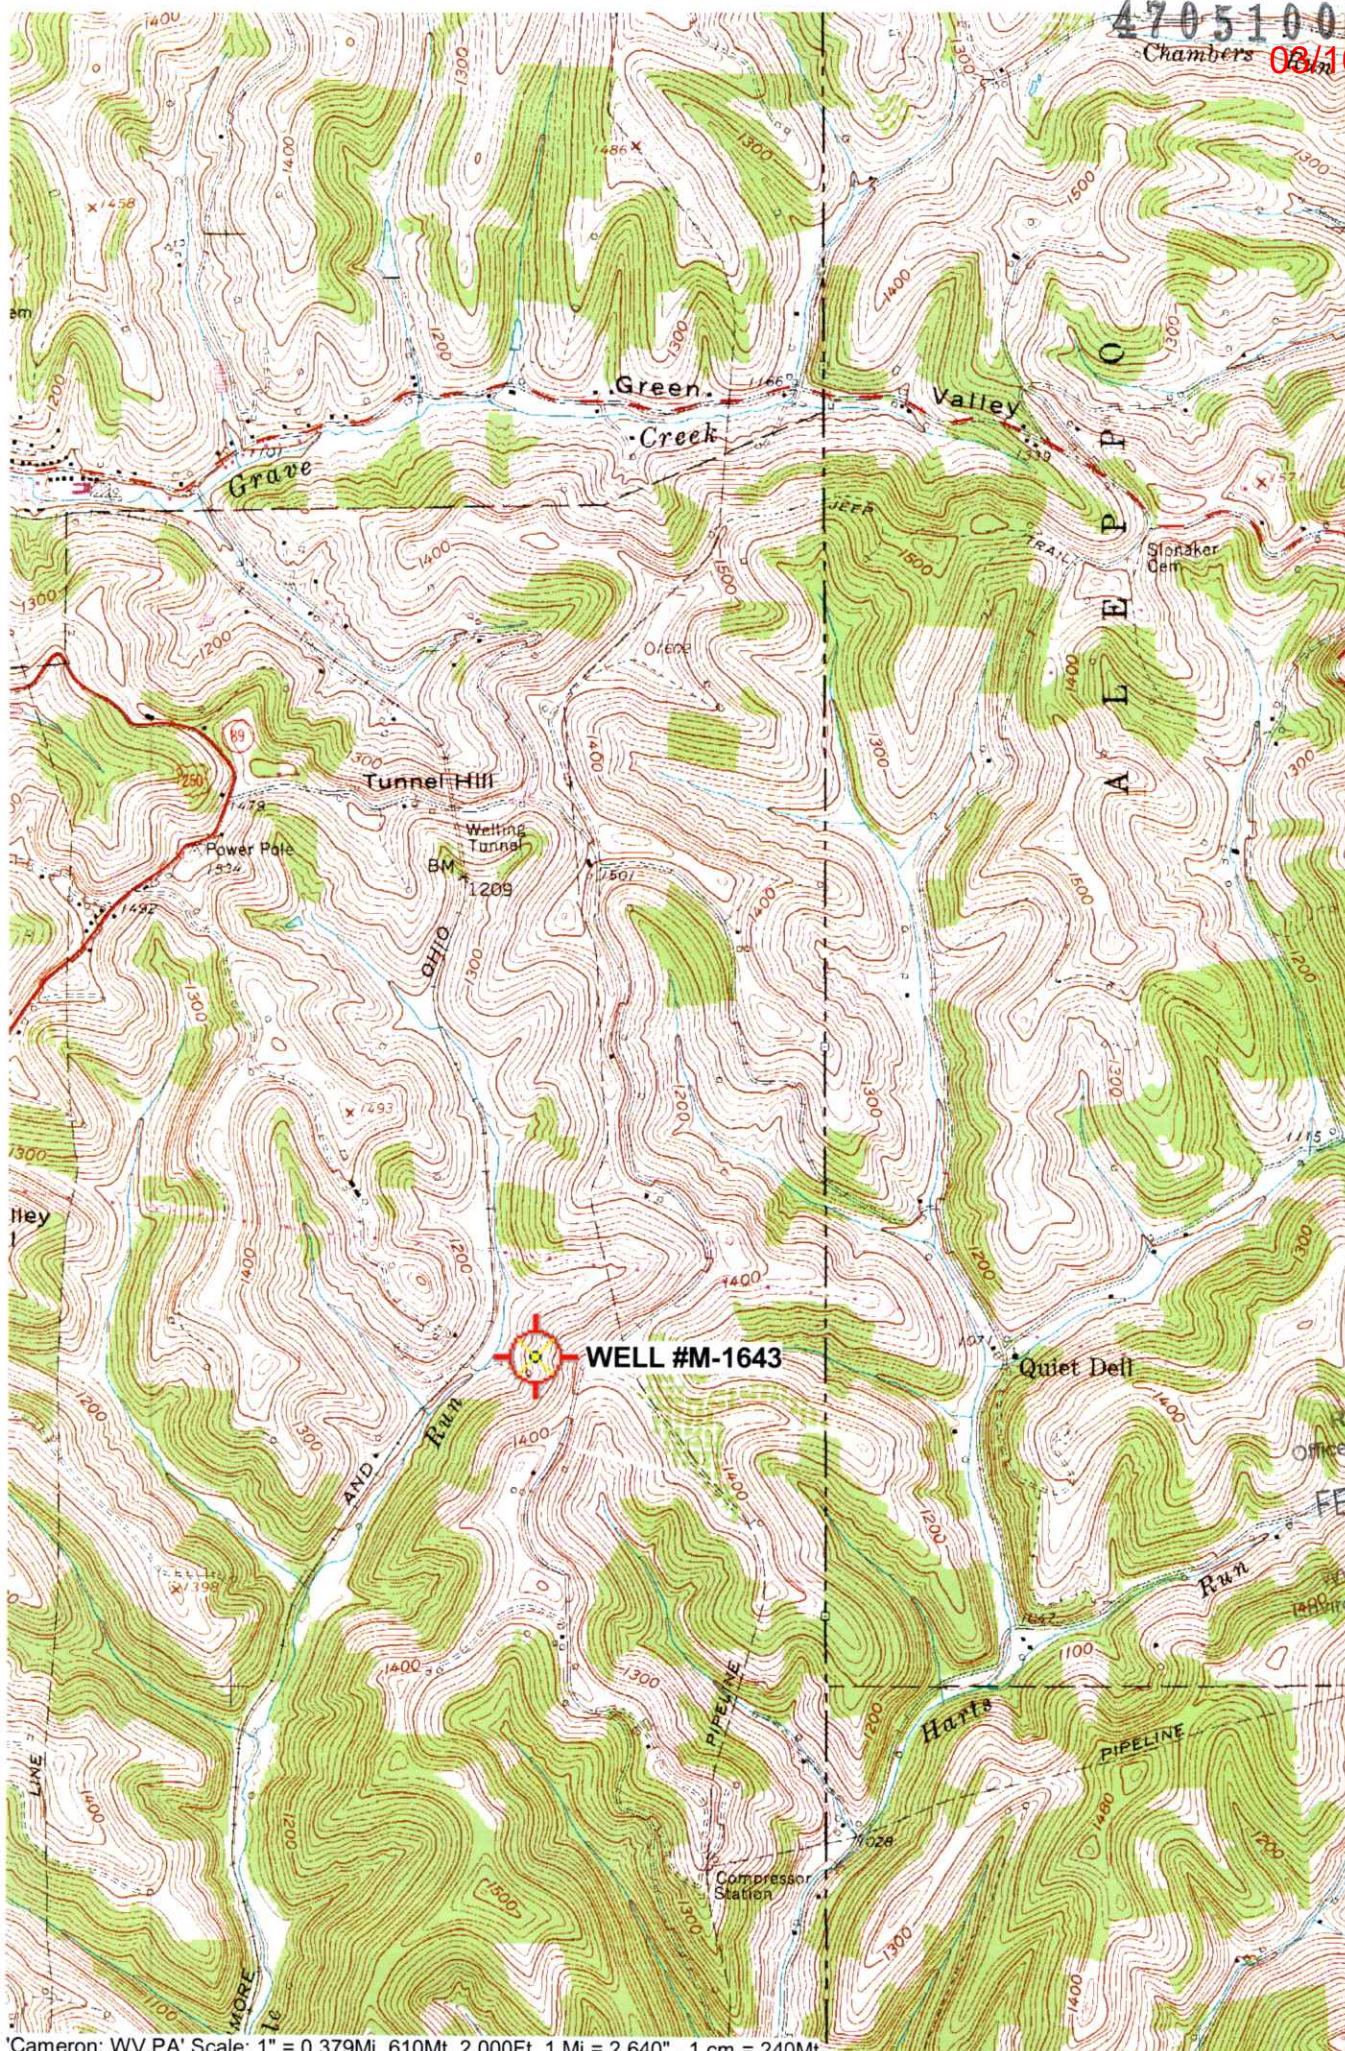

50'
4409
4408
4406
4405
47'30"
4404

(NEW FREEPORT)
4963 IV SW

RECEIVED
Office of Oil and Gas
FEB 17 2023
Department of
Environmental Protection

4705100580P 03/10/2023

WW-7
8-30-06



West Virginia Department of Environmental Protection
Office of Oil and Gas

WELL LOCATION FORM: GPS ORIGINAL WELL # L2883

API: 47-051-00580 WELL NO.: M-1643

FARM NAME: FRANK CHAMBERS

RESPONSIBLE PARTY NAME: WEST VIRGINIA LAND RESOURCES INC.

COUNTY: MARSHALL DISTRICT: LIBERTY

QUADRANGLE: CAMERON WV, PA

SURFACE OWNER: JOHN D. CUMPSTON

ROYALTY OWNER:

UTM GPS NORTHING: 4,405,792 m (1256')

UTM GPS EASTING: 540,228 m GPS ELEVATION: 383 m

The Responsible Party named above has chosen to submit GPS coordinates in lieu of preparing a new well location plat for a plugging permit or assigned API number on the above well. The Office of Oil and Gas will not accept GPS coordinates that do not meet the following requirements:

- Datum: NAD 1983, Zone: 17 North, Coordinate Units: meters, Altitude: height above mean sea level (MSL) – meters.
- Accuracy to Datum – 3.05 meters
- Data Collection Method:

Survey grade GPS : Post Processed Differential _____

Real-Time Differential

Mapping Grade GPS _____ : Post Processed Differential _____

Real-Time Differential _____


RECEIVED
Office of Oil and Gas

FEB 17 2023

WV Department of
Environmental Protection

4. Letter size copy of the topography map showing the well location.

I the undersigned, hereby certify this data is correct to the best of my knowledge and belief and shows all the information required by law and the regulations issued and prescribed by the Office of Oil and Gas.

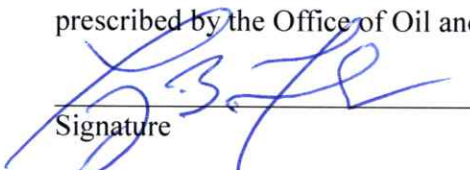
Signature

Professional Surveyor
Title

JANUARY 27, 2023
Date

