

WW-7
8-30-06



West Virginia Department of Environmental Protection
Office of Oil and Gas
WELL LOCATION FORM: GPS

API: 47-051-00928 WELL NO.: MH18
 FARM NAME: Consolidation Coal Company
 RESPONSIBLE PARTY NAME: Erika Whetstone
 COUNTY: Marshall DISTRICT: Liberty
 QUADRANGLE: Littleton
 SURFACE OWNER: Consolidation Coal Company
 ROYALTY OWNER: Consolidation Coal Company
 UTM GPS NORTHING: 4399992.74
 UTM GPS EASTING: 539385.65 GPS ELEVATION: 939.69'

The Responsible Party named above has chosen to submit GPS coordinates in lieu of preparing a new well location plat for a plugging permit or assigned API number on the above well. The Office of Oil and Gas will not accept GPS coordinates that do not meet the following requirements:

1. Datum: NAD 1983, Zone: 17 North, Coordinate Units: meters, Altitude: height above mean sea level (MSL) – meters.
2. Accuracy to Datum – 3.05 meters
3. Data Collection Method:
 Survey grade GPS ; Post Processed Differential

Real-Time Differential

Mapping Grade GPS ; Post Processed Differential

Real-Time Differential

4. **Letter size copy of the topography map showing the well location.**

I the undersigned, hereby certify this data is correct to the best of my knowledge and belief and shows all the information required by law and the regulations issued and prescribed by the Office of Oil and Gas.

Erika Whetstone

Signature

Permitting Supervisor, CNX Gas

Title


9/17/15

Date

Received
Office of Oil & Gas

OCT 01 2015

10/23/2015

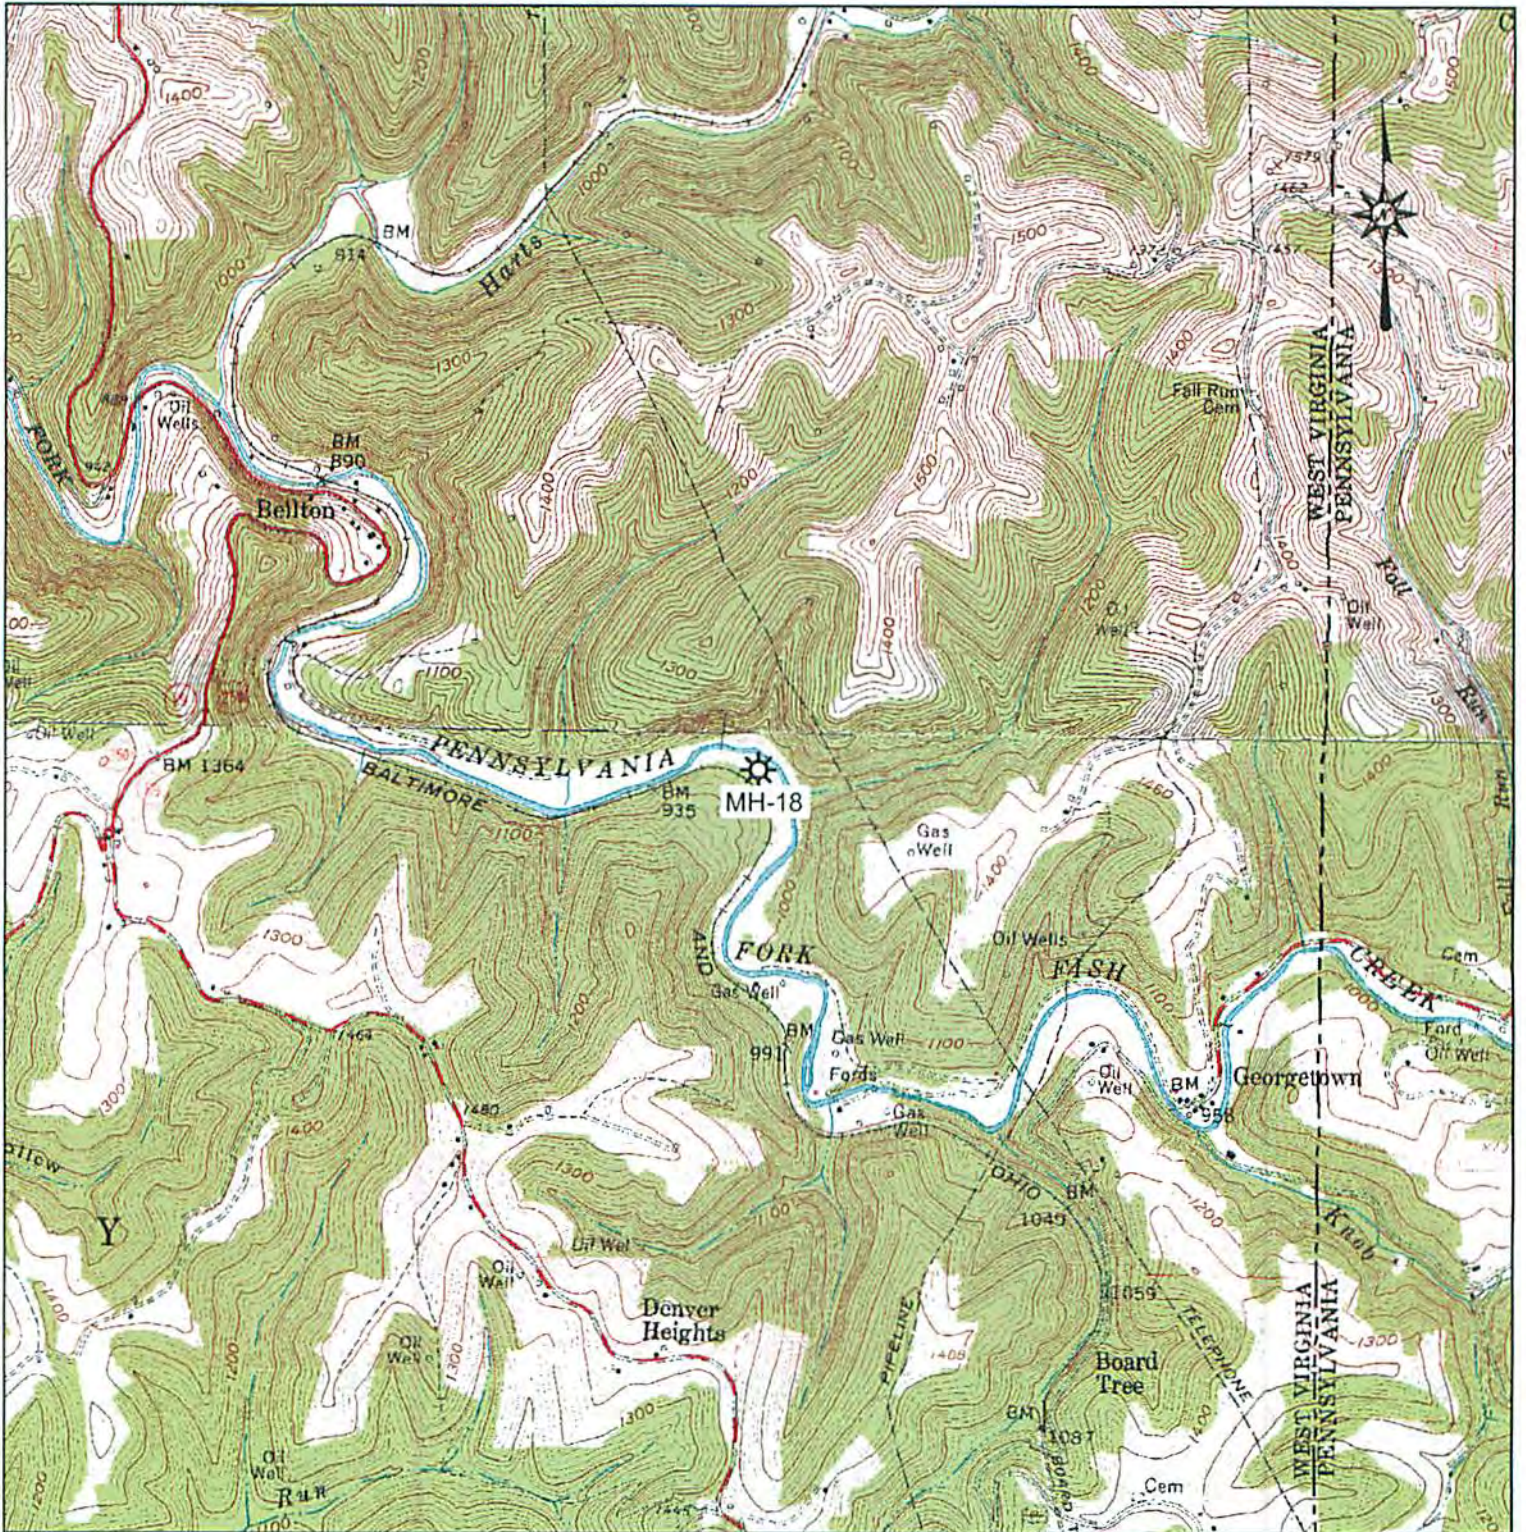

Blue Mountain Inc.
 10125 MASON DIXON HIGHWAY
 BURTON, WV 26562
 PHONE: (304) 662-6486

Received
 Office of Oil & Gas
 OCT 01 2015

PREPARED FOR:
 CNX GAS COMPANY LLC
 200 EVERGREENE DRIVE
 WAYNESBURG, PA 15370

COORDINATES:
 UTM 17-NAD83: N:4399992.74
 (METERS) E:539385.65
 NAD27, WV NORTH: N:456554.536
 (FEET) E:1707448.963
 EL:939.69

**MH-18
 LOCATION MAP
 MARSHALL COUNTY
 LIBERTY DISTRICT
 WEST VIRGINIA**

TOPO QUAD: LITTLETON, WV

SCALE: 1" = 2000'

DATE: SEPTEMBER 17, 2015