

COORDINATES:  
8,660' WEST  
2,206' SOUTH


CONSOLIDATION COAL COMPANY  
TM/PAR 12/36  
DB/PG 617/176  
15.3 ACRES ±

LINE	BEARING	DISTANCE
L1	S 78°21'11" W	220.22'
L2	N 18°51'11" E	170.00'
L3	N 02°21'11" E	386.00'
L4	N 08°08'49" W	393.00'



**Blue Mountain Engineering**  
11023 MASON DIXON HIGHWAY  
BURTON, WV 26562  
PHONE: (304) 682-6486

PRESLEY WETZEL

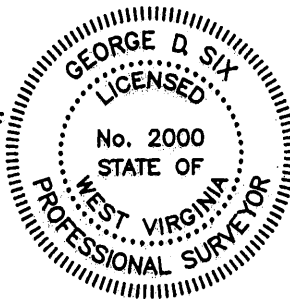

I THE UNDERSIGNED, HEREBY CERTIFY THAT THIS PLAT IS CORRECT TO THE BEST OF MY KNOWLEDGE AND BELIEF AND SHOWS ALL THE INFORMATION REQUIRED BY LAW AND THE REGULATIONS ISSUED AND PRESCRIBED BY THE DEPARTMENT OF ENERGY.

P.S. No. 2000 *George D. Six*

(+) DENOTES LOCATION OF WELL ON UNITED STATES TOPOGRAPHIC MAPS

DATE JULY 15, 2004  
OPERATOR'S WELL NO. M-285  
API WELL NO. 47 - 051 - 00945P  
STATE COUNTY PERMIT

MINIMUM DEGREE OF ACCURACY: 1/2500 FILE No.: M-285  
SCALE: 1" = 300'  
PROVEN SOURCE OF ELEVATION: U.S.G.S. MONUMENT - EASTON 1481.53'

STATE OF WEST VIRGINIA  
DIVISION OF ENVIRONMENTAL PROTECTION  
OFFICE OF OIL AND GAS  
*WV OGI 70592*

WELL TYPE: OIL  GAS  LIQUID INJECTION  WASTE DISPOSAL  "GAS" PRODUCTION  STORAGE  DEEP  SHALLOW

LOCATION: ELEVATION: 1154.32' WATERSHED: UNNAMED TRIBUTARY TO MAGGOTY RUN  
DISTRICT: LIBERTY COUNTY: MARSHALL QUADRANGLE: GLEN EASTON, WV 7.5'

SURFACE OWNER: CONSOLIDATION COAL COMPANY ACREAGE: 15.3±  
ROYALTY OWNER: \_\_\_\_\_ LEASE ACREAGE: \_\_\_\_\_  
PROPOSED WORK: \_\_\_\_\_ LEASE No.: \_\_\_\_\_

DRILL: \_\_\_\_\_ CONVERT: \_\_\_\_\_ DRILL DEEPER: \_\_\_\_\_ REDRILL: \_\_\_\_\_ FRACTURE OR STIMULATE: \_\_\_\_\_ PLUG OFF OLD: \_\_\_\_\_  
FORMATION: \_\_\_\_\_ PERFORATE NEW FORMATION: \_\_\_\_\_ PLUG AND ABANDON:  CLEAN OUT AND REPLUG: \_\_\_\_\_ OTHER: \_\_\_\_\_  
PHYSICAL CHANGE IN WELL (SPECIFY): \_\_\_\_\_ TARGET FORMATION: NONE  
ESTIMATED DEPTH: \_\_\_\_\_

WELL OPERATOR: CONSOLIDATION COAL Co., RIVER OPERATIONS DESIGNATED AGENT: MICHELE O'NEIL  
ADDRESS: Rd #4, Box 425, Moundsville, WV 26041 ADDRESS: Rd #4, Box 425, Moundsville, WV 26041

COUNTY NAME  
PERMIT  
MARS 0945 P

AFFIDAVIT OF PLUGGING AND FILLING WELL

AFFIDAVIT SHOULD BE MADE IN TRIPLICATE, one copy mailed to the Division, one copy to be retained by the Well Operator and the third copy (and extra copies if required) should be mailed to each coal operator at their respective addresses.

Consolidation Coal Co. / River Operations  
Coal Operator or Owner  
RD # 4, Box 425, Moundsville, WV 26041  
Address

Consolidation Coal Co. / River Operations  
Coal Operator or Owner  
RD # 4, Box 425, Moundsville, WV 26041  
Address

Consolidation Coal Co.  
Lease or Property Owner  
1800 Washington Road, Pittsburgh, PA 15241  
Address

Consolidation Coal Co.  
Name of Well Operator  
1800 Washington Road, Pittsburgh, PA 15241  
Complete Address

Glen Easton 7.5'  
Well Location  
Liberty  
District  
Marshall  
County  
M-285  
Well No.

Consolidation Coal Co.  
Farm

STATE INSPECTOR SUPERVISING PLUGGING

*Terry Urban* 10-26-04  
AFFIDAVIT

Terry Urban

STATE OF WEST VIRGINIA,  
County of \_\_\_\_\_ ss:


James Riffle and Kevin Wright, being first duly sworn according to law depose and say that they are experienced in the work of plugging and filling oil and gas wells and were employed by Consolidation Coal Company well operator, and participated in the work of plugging and filling the above well, that said work was commenced on the 09-30-04 and that the well was plugged in the following manner:

Sand or Zone Record Formation	Filling Material	Plugs Used Size & Kind	Casing Pulled	Casing Left In
	Cleaned hole with 12 1/4" bit from surface to 1225'. Reduce hole to 9 7/8", cleaned 9 7/8" hole from 1225' to 1350'. Cleaned hole with 12 1/4" bit thru Pittsburgh Coal which is from 892' to 898.		16" (0')	25' (At Surface)
	<u>Cement hole solid from 1350' to surface as follows:</u> Cemented hole from 1350' to 1098' with Expandable cement. Cemented hole from 1098' to 792' with 210 sacks Thixotropic with dye cement thru coal section. Cemented hole from 792' to surface with Expandable cement. A total of 690 sacks of Expandable cement used. A total of 900 sacks of cement used to plug well.  <u>Cement did circulate.</u>	From 1350' to 1098' with Expandable Cement From 1098' to 792' with 210 sacks Thix with Dye Cement From 792' to Surface with Expandable Cement  Total 900 sacks Cement		
Coal Seams		Description of Monument		
Pittsburgh Coal	892' to 898'	7" well marker, 77" long with Consol Coal Co.,		
(Name)		Well number, permit number, date and solid plug		
(Name)		Stated on 7" casing. Well marker will be		
(Name)		Attached to solid cement plug at ground level.		

... and that the work of plugging and filling said well was completed on 10-12-04.

And further deponents saith not.


Sworn to and subscribed before me this the 18<sup>th</sup> Day of October 2004.

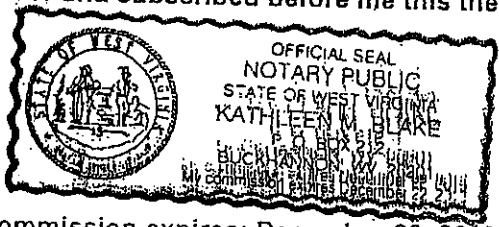

*James Riffle*  
James Riffle  
*Kevin Wright*  
Kevin Wright

*Kathleen M. Blake*  
Notary Public

Permit Number: 47-51-00945-P & Gas  
(Well # M-285)

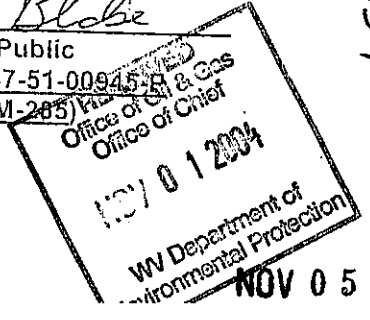

MARS 0945 P

NOV 05 2004