

WW-7  
8-30-06



West Virginia Department of Environmental Protection  
Office of Oil and Gas  
**WELL LOCATION FORM: GPS**

API: 47-051-01114 WELL NO.: MC-68P  
 FARM NAME: Lucey  
 RESPONSIBLE PARTY NAME: Consol Pennsylvania Coal Co.  
 COUNTY: Marshall DISTRICT: Webster  
 QUADRANGLE: Majorsville WV-PA 7.5  
 SURFACE OWNER: Daniel Lucey, et ux  
 ROYALTY OWNER: \_\_\_\_\_  
 UTM GPS NORTHING: 4415923.40 M  
 UTM GPS EASTING: 538027.10 M GPS ELEVATION: 354.51 M (1163')

The Responsible Party named above has chosen to submit GPS coordinates in lieu of preparing a new well location plat for a plugging permit or assigned API number on the above well. The Office of Oil and Gas will not accept GPS coordinates that do not meet the following requirements:

1. Datum: NAD 1983, Zone: 17 North, Coordinate Units: meters, Altitude: height above mean sea level (MSL) – meters.
2. Accuracy to Datum – 3.05 meters
3. Data Collection Method:

Survey grade GPS  : Post Processed Differential \_\_\_\_\_

Real-Time Differential

Mapping Grade GPS \_\_\_\_\_ : Post Processed Differential \_\_\_\_\_

Real-Time Differential \_\_\_\_\_

4. Letter size copy of the topography map showing the well location.

I the undersigned, hereby certify this data is correct to the best of my knowledge and belief and shows all the information required by law and the regulations issued and prescribed by the Office of Oil and Gas.

Matthew Koble Project Engineer 3/22/2018  
 Signature Title Date


RECEIVED  
Office of Oil and Gas

APR 12 2018

WV Department of  
Environmental Protection

04/13/2018



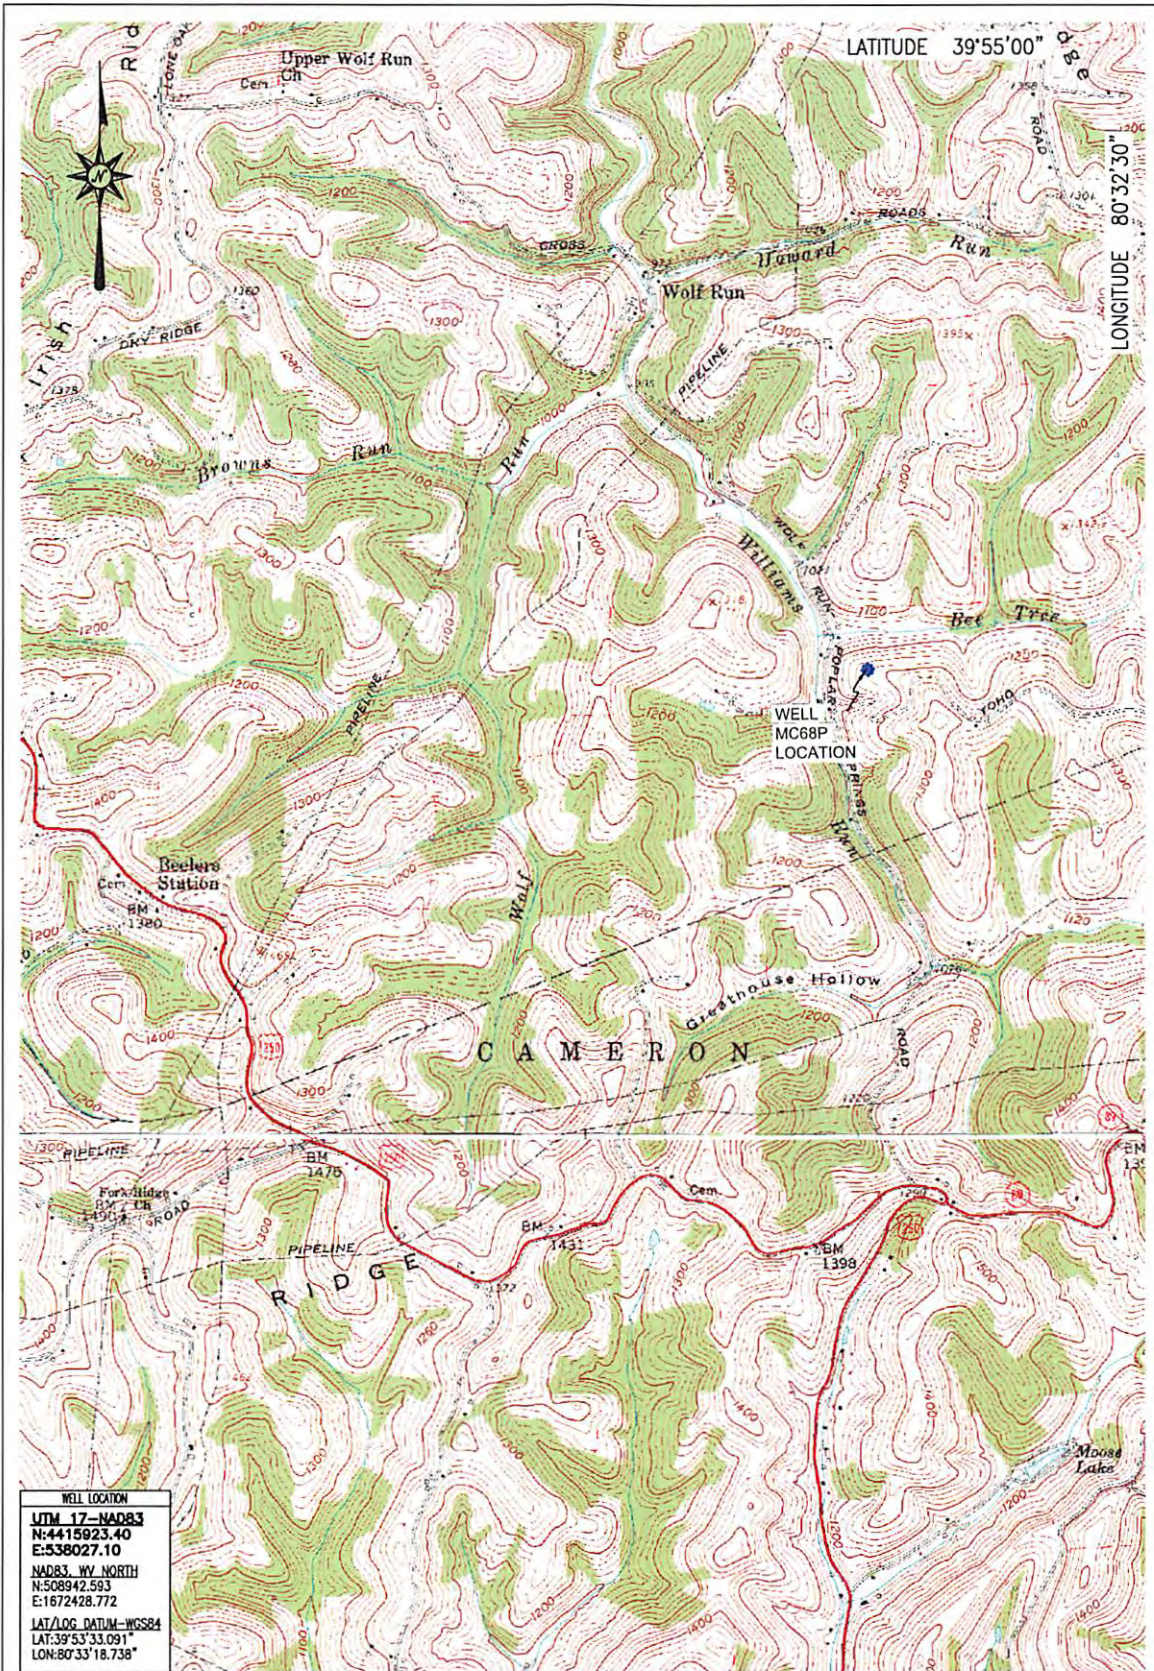

WELL LOCATION  
 UTM 17-NAD83  
 N:4415923.40  
 E:538027.10  
 NAD83, WV NORTH  
 N:508942.593  
 E:1672428.772  
 LAT/LOG DATUM-WGS84  
 LAT:39°53'33.091"  
 LONG:80°33'18.738"

LOCATION MAP  
 MARCH 22, 2018

**Blue Mountain Inc.**  
 10125 MASON DIXON HIGHWAY  
 BURTON, WV 26562  
 PHONE: (304) 662-6486

MC68P  
 MAJORSVILLE QUADRANGLE  
 WEST VIRGINIA

SCALE 1" = 2000'

0' 2000' 4000' 6000'



**BLUE MOUNTAIN ENGINEERING**

RECEIVED  
 Office of Oil and Gas  
 APR 12 2018  
 WV Department of  
 Environmental Protection