CNX Gas Company,LLC

Marshall Co., WV Cameron MC-144

MC-144 Build & Center Leg

Survey: Survey #1

Standard Survey Report

09 September, 2008

.

RECEIVED Office of Oil and Gas

SEP 2 5 2017

WV Department of Environmental Protection

10/20/2017

4705101154 Ohice of Oil and Gas

SEP 2 5 2017

WV Department of

Survey Report

								Environmen	ital Frotection		
Project: N Site: C Well: N Wellbore: N	CNX Gas Comp Aarshall Co., W Cameron AC-144 AC-144 Build & AC-144 Build & S Drilled Cente	Center Leg		TVD Re MD Ref North R	deference: Calculation		WELL @ 0.00ft (Original Well Elev) WELL @ 0.00ft (Original Well Elev) True				
Project	Marshall Co	., WV						der planet in the local design of the local de	and the second second second		
Map System: Geo Datum: Map Zone:	US State Pla North Americ West Virginia	an Datum 19		System	System Datum: Mean Sea Level Using geodetic scale factor						
Sila	Cameron		1.1.1.194	and subscreep				and the second			
Site Position: From: Position Uncertai	Map inty:	0.00 ft	Northing: Easting: Slot Radius:		93,339.55 ñ 571,260.28 ñ	Latitude Longitu Grid Co			39° 50' 58.760 M 80° 33' 31.370 M -0.68 °		
Well	MC-144		R					Colorado de la colorado			
Well Position Position Uncertai	+N/-S +E/-W nty	0.00 ft 0.00 ft 0.00 ft	Northing: Easting: Wellhead I	Elevation:	493,338 1,671,260		Latitude: Longitude: Ground Leve	d:	39° 50' 58.760 N 60° 33' 31.370 W 0.00ft		
Wellbore	MC-144 Bui	ild & Center I	Leg		- Juntations				ara-1		
Magnetics	Mödel Na	eme	Sample Date	Dec	lination (7)	D	ip Angla (1)	Field	Strength (nT)		
	IGR	RF2005	8/6/2008	1	-8.67	7	67.6	The second s	53,084		
Dasign	As Drilled Co	enter Leg			TRACK CONTRACTOR	Line re-			Contra and April 2		
Audit Notes: Version:	1.0		Phase:	ACTUAL		Tie On Depi	Ha-	0.00			
Vertical Section:			rem (TVD) (ft) 0.00	+N/+ (11) 0.00	C	+E/W) (ft) 0.00		Direction (*) 16.02			
Burvey Program From (11) 1,295.00	and the second se	Date 8/20 Servey (Wel Survey #1 (M	and the second	enter Leg)	Tool Name		Destription				
Survey	L							And the second second			
Monstared Depth (%)	Incligation (*)	Azimidth (1)	Verticui Depth (0)	+11/-5 (fi)	+EL-M) (10)	Vectical Section (1)	Dogleg Rain (*/1001i)	Build Rate (7/100(t))	Tuins Raile (171000)		
1,295.00 1,301.00 1,332.00 1,364.00 1,394.00	89.28 89.00 90.20 89.30 88.80	21.12 21.50 19.50 15.90 12.40	803.66 803.88 804.02	569.21 574.80 603.83 634.31 663.39	140.41 142.59 153.45 163.17 170.50	585.86 591.83 622.73 654.71 684.69	0.00 7.75 7.52 11.60 11.78	0.00 -4.58 3.87 -2.81 -1.67	0.00 6.25 -6.45 -11.25 -11.67		
1,428.00 1,460.00 1,493.00 1,525.00 1,556.00	91.30 92.20 90.80 88.30 89.90	12.50 13.00 12.40 13.00 13.50	804.48 803.51 802.64 802.89 803.38	696.59 727.79 759.97 791.18 821.35	177.83 184.89 192.15 199.18 206.28	718.62 750.55 783.48 815.43 846.39	7.36 3.22 4.62 8.03 5.41	7.35 2.81 -4.24 -7.81 5.16	0.29 1.56 -1.82 1.88 1.61		
1,588.00 1,620.00 1,652.00	91.70 90.70 91.10	13.80 12.80 13.40	802.93 802.26 801.76	852.44 883.58 914.74	213.83 221.19 228.45	878.35 910.31 942.26	5.70 4.42 2.25	5.63 -3.13 1.25	0.94 -3.13 1.88		

)

COMPASS 2003.21 Build 37 10/20/2017 RECEIVED Office of Oil and Gas

4705101154

SEP 2 5 2017

Survey

Survey Report

Company:	CNX Gas Company,LLC	Local Co-ordinate Reference:	Site Cameron
Project:	Marshall Co., WV	TVD Reference:	WELL @ 0.00ft (Original Well Elev)
Site:	Cameron	MD Reference:	WELL @ 0.00ft (Original Well Elev)
Well:	MC-144	North Reference:	True
Wellbore:	MC-144 Build & Center Leg	Survey Calculation Method:	Minimum Curvature
Design:	As Drilled Center Leg	Database:	2003.21 Single User Dbase

Build Vertical Vertical Dogleg Tum Measured Depth Depth +EJ-W Section Rate Rube Azimith +NI-S inclination ("HOOR) (11) ("/100ft) (*/10011) (ft) (市) (11) (代) (*) (*) 1.682.00 89.70 12.80 801.55 943.96 235.25 972.22 5.08 -4.67 -2.00 1,714.00 88.60 12.90 802.03 975.15 242.36 1,004.17 3.45 -3.44 0.31 5.04 2.50 4.38 1,746.00 89.40 14.30 802.59 1,006.25 249.88 1,036.14 90.40 14.20 802.64 1,037.27 257.76 1,068.12 3.14 3.13 -0.31 1,778.00 802.50 265.77 1,100.11 -0.94 1,810.00 90.10 14.80 1,068.25 2.10 1.88 802.72 1.098.39 272.98 1,131.07 9.29 -3.23 -8.71 89 10 12 10 1.841.00 6.19 -4.38 4.38 1.873.00 90.50 10.70 802.83 1,129.76 279.31 1.162.97 802.30 1,161.13 285.58 1,194.86 4.69 2.81 3.75 1,905.00 91.40 11.90 801.82 292.12 1.226.76 -3 44 -0.63 1,937.00 90.30 11.70 1.192.45 3.49 0.94 1,969.00 90.60 11.60 801.57 1,223.79 298.58 1,258.67 0.99 -0.31 1,255.16 304.88 1,290.56 7.36 -7.19 -1.56 2,001.00 88.30 11.10 801.88 89.80 12.80 802.39 1.285.48 311.30 1,321.48 7.31 4.84 5.48 2.032.00 2,064.00 91.40 13.70 802.06 1,316.63 318.63 1,353.44 5.74 5.00 2.81 13.80 801.22 1,347.70 326.23 1,385.40 0.70 0.63 0.31 2,096.00 91.60 333.81 1,417.37 -2.50 -0.63 2,128.00 90.80 13.60 800.55 1,378.78 2.58 3.81 -3.13 -2.19 2,160.00 89.80 12.90 800.38 1,409.93 341.14 1,449.33 91.10 13.20 800.13 1.441.10 348.37 1,481.28 4.17 4.06 0.94 2,192.00 91.50 13.30 799.45 1,470.30 355.24 1,511.24 1.37 1.33 0.33 2,222.00 798.95 362.58 1,543.20 3.76 -3.75 -0.31 2,254.00 90.30 13.20 1,501.44 2,286.00 88.30 13.90 799.34 1,532.55 370.07 1,575.17 6.62 -8.25 2.19 1,607.13 2.95 2.50 -1.562.318.00 89.10 13.40 800.07 1.563.63 377.62 1,90 -0.31 2,350.00 89.70 13.30 800.40 1.594.77 385.01 1.639.09 1.88 2,380.00 89.90 800.51 391.73 1,669.05 2.43 0.67 -2.33 12.60 1.624.00 4.52 2,411.00 90.90 14.00 800.29 1,654.17 398.87 1,700.01 5.55 3.23 2,443.00 89.40 14.80 800.21 1,685.16 406.82 1,732.00 5.31 -4.69 2.50 2,476.00 89.00 15.30 800,67 1,717.03 415.39 1,764.99 1.94 -1.21 1.52 601.28 1,747.97 423.54 1,796.98 3.49 -0.63 -3.44 2,508.00 88.80 14.20 1.828.95 0.99 -0.31 -0.94 2,540.00 88.70 13.90 801.98 1,779.00 431.30 2,572.00 90.10 14.80 802.31 1,810.00 439.23 1,860.93 5.20 4.38 2.61 89.30 15.50 802.48 1,840.89 447.60 1,892.93 3.32 -2.50 2.19 2,604.00 15.50 802.54 456.15 1,924.93 3.75 3.75 0.00 2,636.00 90.50 1,871.73 -5.45 90.70 13,70 802.19 1,903.66 464.47 1,957.91 5.49 0.61 2,669,00 2,700.00 90.30 13.30 801.92 1,933.80 471.70 1,988.88 1.82 -1.29 -1.29 802.09 1,964.95 479.01 2,020.84 3.80 -3.75 -0.63 2,732.00 89.10 13.10 2,052.81 2,764.00 90.30 13.80 802.26 1,996.07 486.45 4.34 3.75 2.19 3.32 2.50 -2.19 91.10 801.87 2,027.19 493,89 2,084.78 2,796.00 13.10 801.28 501.09 2.116.73 0.70 -0.31 -0.63 2.828.00 91.00 12.90 2.058.37 2.859.00 89.90 15.20 801.04 2.088.44 508.62 2,147.70 8.22 -3.55 7.42 2,179.70 2,119.33 3.49 -3.44 -0.63 2,891.00 801.40 516.95 88.80 15.00 -0.94 2,923.00 90.10 14.70 801.71 2.150.26 525.15 2.211.69 4.17 4.06 -0.63 2,955.00 90,00 14.50 801.68 2,181.23 533.22 2,243.68 0.70 -0.31 2.987.00 88.70 13.40 802.04 2,212.28 540.93 2,275.65 5.32 -4.06 -3.44 2,307.63 5.94 1.56 3,019.00 90.60 13.90 802.24 2.243.37 548.48 6.14 2,338.61 0.97 3,050.00 90.90 14.90 801.83 2,273.40 556.19 3.37 3.23 0.00 3,062.00 90.00 14.90 801,58 2,304.32 564.42 2,370.60 2.81 -2.81 14:40 801.30 2,335.28 572.51 2,402.59 3.49 3.13 -1.56 3,114.00 91.00 2,434.57 3.22 -1.56 -2.81 3,146.00 90.50 13.50 800.88 2,366.33 580.23 2,466.52 6.85 -6.25 -2.81 3,178.00 88.50 12.60 801.16 2,397.50 587.45 89.10 12.60 801.83 2,428.72 594.43 2,498.46 1.88 1.88 0.00 3,210.00 601.56 2,529.42 8.41 7.10 4.52 3,241.00 91.30 14.00 801.72 2,458.89 2,553.39 3.93 2.08 -3.33 3,265.00 91.80 13.20 801.07 2,482.21 607.20 2,585.36 -7.81 2.19 89.30 13.90 800.77 2,513.31 614.70 8.11 3.297.00 0.63 3,329.00 89.50 13.90 801.10 2,544.37 622.39 2.617.33 0.63 0.00 91.50 800.82 2,575.43 630.10 2,649.31 6.26 6.25 0.31 3,361.00 14.00

9/9/2008 11:49:32AM

COMPASS 2003.21 Build 37

RECEIVED Office of Oll and Gas

SEP 2 5 2017

Survey Report

Company: CNX Gas Company,LLC Project; Marshall Co., WV Site: Cameron Well; MC-144 Wellbore; MC-144 Build & Center Leg Design: As Drilled Center Leg					TVD Ref MD Refe North R	irejice) eference; Celculation M		Site Cameron Environmental Protection WELL @ 0.00ft (Original Well Elev) WELL @ 0.00ft (Original Well Elev) True Minimum Curvature 2003.21 Single User Dbase			
Survey		L. I.			101-1						
Mateja Dopti (N)		Inclination (*)	Azimuth	Vertical Depth (ft)	+NJ-5 (11)	+E/-W) (N)	Vertical Section (ft)	Dogleg Rate (7/100/t)	Bjalid Rate (7/100R)	Turn Rate (7/1008)	
3,392 3,425 3,456	5.00	89.20 86.70 87.70	14.10 13.50 13.60	800.63 801.81 803.33	2,605.50 2,637.52 2,667.62	637.62 645.49 652.75	2,680.29 2,713.24 2,744.17	7.43 7.79 3.24	-7.42 -7.58 3.23	0.32 -1.82 0.32	
3,490 3,519 3,550 3,582 3,582 3,613	00.00 0.00 2.00	90.10 91.40 90.00 88.90 90.50	14.20 13.90 13.50 13.00 13.70	803.98 803.60 803.22 803.53 803.59	2,700.62 2,728.75 2,758.86 2,790.01 2,820.17	660.91 667.95 675.29 682.63 689.78	2,778.14 2,807.12 2,838.09 2,870.05 2,901.02	7.28 4.60 4.70 3.78 5.63	7.06 4.48 -4.52 -3.44 5.16	1.76 -1.03 -1.29 -1.56 2.26	
3,645 3,679 3,710 3,742	0.00 0.00 2.00	91.30 90.60 89.70 88.80	13.70 14.10 13.40 12.30	803.19 802.62 802.54 802.96	2,851.25 2,884.25 2,914.36 2,945.56	697.36 705.53 712.90 720.01	2,932.99 2,966.96 2,997.93 3,029.88	2.50 2.37 3.68 4.44	2.50 -2.06 -2.90 -2.81	0.00 1.18 -2.26 -3.44	
3,774 3,810 3,838 3,870 3,903	0.00 3.00 0.00 3.00	89.70 90.40 90.40 89.60 88.00	12.90 13.40 13.20 12.30 12.50	803.38 803.35 803.15 803.15 803.85	2,976.79 3,011.84 3,039.09 3,070.30 3,102.52	726.99 735.18 741.62 748.69 755.77	3,061.82 3,097.78 3,125.74 3,157.69 3,190.62	3.38 2.39 0.71 3.76 4.89	2.81 1.94 0.00 -2.50 -4.85	1.88 1.39 -0.71 -2.81 0.61	
3,935 3,967 3,998 4,030 4,062	.00 .00	87.40 88.60 90.30 90.10 90.40	12.80 12.50 12.70 13.60 14.00	805.13 806.25 806.54 806.43 806.29	3,133.72 3,164.92 3,195.17 3,226.33 3,257.41	762.77 769.78 776.54 783.62 791.45	3,222.54 3,254.46 3,285.40 3,317.36 3,349.34	2.10 3.87 5.52 2.88 1.56	-1.88 3.75 5.48 -0.63 0.94	0.94 -0.94 0.65 2.81	
4,094 4,124 4,154 4,186 4,218	.00	90.90 91.20 90.50 90.50 89.00	13.10 12.10 11.60 13.10 14.50	805.93 805.38 804.94 804.66 804.80	3,288.52 3,317.79 3,347.15 3,378.40	798.95 805.49 811.65 818.49	3,381.31 3,411.25 3,441.17 3,473.10	3.22 3.48 2.87 4.69	1.56 1.00 -2.33 0.00	1.25 -2.81 -3.33 -1.67 4.69	
4,250 4,282 4,314 4,345	00.00	90.10 91.00 89.70 90.20	14.00 13.80 13.20 13.10	805.05 804.74 804.54 804.57	3,409.48 3,440.49 3,471.55 3,502.67 3,532.85	826.13 834.00 841.69 849.16 856.21	3,505.07 3,537.06 3,569.03 3,601.00 3,631.96	6.41 3.78 2.88 4.47 1.64	-4.69 3.44 2.81 -4.06 1.61	4.38 -1.56 -0.63 -1.88 -0.32	
4,377 4,409 4,441 4,472	.00	91.20 89.80 89.30 90.00	12.00 11.50 13.20 12.80	804.18 803.90 804.15 804.34	3,564.09 3,595.41 3,626.67 3,656.88	863.16 869.68 876.52 883.50	3,663.90 3,695.81 3,727.74 3,758.70	4.65 4.65 5.54 2.60	3.13 -4.38 -1.56 2.26	-3.44 -1.56 5.31 -1.29	
4,504 4,536 4,568 4,599	.00 .00	90.00 90.60 90.10 89.40	14.00 13.20 13.50 13.00	804.34 804.12 803.87 804.00	3,688.00 3,719.11 3,750.24 3,780.41	890.91 898.44 905.83 912.93	3,790.66 3,822.63 3,854.60 3,885.56	3.75 3.54 2.38	0.00 2.50 -2.19	3.75 -2.50 0.94	
4,631 4,663 4,695 4,727	.00 .00	89.90 90.30 89.30 89.10	11.90 10.50 10.70 11.80	804.20 804.14 804.25 804.70	3,811.66 3,843.05 3,874.50 3,905.89	919.83 926.04 931.93 938.17	3,949.38 3,981.24 4,013.13	2.77 3.78 4.55 3.19 3.49	-2.26 1.56 1.25 -3.13 -0.63	-1.61 -3.44 -4.38 0.63 3.44	
4,760 4,793 4,825 4,857 4,888	.00 .00	89.80 90.40 92.00 91.90 90.70	11.10 10.90 11.20 11.60 11.50	805.02 804.96 804.29 803.20 802.50	3,938.23 3,970.62 4,002.02 4,033.37 4,063.73	944.72 951.02 957.15 963.47 969.68	4,046.02 4,078.89 4,110.76 4,142.64 4,173.54	3.00 1.92 5.09 1.29 3.88	2.12 1.82 5.00 -0.31 -3.87	-2.12 -0.61 0.94 1.25 -0.32	
4,920, 4,952, 4,983, 5,015,	00. 00. 00. 00.	90.10 89.70 90.40 89.70	10.90 11.10 11.30 11.70	802.27 802.33 802.30 802.27	4,095.12 4,126.53 4,156.94 4,188.30	975.89 982.00 988.02 994.40	4,205.43 4,237.30 4,268.19 4,300.09	2.65 1.40 2.35 2.52	-1.88 -1.25 2.26 -2.19	-1.88 0.63 0.65 1.25	
5,047. 5,077.		90.40 90.40	11.60 11.70	802.25 802.04	4,219.64	1,000.86	4,332.00	2.21 0.33	2.19 0.00	-0.31 0.33	

9/9/2008 11:49:32AM

COMPASS 2003.21 Build 37 10/20/2017

Survey Report

Survey			Name and the second
Design:	As Drilled Center Leg	Database:	2003.21 Single User Dbase
Wellbore:	MC-144 Build & Center Leg	Survey Calculation Method:	Minimum Curvature
Welt	MC-144	North Reference:	True
Site:	Cameron	MD Reference:	WELL @ 0.00ft (Original Well Elev)
Project:	Marshall Co., WV	TVD Reference:	WELL @ 0.00ft (Original Well Elev)
Company:	CNX Gas Company,LLC	Local Co-ordinate Reference:	Site Cameron

Measured Depth (ft)	Inclination (*)	Azimuth (*)	Vertical Depth (ft)	+N/-S (ft)	+E/-W (ft)	Vertical Section (ft)	Dogleg Rate (*/100ft)	Build Rate (*/100ft)	Turn Rate (*/100ft)
5,110.00	89.30	11.40	802.12	4,281.35	1,013,53	4,394.81	3.46	-3.33	-0.91
5,142.00	89.20	10.80	802.54	4,312.75	1,019.69	4,426.69	1.90	-0.31	-1.88
5,174.00	89.90	9.60	802.79	4,344.24	1,025.41	4,458.53	3.81	2.19	-3.13
5,206.00	89.90	11.00	802.85	4,375.71	1,031.19	4,490.38	3.75	0.00	3.75
5,238.00	90.30	11.40	802.79	4,407.10	1,037.40	4,522.26	1.77	1.25	1.25
5,270.00	90.50	11.50	802.57	4,438.46	1,043.75	4,554.16	0.70	0.63	0.31
5,301.00	89.30	11.00	802.62	4,468.87	1,049.80	4,585.05	4.19	-3.87	-1.61
5,333.00	90.00	11.30	802.82	4,500.26	1,055.99	4,616.94	2.38	2.19	0.94
5,363.00	90.70	11.30	802.64	4,529.68	1,061.87	4,646.83	2.33	2.33	0.00
5,397.00	88.40	10.90	802.90	4,563.04	1,068.41	4,680.71	6.87	-6.76	-1.18
5,429.00	87.90	10.90	803.94	4,594.45	1,074.46	4,712.56	1.56	-1.56	0.00
5,461.00	89.20	10.30	804.75	4,625.89	1,080.34	4,744.41	4.47	4.06	-1.88
5,500.00	90.00	10.30	805.02	4,664.26	1,087.32	4,783.21	2.05	2.05	0.00
5,532.00	90.70	9.40	804.82	4,695.79	1,092.79	4,815.03	3.56	2.19	-2.81
5,547.00	90.90	7.20	804.61	4,710.63	1,094.96	4,829.89	14.73	1.33	-14.67
5,573.00	90.90	7.20	804.21	4,736.42	1,098.22	4,855.58	0.00	0.00	0.00

Checked By:

Approved By:

Date:

RECEIVED Office of Oil and Gas

SEP 2 5 2017

WV Department of Environmental Protection

10/20/2017

CNX Gas Company,LLC

Marshall Co., WV Cameron MC-144

MC-144 East Leg

Design: As Drilled East Leg

Standard Survey Report

09 September, 2008

RECEIVED Office of Oil and Gas

SEP 2 5 2017

WV Department of Environmental Protection



4705101154 RECEIVED Office of Oil and Gas

SEP 2 5 2017

Survey Report

Shran Party and and an and				prod formation in		the state of the state of the			Department of Amental Protectio	
Project: P Site: C Well: P Well: P	CNX Gas Comp Marshall Co., W Cameron MC-144 MC-144 East Le As Drilled East 1	V Ng	-	TVD Re MD Ref North R	eference: Calculation A		Site Cameron WELL @ 0.00ft (Original Well Elev) WELL @ 0.00ft (Original Well Elev) True Minimum Curvature 2003.21 Single User Dbase			
Project	Marshall Co	, wv							16.00 0180.000 Acces (200	
Map System: Geo Datum: Map Zone:		ine 1983 an Datum 198 Northern Zon	-	System Datum: Mean Sea Level Using geodetic scale factor						
Site	Cameron						61224.9260	KUT 1, KT OKUM D. 1.		
Site Position: From: Position Uncerta	Map linty:	0.00 ft	Northing: Easting: Slot Radius:		193,339.55ft 571,260.28ft	Latitude Longitu Grid Co			39* 50' 58.760 80* 33' 31.370 V -0.68 *	
Well	MC-144									
Well Position Position Uncerta	+N/-S +E/-W ainty	0.00 ft 0.00 ft 0.00 ft	Northing: Easting: Wellhead E	Elevation:	493,339 1,671,260		Latitude: Longitude: Ground Leve	l:	39° 50' 58.760 80° 33' 31.370 V 0.00 R	
Wellbore	MC-144 Ea	st Leg								
Magnetics	Model N	eme (Sample Date	Dec	lination (°)	D	ip Angle		Strength (n'T)	
	IGRE	200510	8/7/2008	and the second	-8.50		67.7	a second s	53,252	
Design	As Drilled E	ast Leg		CHRINE CHERT		1	and Prophet Descents		at a consent foliage over the a for	
Audit Notes: Version:	1.0		Phase:	ACTUAL		Tie On Dep	th:	0.00		
Vertical Section;			rom (TVD) (fl) .00	+N/- (#) 0.00	5	+E)-W (ft) 0.00		Direction (7) 38.21	re fili	
Survey Program From (ft) 50.00	and the same of th	Date 8/15/ Survey (Well Survey #1 (M			Tool Name		Description	1 m		
Survey/				Wellow w				and these seconds		
Measured Depth (ft)	Inclination (*)	Azimuth	Vertical Depth (ft)	+N/-S (ft)	+E/-W (ft)	Vertical Section (ft)	Dogleg Rate (1/100ft)	Build Rate (*/1000)	Tiim Rate ("/1004)	
0.00 50.00 100.00 150.00 200.00	0 0.00 0 0.81 0 0.93 0 0.86	0.00 312.00 310.60 298.80	0.00 50.00 99.99 149.99 199.98	0.00 0.24 0.74 1.18 1.43	0.00 -0.26 -0.83 -1.47 -2.15	0.00 0.02 0.06 0.02 -0.20	0.00 1.62 0.24 0.39 0.52	0.00 1.62 0.24 -0.14 -0.10	0.00 0.00 -2.80 -23.60 -35.20	
250.00 300.00 350.00 400.00 450.00	0 0.75 0 0.69 0 0.74 0 0.52	254.70 241.70 242.40 243.90	249.98 299.97 349.97 399.97 449.96	1.41 1.18 0.89 0.64 0.42	-2.81 -3.39 -3.94 -4.43 -4.83	-0.63 -1.17 -1.74 -2.24 -2.66	0.72 0.35 0.10 0.44 0.10	-0.12 -0.12 0.10 -0.44 0.02	-53.00 -26.00 1.40 3.00 -10.40	
500.00 550.00 593.00	0.37	197.40 188.10	499.96 549.96 592.96	0.15 -0.33 -0.74	-5.08 -5.17 -5.34	-3.02 -3.45 -3.88	0.70 0.76 1.03	-0.32 0.74 -0.56	-82.60 -18.60 83.26	

COMPASS 2003.21 Build 37

RECEIVED Office of Oil and Gas

SEP 2 5 2017

Survey Report

					Survey	Report			WYD	inertment of	
Company: Project: Silu: Velt: Veltore: Design:	CNX Gas Company,LLC Marshall Co., WV Cameron MC-144 MC-144 East Leg As Drilled East Leg				TVD Ref MD Belle North Re	rence: derence: Selculation 8		Environmental Protectio Site Cameron WELL @ 0.00ft (Original Well Elev) WELL @ 0.00ft (Original Well Elev) True Minimum Curvature 2003.21 Single User Dbase			
urvey		1							An in the second		
Monster Depth (ft)	and the second second	nclination (1)	Azimuth (7)	Vertical Depth (ft)	+N/-S (11)	+E/-W (ft)	Vertical Section (11)	Dogleg Rate (*/100ft)	Build Rate (*/10011)	Turn Rate (*14098)	
623. 655.		7.30 18.10	3.50 4.90	622.88 654.05	1.08 8.08	-5.31 -4.76	-2.44	25.63	22.67	465.33	
687. 719. 751. 784. 815.	00 00 00	28.50 38.70 48.30 58.40 64.20	6.50 10.60 13.80 14.10 13.10	683.40 710.02 733.21 752.88 767.76	20.65 38.12 59.61 85.27 111.68	-3.47 -0.76 3.94 10.32 16.71	3.40 14.08 29.48 49.27 73.38 98.09	33.76 32.56 32.64 30.77 30.61 18.92	33.75 32.50 31.88 30.00 30.61 18.71	4.38 5.00 12.81 10.00 0.91 -3.23	
647. 880. 912. 925. 942.	00 00 00	69.00 74.80 80.30 83.20 86.70	12.60 12.80 13.20 12.20 10.90	780.47 790.72 797.61 799.48 800.98	140.31 170.90 201.33 213.88 230.47	23.23 30.13 37.15 39.98 43.37	124.62 152.92 181.18 192.79 207.92	15.07 17.59 17.23 23.57 21.95	15.00 17.58 17.19 22.31 20.59	-3.23 -1.56 0.61 1.25 -7.69 -7.65	
958. 975. 990. 1,007. 1,017.	00 00 00	87.90 87.80 88.20 89.40 89.80	10.40 9.90 10.30 11.80 12.70	801.73 802.37 802.89 803.25 803.32	246.17 262.90 277.66 294.34 304.11	46.32 49.32 51.95 55.20 57.33	222.09 237.08 250.30 265.42 274.41	8.12 3.00 3.77 11.30 9.85	7.50 -0.59 2.67 7.06 4.00	-3.13 -2.94 2.67 8.82 9.00	
1,039. 1,047. 1,079. 1,111. 1,142.	00 00 00	89.40 89.60 89.90 90.60 91.10	15.00 16.40 16.10 16.70 17.10	803.47 803.54 803.68 803.54 803.08	325.47 333.17 363.89 394.59 424.24	62.59 64.76 73.71 82.75 91.76	294.45 301.84 331.52 361.23 390.10	10.61 17.68 1.33 2.88 2.07	-1.82 2.50 0.94 2.19 1.61	10.45 17.50 -0.94 1.88 1.29	
1,174. 1,195. 1,206. 1,236. 1,236.	00 00 00	92.20 91.10 90.50 87.70 88.30	17.40 17.90 18.30 18.80 19.50	802.16 801.55 801.40 801.87 803.02	454.79 474.79 485.25 513.68 544.84	101.24 107.61 111.02 120.57 131.38	419.97 439.63 449.96 478.20 509.37	3.56 5.75 6.56 9.48 2.79	3.44 -5.24 -5.45 -9.33 1.82	0.94 2.38 3.64 1.67 2.12	
1,301.0 1,333.0 1,365.0 1,397.0 1,429.0	00	89.50 90.20 89.90 89.60 89.70	21.50 24.10 26.70 30.00 33.40	803.64 803.72 803.69 803.83 804.03	574.80 604.30 633.20 661.36 688.58	142.59 154.99 168.71 183.91 200.72	539.85 570.69 601.90 633.42 665.21	7.29 8.41 8.18 10.35 10.63	3.75 2.19 -0.94 -0.94 0.31	6.25 8.13 8.13 10.31 10.63	
1,460.0 1,492.0 1,524.0 1,557.0 1,589.0	00 00 00 00	89.90 91.10 92.20 89.90 88.90	36.70 40.80 41.90 41.10 41.10	804.14 803.86 802.94 802.33 802.67	713.96 738.91 762.92 787.63 811.74	218.52 238.54 259.67 281.53 302.57	696.15 728.14 760.08 793.02 824.98	10.66 13.35 4.86 7.38 3.13	0.65 3.75 3.44 -6.97 -3.13	10.65 12.81 3.44 -2.42 0.00	
1,621.0 1,652.0 1,683.0 1,715.0 1,747.0	00 00 00 00	90.10 90.40 90.70 89.20 89.10	41.60 41.70 41.60 41.70 41.60	802.95 802.81 802.51 802.54 803.02	835.76 858.93 882.09 906.00 929.91	323.71 344.31 364.91 386.18 407.44	856.93 887.87 918.81 950.76 982.69	4.06 1.02 1.02 4.70 0.44	3.75 0.97 0.97 -4.69 -0.31	1.56 0.32 -0.32 0.31 -0.31	
1,778.0 1,810.0 1,842.0 1,874.0 1,906.0	00 00 00	89.00 90.10 89.60 91.20 90.90	41.40 41.70 40.90 41.40 40.70	803.53 803.78 803.86 803.64 803.05	953.12 977.07 1,001.11 1,025.20 1,049.33	427.98 449.20 470.32 491.38 512.39	1,013.64 1,045.58 1,077.54 1,109.49 1,141.45	0.72 3.56 2.95 5.24 2.38	-0.32 3.44 -1.56 5.00 -0.94	-0.65 0.94 -2.50 1.56 -2.19	
1,938.0 1,969.0 2,001.0 2,033.0 2,065.0	ю Ю Ю	90.00 88.30 87.80 89.40 90.10	40.30 41.00 41.30 40.10 39.40	802.80 803.26 804.35 805.13 805.27	1,073.66 1,097.18 1,121.26 1,145.51 1,170.11	533.17 553.36 574.41 595.27 615.73	1,173.42 1,204.39 1,236.33 1,268.28 1,300.27	3.08 5.93 1.82 6.25 3.09	-2.81 -5.48 -1.56 5.00 2.19	-1.25 2.26 0.94 -3.75 -2.19	
2,097.0		90.30 89.70	40.30 42.10	805.16 805.16	1,194.68	636.23 657.31	1,332.26	2.88 5.93	0.63 -1.88	2.81 5.63	

1

1

4705101154 RECEIVED Office of Oil and Gas

SEP 2 5 2017

Survey Report

and the state of t			The state of the s
Design:	As Drilled East Leg	Database;	2003.21 Single User Dbase
Wellbore:	MC-144 East Leg	Survey Calculation Method:	Minimum Curvature
Welt	MC-144	North Reference:	True
Site:	Cameron	MD Reference:	WELL @ 0.00ft (Original Well Elev)
Project:	Marshall Co., WV	TVD Reference:	WELL @ 0.00ft (Original Well Elev)
Company:	CNX Gas Company,LLC	Local Co-ordinate Reference:	Site Cameron
	CNIX Cas Company II C	I will be within the best	VIV Deportment o Environmental Protec

Measured Depth (ft)	Inclination (*)	Azimuth (*)	Vertical Depth (ft)	+N/-S (ft)	+E/-W (ft)	Vertical Section (ft)	Dogleg Rate (*/100ft)	Build Rate (*/100ft)	Turn Rate (*/100R)
2,160.00	89.00	41.90	805.51	1,241.79	678.05	1,395.14	2.35	-2.26	-0.65
2,192.00	90.60	42.60	805.63	1,265.48	699.57	1,427.06	5.46	5.00	2.19
2,224.00	90.40	42.30	805.35	1,289.09	721.16	1,458.97	1.13	-0.63	-0.94
2,256.00	90.00	43.90	605.23	1,312.45	743.03	1,490.86	5.15	-1.25	5.00
2,288.00	89.20	44.10	805.46	1,335.47	765.26	1,522.69	2.58	-2.50	0.63
2,320.00	89.80	43.90	805.74	1,358.49	787.49	1,554.53	1.98	1.68	-0.63
2,351.00	88.90	42.40	806.09	1,381.10	808.68	1,585.41	5.64	-2.90	-4.84
2,382.00	89.70	41.80	806.47	1,404,10	829.47	1,616.34	3.23	2.58	-1.94
2,413.00	90.20	42.60	606.49	1,427.07	850.29	1,647.26	3.04	1.61	2.58
2,444.00	89.00	43.00	806.71	1,449.81	871.35	1,678.16	4.08	-3.87	1.29
2,476.00	89.70	42.90	807.07	1.473.23	893.15	1,710.05	2.21	2.19	-0.31
2,508.00	90.30	42.70	807.07	1,496.71	914.89	1,741.94	1.98	1.88	-0.63
2,540.00	90.00	42.30	806.99	1,520.31	936.51	1,773.85	1.56	-0.94	-1.25
2,573.00	90.40	43.70	806.87	1,544.44	959.02	1,806.74	4.41	1.21	4.24
2,605.00	90.10	43.20	805.74	1,567.67	981.03	1,838.60	1.82	-0.94	-1.56
2,637.00	89.80	42.50	806.76	1,591.13	1,002.79	1,870.50	2.38	-0.94	-2.19
2,669.00	90.60	43.30	806.65	1,614.57	1,024.57	1,902.39	3.54	2.50	2.50
2,701.00	90.50	42.50	806.34	1,638.01	1,046.35	1,934.28	2.52	-0.31	-2.50
2,733.00	89.10	42.00	806.46	1,661.70	1,067.87	1,966.20	4.65	-4.38	-1.56
2,765.00	89.00	41.60	806.99	1,685,55	1,089.19	1,998.13	1.29	-0.31	-1.25
2,797.00 2,828.00	89.40	42.40	807.43	1.709.33	1,110.60	2,030.06	2.79	1.25	2.50
	89.80	41.90	807.65	1,732.31	1,131.41	2,060.99	2.07	1.29	-1.61
2,860.00	89.30	41.10	807.90	1,756.28	1,152.61	2,092.93	2.95	-1.56	-2.50
2,892.00	90.30	40.60	808.01	1,780.48	1,173.54	2,124.90	3.49	3.13	-1.56
2,924.00	90.80	39.70	807.71	1,804.94	1,194.17	2,156.88	3.22	1.56	-2.81
2,956.00	91.40	39.00	807.09	1,829.68	1,214.46	2,168.87	2.88	1.88	-2.19
2,988.00 3,019.00	90.50 89.80	40.00 41.30	806.56 806.48	1,854.37 1,877.89	1,234.81	2,220.85 2,251.82	4.20 4.76	-2.81 -2.26	3.13 4.19
3.051.00	90.50	42.90	806.40	1,901.63	1,276.45	2,283.75	5.46	, 2.19	5.00
3,083.00	89.80	44.20	806.31	1,924.82	1,298.50	2,315.61	4.61	-2.19	4.06
3,115.00	89.50	43.50	806.51	1,947.90	1,320.67	2,347.45	2.38	-0.94	-2.19
3,147.00	90.60	42.50	806.48	1,971.30	1,342.49	2,379.34	4.65	3.44	-3.13
3,178.00	88.90	41.40	805.61	1,994.35	1,363.21	2,410.27	6.53	-5.48	-3.55
3,210.00	87.50	42.00	807.62	2,018.23	1,384.49	2,442.20	4.76	-4.38	1.68
3,242.00	88.80	41.70	808.65	2,042.06	1,405.83	2,474.11	4.17	4.06	-0.94
3,274.00	90.50	41.20	808.85	2,066.04	1,427.01	2,506.06	5.54	5.31	-1.56
3,298.00	91.50	40.30	808.43	2,084.22	1,442.67	2,530.03	5.61	4.17	-3.75
3,330.00	90.10	41.30	807.98	2,108.44	1,463.58	2,562.00	5.38	-4.38	3.13
3,363.00	88.90	43.10	808.27	2,132.88	1,485.75	2,594.91	6.56	-3.64	5.45
3,394.00	89.50	43.30	808.70	2,155.48	1,506.96	2,625.79	2.04	1.94	0.65
3,427.00	91.00	44.60	808.56	2,179.24	1,529.87	2,658.62	6.01	4.55	3.94
3,465.00 3,497.00	89.70 89.40	44.80 43.30	808.33 808.58	2,206,25 2,229,24	1,556.59	2,696.38 2,728.21	3.46	-3.42	0.53
3,522.00 3,555.00	90.50 90.40	43.00 44.00	808.60 808.34	2,247.48 2,271.42	1,595.94	2,753.12 2,785.98	4.56	4.40	-1.20 3.03
3,584.00	89.70	44.00	808.34	2,292.09	1,639.00	2,785.98	4.50	-0.30	3.03
3,615.00	90.40	45.10	808.29	2,292.09	1,660.96	2,845.57	2.26	2.26	0.00
3,648.00	89.10	44.10	808.43	2,313.97	1,684.13	2,878.37	4.97	-3.94	-3.03
3,680.00	89.80	43.60	808.74	2.360.54	1,706.29	2,910.21	2.69	2.19	-1.56
3,711.00	90.40	44.90	808.69	2,382.74	1,727.92	2,941.04	4.62	1.94	4.19
3,743.00	89.20	44.90	808.80	2,405.41	1,750.51	2,972.82	3.75	-3.75	0.00
3,774.00	89.00	44.00	809.28	2,427.54	1,772.22	3,003.63	2.97	-0.65	-2.90
3,808.00	89.90	43.40	809.61	2,452.12	1,795.71	3,037.47	3.18	2.65	-1.76
3,839.00	88.70	43.80	809.99	2,474.56	1,817.08			-3.87	1.29

9/9/2008 11:48:46AM

COMPASS 2003.21 Build 37


RECEIVED Office of Gil and Gas

SEP 2 5 2017

Survey Report

WV Departmoni of Environmental Frotection

Measured Depth (ft) 3,871.00	- Land			Databas	Calculation A h1	Nethiod:	Site Cameron WELL @ 0.00ft (Original Well Elev) WELL @ 0.00ft (Original Well Elev) True Minimum Curvature 2003.21 Single User Dbase			
Depth (ft)						500				
	Inclination (?)	Azimiith	Vertical Depth (ft)	+)ii-6 (R)	+E)-4() (ft)	Vertical Section (ft)	Dogleg Rists (*/100(1)	Build Rite (7/100ft)	Turn Rate	
	89.90	43.40	810.38	2,497.73	1,839.15	3,100.19	3.95	and the second se	(*/100(t))	
3,902.00	90.90	44.40	810.16	2,520.07	1,860.64	3,131.03	4.56	3.75 3.23	-1.25 3.23	
3,934.00	89.60	44.40	810.02	2,542.93	1,883.03	3,162.85	4.06	-4.06	0.00	
3,965.00	89.50	45.10	810.27	2,564.95	1,904.86	3,193.64	2.28	-0.32	2.26	
3,998.00	90.90	44.40	810.15	2,588.38	1,928.09	3,226.43	4.74	4.24	-2.12	
4,029.00	89.80	45.10	809.96	2,610.40	1,949.91	3,257.23	4.21	-3.55	2.26	
4,060.00	89.70	44.70	810.10	2,632.36	1,971.79	3,288.01	1.33	-0.32	-1.29	
4,093.00	89.70	44.30	810.27	2,655.89	1,994.92	3,320.82	1.21	0.00	-1.21	
4,125.00	88.50	44.20	810.77	2,678.81	2,017.25	3,352.63	3.76	-3.75	-0.31	
4,157.00	87.00	43.70	812.03	2,701.83	2,039.44	3,384.45	4.94	-4.69	-1.56	
4,187.00	88.70	44.40	813.16	2,723.38	2,060.28	3,414.27	6.13	5.67	2.33	
4,218.00	89.00	45.30	813.78	2,745.35	2,082.14	3,445.05	3.06	0.97	2.90	
4,252.00	90.20	45.50	814.02	2,769.22	2,106.35	3,478.79	3.58	3.53	0.59	
4,283.00	90.20	45.40	813.91	2,790.97	2,128.44	3,509.54	0.32	0.00	-0.32	
4,314.00	91.10	45.10	813.56	2,812.79	2,150.45	3,540.30	3.06	2.90	-0.97	
4,347.00	89.80	44.00	813.30	2,836.31	2,173.60	3,573.10	5.16	-3.94	-3.33	
4,378.00	90.50	43.30	813.22	2,858.74	2,195.00	3,603.96	3.19	2.26	-2.26	
4,410.00 4,443.00	90.60 93.50	44.30	812.91	2,881.83	2,217.15	3,635.80	3.14	0.31	3.13	
		45.40	811.73	2,905.21	2,240.40	3,668.56	9.40	8.79	3.33	
4,475.00	92.20	44.50	810.14	2,927.83	2,262.98	3,700.30	4.94	-4.06	-2.81	
4,506.00	91.90	43.90	809.03	2,950.04	2,284.58	3,731.11	2.16	-0.97	-1.94	
4,539.00 4,571.00	90.50 91.00	43.90	808.34	2,973.81	2,307.46	3,763.94	4.24	-4.24	0.00	
4,603.00	90.20	44.10 44.10	807.92 807.58	2,996.83	2,329.68	3,795.77	1.68	1.56	0.63	
				3,019.81	2,351.95	3,827.60	2.50	-2.50	0.00	
4,635.00	90.00	44.90	807.53	3,042.63	2,374.38	3,859.41	2.58	-0.63	2.50	
4,666.00 4,698.00	91.00	44.90	807.26	3,064.59	2,396.26	3,890.19	3.23	3.23	0.00	
4,730.00	90.00 90.70	44.30 42.70	806.98	3,087.37	2,418.73	3,921.99	3.64	-3.13	-1.88	
4,761.00	90.00	44.10	806.78 806.59	3,110.58	2,440.76	3,953.86	5.46	2.19	-5.00	
				3,133.11	2,462.05	3,984.73	5.05	-2.26	4.52	
4,793.00	90.60	44.60	806.42	3,155.99	2,484.42	4,016.54	2.44	1.88	1.56	
4,825.00 4,857.00	89.80	44.50	806.31	3,178.79	2,506.87	4,048.35	2.52	-2.50	-0.31	
4,888.00	69.40 90.20	44.40	806.54	3,201.63	2,529.28	4,080.16	1.29	-1.25	-0.31	
4,920.00	90.20	44.50 44.30	806.64 806.53	3,223.76	2,550.99	4,110.97	2.60	2.58	0.32	
				3,246.63	2,573.38	4,142.78	0.62	0.00	-0.63	
4,950.00	91.30	43.30	806.14	3,268.28	2,594.14	4,172.64	4.96	3.67	-3.33	
4,982.00 5,014.00	90.20	43.40	805.72	3,291.54	2,616.10	4,204.51	3.45	-3.44	0.31	
5,046.00	90.70 90.80	44.20 44.50	805.47	3,314.64	2,638.25	4,236.35	2.95	1.56	2.50	
5,079.00	89.60	44.50	805.05 804.94	3,337.52 3,361.12	2,660.62	4,268.17	0.99	0.31	0.94	
					2,683.69	4,300.98	3.75	-3.64	-0.91	
5,111.00 5,143.00	88.40	44.80	805.49	3,383.94	2,705.11	4,332.78	4.19	-3.75	1.88	
5,175.00	88.60 89.30	44.40	806.33	3,406.71	2,728.57	4,364.57	1.40	0.63	-1.25	
5,207.00	91.10	45.30 45.00	806.92 606.81	3,429.40	2,751.14	4,396.35	3.56	2.19	2.81	
5,235.00	90.70	45.00	806.37	3,451.96 3,471.83	2,773.82 2,793.55	4,428.11	5.70	5.63	-0.94	
						4,455.92	2.02	-1.43	-1.43	
5,277.00 5,303.00	91.00	45.30	805.74	3,501.55	2,823.22	4,497.63	1.81	0.71	1.67	
0,000.00	91.00	45.30	805.29	3,519.84	2,841.70	4,523.43	0.00	0.00	0.00	

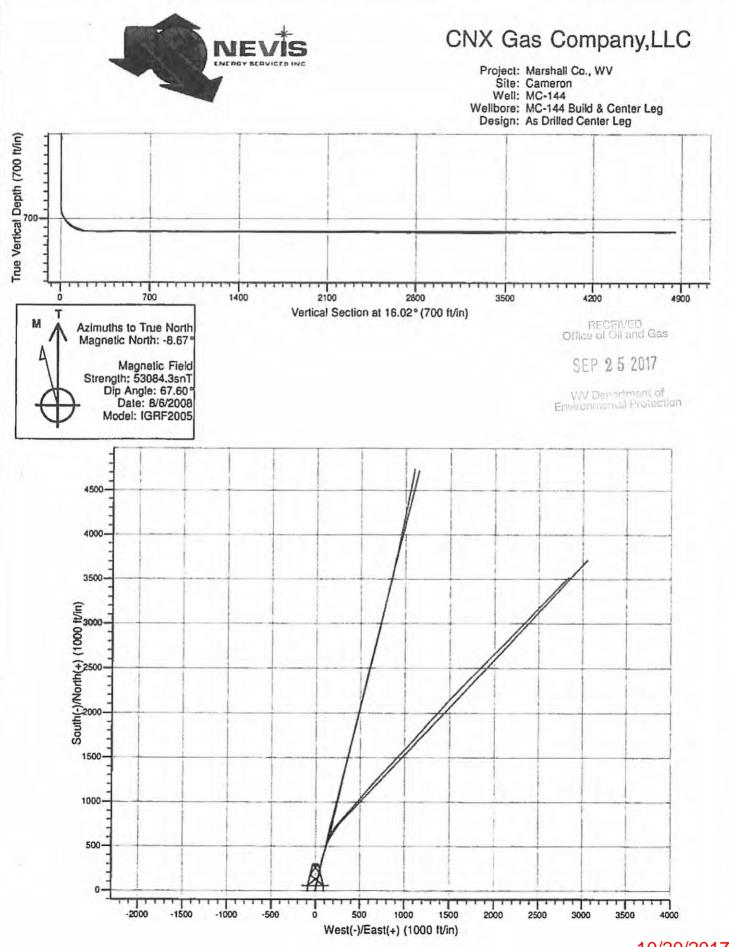

10/20/2017