Plot___ Log___ Card ✓ CSD___ 7/30/79 E

Latitude 39°50'00"

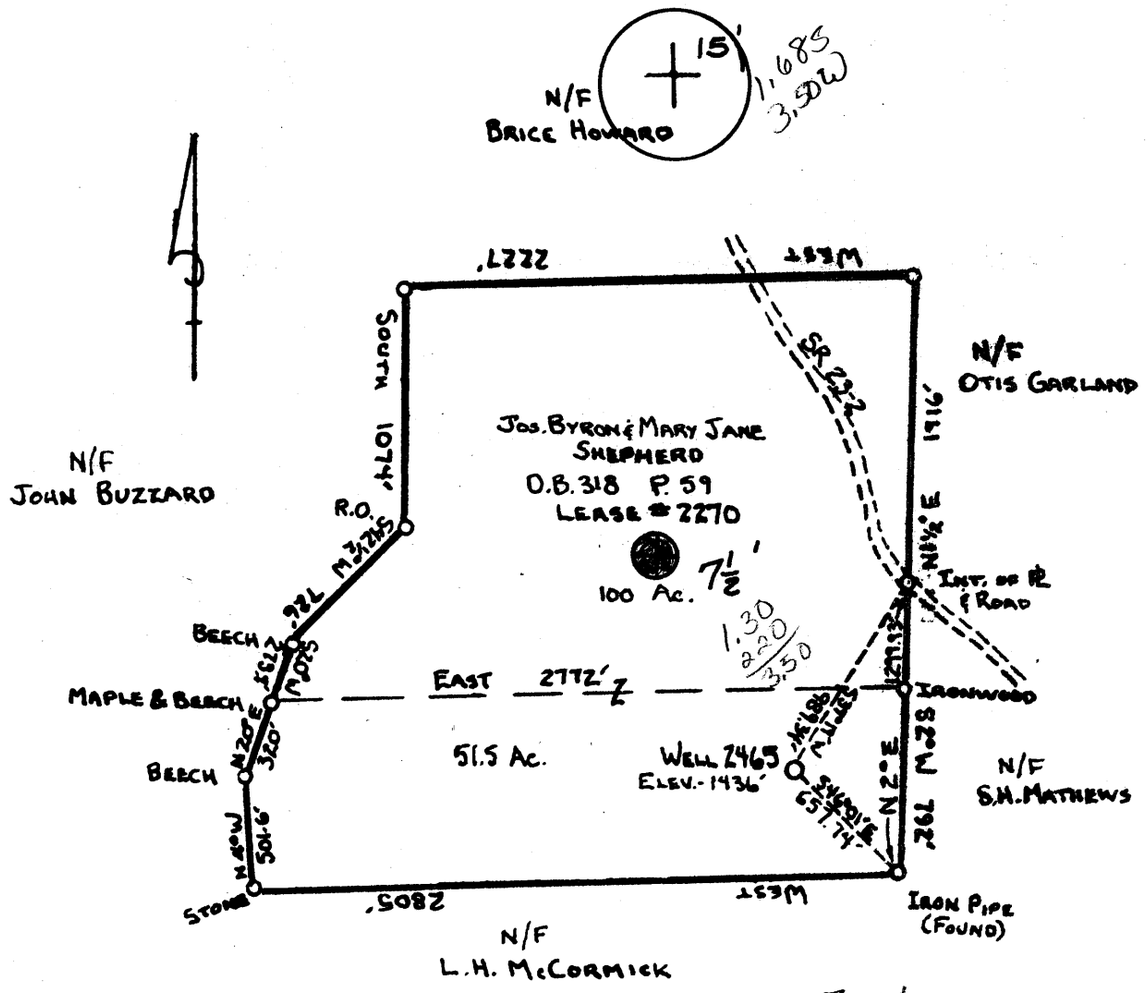

(15') 80°30'
Longitude 80°32'30"

NOTE: NO BUILDINGS ARE WITHIN 300' OF WELL.

POINT OF KNOWN ELEVATION - U.S.G.S. TOPO SPOT ELEVATION - TOP OF KNOB APP. 1500' SOUTH WEST OF WELL 2465.

New Location	☐
Storage	☐
Drill Deeper	☐
Abandonment	☒
Re-Drill/Fracture	☐

"I, the undersigned, hereby certify that this map is correct to the best of my knowledge and belief and shows all the information required by the rules and regulations of the oil and gas section of the mining laws of WEST VIRGINIA Minimum degree of accuracy is one part in 2500

F.B. 1292-N P. 63
MAP # O-25-24 SE.

Signed Robert C. Floyd
SURVEYOR # 6427 (OHIO)

Company COLUMBIA GAS TRANSMISSION CORP.
Address P.O. BOX 1273 CHARLESTON, W.VA. 25325
Farm JOS. BYRON & MARY JANE SHEPHERD
Lease 2270 Acres 155
Well Farm No. 602465 Ser. No. 2465
Elevation - Spirit Level 1436'
Quadrangle CAMERON, W.VA.-PA.
Township or District LIBERTY
County MARSHALL
Sec., Lot, Qr. ____ T. ____ R. ____
Coordinates LAT.- 39°48'33" LONG.- 80°33'57"
File No. ____ Dwg. No. ____
Date JULY 26, 1979 Scale 1" = 800'

STATE OF WEST VIRGINIA
DEPARTMENT OF MINES
OIL & GAS DIVISION - CHARLESTON

WELL LOCATION MAP

(+) Denotes Values Of Well On United States Topographic Maps

47-051-0589-P

Scale 15' ☐ 7½' ☒

Now 051 01242

AUG 10 1979