

Well is located on topo map 643 feet south of Latitude: 39° 52' 30"


Well is located on topo map 7.198 feet west of Longitude: 80° 40' 00"

AS DRILLED APPROX. LANDING POINT
 UTM 17-NAD83
 N:4413781.1
 E:526134.4
 NAD83, WV NORTH
 N:502565.47
 E:1633285.71

PERMITTED APPROX. LANDING POINT
 UTM 17-NAD83
 N:4413863.41
 E:526224.93
 NAD83, WV NORTH
 N:502174.20
 E:1633576.19

AS DRILLED PLAT

AS DRILLED BOTTOM HOLE LOCATION (BHL)
 UTM 17-NAD83
 N:4415264.0
 E:524946.6
 NAD83, WV NORTH
 N:507496.61
 E:1629469.20

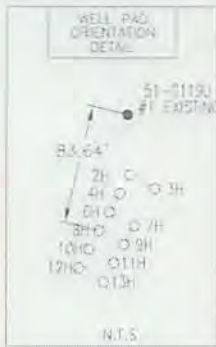

LEGEND

- TOP MAP POINT
- WELL
- ALL WELLS UNLESS OTHERWISE NOTED
- LEASE LETTER
- MINERAL TRACT BOUNDARY
- PARCEL LINES
- WELL REFERENCE
- PROPOSED HORIZONTAL WELL
- ROAD
- STREAM CENTER LINE
- AS DRILLED
- EXISTING WELLS
- EXISTING WELLS
- PLUGGED WELLS

| LINE | BEARING | DISTANCE |
|------|---------------|----------|
| R1 | S 73°23'52" W | 121.13 |
| R2 | S 71°24'01" E | 130.75 |
| R3 | S 61°06'01" E | 130.95 |
| R4 | N 2°01'43" W | 2644.98 |
| R5 | N 09°16'48" W | 2001.43 |
| R6 | N 68°53'24" E | 2442.18 |

PERMITTED BOTTOM HOLE LOCATION (BHL)
 UTM 17-NAD83
 N:4415261.13
 E:524943.41
 NAD83, WV NORTH
 N:507487.42
 E:1629458.50

AS DRILLED SURFACE HOLE LOCATION (SHL)
 UTM 17-NAD83
 N:4413733.076
 E:526312.448
 NAD83, WV NORTH
 N:502398.022
 E:1633867.193

PERMITTED SURFACE HOLE LOCATION (SHL)
 UTM 17-NAD83
 N:4413733.076
 E:526312.448
 NAD83, WV NORTH
 N:502398.022
 E:1633867.193

- NOTES:**
- There are no water wells or developed springs within 250' of proposed well.
 - There are no existing buildings within 625' of proposed well.
 - Proposed well is greater than 100' from perennial stream, wetland, pond, reservoir or lake.
 - There are no native trout streams within 300' of proposed well.
 - Proposed well is greater than 1000' from surface/groundwater intake or public water supply.
 - It is not the purpose or intention of this plat to represent surveyed locations of the surface or mineral parcels depicted hereon. The location of the boundary lines, as shown, are based on record deed descriptions, field evidence found and/or tax map position, unless otherwise noted.

| PARCEL | LESSOR |
|--------|---------------------------------|
| A | BARBARA P. FRANCIS |
| B | BARBARA P. FRANCIS |
| C | BARBARA P. FRANCIS |
| D | TIMOTHY S. & SHIRLEY M. DULANEY |

Blue Mountain Inc.
 10125 MASON DIXON HIGHWAY
 BURTON, WV 26562
 PHONE: (304) 662-6486

FILE #: FRANCIS 8H-AS DRILLED
 DRAWING #: FRANCIS 8H-AS DRILLED
 SCALE: 1" = 2000'
 MINIMUM DEGREE OF ACCURACY: 1/2500
 PROVEN SOURCE OF ELEVATION: U.S.G.S. MONUMENT THOMAS 1498.81'

I, THE UNDERSIGNED, HEREBY CERTIFY THAT THIS PLAT IS CORRECT TO THE BEST OF MY KNOWLEDGE AND BELIEF AND SHOWS ALL THE INFORMATION REQUIRED BY LAW AND THE REGULATIONS ISSUED AND PRESCRIBED BY THE DEPARTMENT OF ENVIRONMENTAL PROTECTION.

Signed: *[Signature]*
 R.P.E.: _____ L.L.S.: P.S. No. 2000



(+) DENOTES LOCATION OF WELL ON UNITED STATES TOPOGRAPHIC MAPS
 WVDEP
 OFFICE OF OIL & GAS
 601 57TH STREET
 CHARLESTON, WV 25304



DATE: JUNE 23, 2015
 OPERATOR'S WELL #: FRANCIS 8H-AS DRILLED
 API WELL #: 47 51 01715
 STATE COUNTY PERMIT

Well Type: Oil Waste Disposal Production Deep
 Gas Liquid Injection Storage Shallow

WATERSHED: MIDDLE GRAVE CREEK ELEVATION: 1260.91'

COUNTY/DISTRICT: MARSHALL / CLAY QUADRANGLE: GLEN EASTON, WV 7.5'

SURFACE OWNER: WILLIAMS OHIO VALLEY MIDSTREAM, LLC ACREAGE: 70.41±

OIL & GAS ROYALTY OWNER: BARBARA P. FRANCIS ACREAGE: 371.245±

DRILL CONVERT DRILL DEEPER REDRILL FRACTURE OR STIMULATE
 PLUG OFF OLD FORMATION PERFORATE NEW FORMATION PLUG & ABANDON
 CLEAN OUT & REPLUG OTHER CHANGE (SPECIFY): _____

TARGET FORMATION: MARCELLUS ESTIMATED DEPTH: TVD: 6,512'± TMD: 13,834'±

WELL OPERATOR CHEVRON APPALACHIA, LLC DESIGNATED AGENT KENNETH E. TAWNEY

Address 800 MOUNTAIN VIEW DRIVE Address 500 LEE STREET, EAST SUITE 1600

City SMITHFIELD State PA Zip Code 15478 City CHARLESTON State WV Zip Code 25301-3202

10/23/2015