

# AS DRILLED PLAT

BHL is located on topo map 12,699 feet south of Latitude: 39° 52' 30"  
 SHL is located on topo map 6,619 feet south of Latitude: 39° 52' 30"

LINE	BEARING	DISTANCE
R1	S 35°06'35" W	277.63'
R2	N 30°21'34" E	115.21'
R3	N 77°16'53" E	88.76'
R4	N 68°59'41" W	1037.13'
R5	S 46°20'12" W	763.79'
R6	S 0°55'19" E	1086.53'

**PERMITTED SURFACE HOLE LOCATION (SHL)**  
 UTM 17-NAD83(M)  
 N:4411913.39  
 E:526707.48  
 NAD 83, WV NORTH  
 N:498405.08  
 E:1635063.68  
 LAT/LON DATUM=NAD83  
 LAT:39.856828  
 LON:-80.687789

**PERMITTED APPROX. LANDING POINT**  
 UTM 17-NAD83(M)  
 N:4412001.48  
 E:527172.32  
 NAD 83, WV NORTH  
 N:496688.62  
 E:1636593.87  
 LAT/LON DATUM=NAD83  
 LAT:39.857608  
 LON:-80.682333

**AS DRILLED APPROX. LANDING POINT**  
 UTM 17-NAD83(M)  
 N:4412008.54  
 E:527154.93  
 NAD 83, WV NORTH  
 N:496692.77  
 E:1636637.20  
 LAT/LON DATUM=NAD83  
 LAT:39.857672  
 LON:-80.682536




**LEGEND**

- GRID MAP POINT
- WELL
- ALL ARC POINTS UNLESS OTHERWISE NOTED
- MINERAL TRACT BOUNDARY
- PARCEL LINE
- WELL REFERENCE
- PROPOSED HORIZONTAL WELL
- AS DRILLED
- ROAD
- STREAM CENTER LINE
- LESSORS
- SURFACE OWNERS
- GAS WELLS
- EXISTING WELLS
- PLUGGED WELLS

- NOTES:**
- There are no water wells or developed springs within 250' of proposed well.
  - There are no existing buildings within 625' of proposed well.
  - Proposed well pad is within 100' from perennial stream, wetland, pond, reservoir or lake.
  - There are no native trout streams within 300' of proposed well.
  - Proposed well is greater than 1000' from surface/groundwater intake or public water supply.
  - It is not the purpose or intention of this plat to represent surveyed locations of the surface or mineral parcels depicted hereon. The location of the boundary lines, as shown, are based on record deed descriptions, field evidence found and/or tax map position, unless otherwise noted.

**Blue Mountain Inc.**  
 10125 MASON DIXON HIGHWAY  
 BURTON, WV 26562  
 PHONE: (304) 662-6486

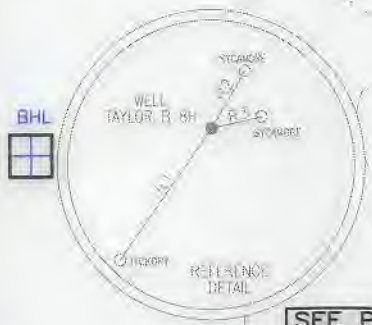

SEE PAGE 2 FOR SURFACE OWNERS AND LESSORS

**AS DRILLED BOTTOM HOLE LOCATION (BHL)**  
 UTM 17-NAD83(M)  
 N:4410078.27  
 E:528749.14  
 NAD 83, WV NORTH  
 N:490271.14  
 E:1641662.70  
 LAT/LON DATUM=NAD83  
 LAT:39.840228  
 LON:-80.663983

**PERMITTED BOTTOM HOLE LOCATION (BHL)**  
 UTM 17-NAD83(M)  
 N:4410068.51  
 E:528764.30  
 NAD 83, WV NORTH  
 N:490238.29  
 E:1641711.89  
 LAT/LON DATUM=NAD83  
 LAT:39.840139  
 LON:-80.663806

BHL is located on topo map 10,896 feet west of Longitude: 80° 37' 30"  
 SHL is located on topo map 5,924 feet west of Longitude: 80° 40' 00"

FILE #: TAYLOR B 8H-AS DRILLED  
 DRAWING #: TAYLOR B 8H-AS DRILLED  
 SCALE: 1" = 2000'  
 MINIMUM DEGREE OF ACCURACY: 1/2500  
 PROVEN SOURCE OF ELEVATION: U.S.G.S. MONUMENT THOMAS 1498.81'

I, THE UNDERSIGNED, HEREBY CERTIFY THAT THIS PLAT IS CORRECT TO THE BEST OF MY KNOWLEDGE AND BELIEF AND SHOWS ALL THE INFORMATION REQUIRED BY LAW AND THE REGULATIONS ISSUED AND PRESCRIBED BY THE DEPARTMENT OF ENVIRONMENTAL PROTECTION.

Signed: George D. Six  
 R.P.E.: \_\_\_\_\_ L.L.S.: P.S. No. 2000

**GEORGE D SIX LICENSED No. 2000 STATE OF WEST VIRGINIA PROFESSIONAL SURVEYOR**

PLACE SEAL HERE

(+) DENOTES LOCATION OF WELL ON UNITED STATES TOPOGRAPHIC MAPS WVDEP  
 OFFICE OF OIL & GAS  
 601 57TH STREET  
 CHARLESTON, WV 25304



DATE: JANUARY 08, 2018  
 OPERATOR'S WELL #: TAYLOR B 8H-AS DRILLED  
 API WELL #: 47 51 **01798**  
 STATE COUNTY PERMIT

Well Type:  Oil  Waste Disposal  Production  Deep  Gas  Liquid Injection  Storage  Shallow

WATERSHED: MIDDLE GRAVE CREEK-GRAVE CREEK ELEVATION: 1222.00'

COUNTY/DISTRICT: MARSHALL / CLAY QUADRANGLE: GLEN EASTON, WV 7.5'

SURFACE OWNER: WILLIAMS OHIO VALLEY MIDSTREAM LLC ACREAGE: 91.93±

OIL & GAS ROYALTY OWNER: LEE R. & SHERRI L. TAYLOR ACREAGE: 760.188±

DRILL  CONVERT  DRILL DEEPER  REDRILL  FRACTURE OR STIMULATE  PLUG OFF OLD FORMATION

PERFORATE NEW FORMATION  PLUG & ABANDON  CLEAN OUT & REPLUG  OTHER CHANGE

(SPECIFY): AS DRILLED

TARGET FORMATION: MARCELLUS ESTIMATED DEPTH: TVD: 6,533'± TMD: 15,963.03'±

WELL OPERATOR: CHEVRON APPALACHIA, LLC DESIGNATED AGENT: KENNETH E. TAWNEY  
 Address: 700 CHERRINGTON PARKWAY Address: 500 LEE STREET, EAST SUITE 1600  
 City: CORAOPOLIS State: PA Zip Code: 15108 City: CHARLESTON State: WV Zip Code: 25301-3202



TAYLOR B  
8H  
PAGE 2 OF 2

03/29/2019

AS DRILLED PLAT

	SURFACE OWNER	DIST-TM/PAR
1	WILLIAMS OHIO VALLEY MIDSTREAM LLC	4-10/20
2	JAMES D. RULONG	4-9/20
3	HUBERT & ANDREA KUHN	3-12/3
4	MARY T. HARDMAN	3-12/3.2
5	JOHN A. BUNGARD	3-12/4
6	TRACIE L. WEST, ET AL	9-2/5
7	ROBERT W. ZIRKLE, ET AL	3-12/5
8	ROBERT W. ZIRKLE	3-12/5.1
9	CONSOLIDATION COAL COMPANY	3-12/28

	LESSOR
A	LEE R. & SHERRI L. TAYLOR
B	CLARENCE RULONG
C	HUBERT & ANDREA KUHN
D	MARY T. HARDMAN
E	JOHN A. BUNGARD
F	TRACIE J. WEST
G	ROBERT W. & SABRINA ZIRKLE
H	ROBERT W. & SABRINA ZIRKLE
J	CNX GAS COMPANY, LLC

PERMITTED SURFACE HOLE LOCATION (SHL)	PERMITTED APPROX. LANDING POINT	PERMITTED BOTTOM HOLE LOCATION (BHL)
UTM 17-NAD83(M) N:4411913.39 E:526707.48 NAD 83, WV NORTH N:496405.08 E:1635063.68 LAT/LON DATUM-NAD83 LAT:39.856828 LON:-80.687769	UTM 17-NAD83(M) N:4412001.48 E:527172.32 NAD 83, WV NORTH N:496668.62 E:1636593.87 LAT/LON DATUM-NAD83 LAT:39.857608 LON:-80.682333	UTM 17-NAD83(M) N:4410068.51 E:528764.30 NAD 83, WV NORTH N:490238.29 E:1641711.89 LAT/LON DATUM-NAD83 LAT:39.840139 LON:-80.663806

AS DRILLED SURFACE HOLE LOCATION (SHL)	AS DRILLED APPROX. LANDING POINT	AS DRILLED BOTTOM HOLE LOCATION (BHL)
UTM 17-NAD83(M) N:4411913.39 E:526707.48 NAD 83, WV NORTH N:496405.08 E:1635063.68 LAT/LON DATUM-NAD83 LAT:39.856828 LON:-80.687769	UTM 17-NAD83(M) N:4412008.54 E:527154.93 NAD 83, WV NORTH N:496692.77 E:1636537.20 LAT/LON DATUM-NAD83 LAT:39.857672 LON:-80.682536	UTM 17-NAD83(M) N:4410078.27 E:528749.14 NAD 83, WV NORTH N:490271.14 E:1641662.70 LAT/LON DATUM-NAD83 LAT:39.840228 LON:-80.663983

JANUARY 08, 2018