
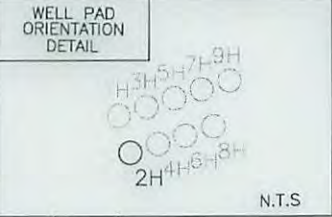


SEE PAGE 2 FOR SURFACE OWNERS AND LESSORS

Well is located on topo map 8,467 feet south of Latitude: 39° 52' 30"

LINE	BEARING	DISTANCE
R1	S 64°08'48" W	66.64'
R2	S 75°54'24" E	134.07'
R3	N 38°10'49" E	110.59'
R4	N 24°41'55" E	1079.02'
R5	N 86°09'30" E	766.30'
R6	S 60°13'45" W	1628.64'

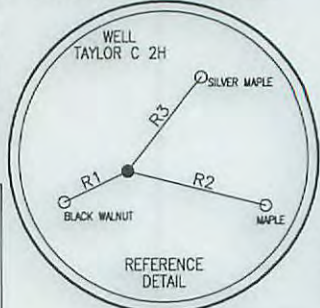

**SURFACE HOLE LOCATION (SHL)**

UTM 17-NAD83  
 N:4411347.47  
 E:525881.62  
 NAD 83, WV NORTH  
 N:494593.31  
 E:1632322.59  
 LAT/LON DATUM-NAD83  
 LAT:39.851755  
 LON:-80.697447

**APPROX. LANDING POINT**

UTM 17-NAD83  
 N:4411053.21  
 E:525829.53  
 NAD 83, WV NORTH  
 N:493630.55  
 E:1632135.51  
 LAT/LON DATUM-NAD83  
 LAT:39.849105  
 LON:-80.698067

**BOTTOM HOLE LOCATION (BHL)**

UTM 17-NAD83  
 N:4409362.71  
 E:527222.44  
 NAD 83, WV NORTH  
 N:488006.81  
 E:1636613.62  
 LAT/LON DATUM-NAD83  
 LAT:39.833831  
 LON:-80.681856

**LEGEND**

- ⊕ - TOPO MAP POINT
- ⊙ - WELL
- - ALL ARE POINTS UNLESS OTHERWISE NOTED
- - MINERAL TRACT BOUNDARY
- - - - - PARCEL LINES
- - - - - WELL REFERENCE
- - - - - PROPOSED HORIZONTAL WELL
- - - - - ROAD
- - - - - STREAM CENTER LINE
- Ⓐ - LESSORS
- ① - SURFACE OWNERS

**GAS WELLS**

- - EXISTING WELLS
- ⦿ - PLUGGED WELLS

- NOTES:**
1. There are no water wells or developed springs within 250' of proposed well.
  2. There are no existing buildings within 625' of proposed well.
  3. Proposed well pad is within 100' from perennial stream, wetland, pond, reservoir or lake.
  4. There are no native trout streams within 300' of proposed well.
  5. Proposed well is greater than 1000' from surface/groundwater intake or public water supply.
  6. It is not the purpose or intention of this plat to represent surveyed locations of the surface or mineral parcels depicted hereon. The location of the boundary lines, as shown, are based on record deed descriptions, field evidence found and/or tax map position, unless otherwise noted.

**Blue Mountain Inc.**  
 11023 MASON DIXON HIGHWAY  
 BURTON, WV 26562  
 PHONE: (304) 662-6486

Well is located on topo map 8,641 feet west of Longitude: 80° 40' 00"

FILE #: TAYLOR C 2H  
 DRAWING #: TAYLOR C 2H  
 SCALE: 1" = 2000'  
 MINIMUM DEGREE OF ACCURACY: 1/2500  
 PROVEN SOURCE OF ELEVATION: U.S.G.S. MONUMENT THOMAS 1498.81'

I, THE UNDERSIGNED, HEREBY CERTIFY THAT THIS PLAT IS CORRECT TO THE BEST OF MY KNOWLEDGE AND BELIEF AND SHOWS ALL THE INFORMATION REQUIRED BY LAW AND THE REGULATIONS ISSUED AND PRESCRIBED BY THE DEPARTMENT OF ENVIRONMENTAL PROTECTION.

Signed: *George D. Six*  
 R.P.E.: \_\_\_\_\_ L.L.S.: P.S. No. 2000

**GEORGE D. SIX**  
 LICENSED  
 No. 2000  
 STATE OF WEST VIRGINIA  
 PROFESSIONAL SURVEYOR

PLACE SEAL HERE

(+) DENOTES LOCATION OF WELL ON UNITED STATES TOPOGRAPHIC MAPS WVDEP  
 OFFICE OF OIL & GAS  
 601 57TH STREET  
 CHARLESTON, WV 25304

DATE: DECEMBER 1, 2015  
 OPERATOR'S WELL #: TAYLOR C 2H  
 API WELL #: 47 51 **01801 P**  
 STATE COUNTY PERMIT

Well Type:  Oil  Waste Disposal  Production  Deep  
 Gas  Liquid Injection  Storage  Shallow

WATERSHED: MIDDLE GRAVE CREEK - GRAVE CREEK ELEVATION: 1257.00'

COUNTY/DISTRICT: MARSHALL / CLAY QUADRANGLE: GLEN EASTON, WV 7.5'

SURFACE OWNER: WILLIAMS OHIO VALLEY MIDSTREAM LLC ACREAGE: 265.439±

OIL & GAS ROYALTY OWNER: LEE R. & SHERRI L. TAYLOR ACREAGE: 741.135±

DRILL  CONVERT  DRILL DEEPER  REDRILL  FRACTURE OR STIMULATE   
 PLUG OFF OLD FORMATION  PERFORATE NEW FORMATION  PLUG & ABANDON   
 CLEAN OUT & REPLUG  OTHER CHANGE  (SPECIFY): \_\_\_\_\_

TARGET FORMATION: MARCELLUS ESTIMATED DEPTH: TVD: 6,555'± TMD: 14,376.3'±

WELL OPERATOR CHEVRON APPALACHIA, LLC DESIGNATED AGENT KENNETH E. TAWNEY  
 Address 800 MOUNTAIN VIEW DRIVE Address 500 LEE STREET, EAST SUITE 1600  
 City SMITHFIELD State PA Zip Code 15478 City CHARLESTON State WV Zip Code 25301-3202

03/25/2016

# TAYLOR C

## 2H

### PAGE 2 OF 2

	SURFACE OWNER	DIST-TM/PAR
1	WILLIAMS OHIO VALLEY MIDSTREAM LLC	4-10/21
2	ROBERT MORRIS SULLIVAN	4-10/15
3	ROBERT MORRIS SULLIVAN	4-10/22
4	DAVID SHAWN CONNER	4-10/16
5	MURRAY ENERGY	4-10/23
6	CNX LAND RESOURCES INC.	9-2/3
7	GEORGE B. & MARY L. CROW	9-2/6
8	CNX LAND, LLC	9-2/12.1
9	HARRY J. CRAWFORD ET UX - LIFE	9-2/12

	LESSOR
A	LEE R. & SHERRI L. TAYLOR
B	ROBERT MORRIS SULLIVAN
C	ROBERT MORRIS SULLIVAN
D	DAVID SHAWN CONNER
E	CONSOL
F	OKEY D. & JANINA A. BURTON
G	ROSS AVENUE MINERALS 2012, LLC BELMONT ROYALTY AND MINERALS 2012, LLC
H	HARRY J. CRAWFORD ET AL
J	HARRY J. CRAWFORD ET AL

SURFACE HOLE LOCATION (SHL)
UTM_17-NAD83
N:4411347.47
E:525881.62
NAD_83_WV_NORTH
N:494593.31
E:1632322.59
LAT/LON_DATUM-NAD83
LAT:39.851755
LON:-80.697447

APPROX. LANDING POINT
UTM_17-NAD83
N:4411053.21
E:525829.53
NAD_83_WV_NORTH
N:493630.55
E:1632135.51
LAT/LON_DATUM-NAD83
LAT:39.849105
LON:-80.698067

BOTTOM HOLE LOCATION (BHL)
UTM_17-NAD83
N:4409362.71
E:527222.44
NAD_83_WV_NORTH
N:488006.81
E:1636613.62
LAT/LON_DATUM-NAD83
LAT:39.833831
LON:-80.681856

03/25/2016

DECEMBER 1, 2015