

**PERMITTED
BOTTOM HOLE LOCATION (BHL)**
UTM 17-NAD83(M)
N:4413306.21
E:525980.92
NAD 83, WV NORTH
N:501015.46
E:1632755.88
LAT/LON DATUM-NAD83
LAT:39.869400
LON:-80.696208

**AS-DRILLED
BOTTOM HOLE LOCATION (BHL)**
UTM 17-NAD83(M)
N:4413301.72
E:525975.50
NAD 83, WV NORTH
N:501001.01
E:1632737.84
LAT/LON DATUM-NAD83
LAT:39.869361
LON:-80.696272

BHL is located on topo map 2,040 feet south of Latitude: 39 ° 52 ' 30 "
SHL is located on topo map 6,609 feet south of Latitude: 39 ° 52 ' 30 "

- NOTES:
1. There are no water wells or developed springs within 250' of proposed well.
 2. There are no existing buildings within 625' of proposed well.
 3. Proposed well pad is within 100' from perennial stream, wetland, pond, reservoir or lake.
 4. There are no native trout streams within 300' of proposed well.
 5. Proposed well is greater than 1000' from surface/groundwater intake or public water supply.
 6. It is not the purpose or intention of this plat to represent surveyed locations of the surface or mineral parcels depicted hereon. The location of the boundary lines, as shown, are based on record deed descriptions, field evidence found and/or tax map position, unless otherwise noted.

LEGEND

- ⊕ - TOPO MAP POINT
- ⊙ - WELL
- - ALL ARE POINTS UNLESS OTHERWISE NOTED.
- - - - - MINERAL TRACT BOUNDARY
- - - - - PARCEL LINES
- - - - - WELL REFERENCE
- - - - - PROPOSED HORIZONTAL WELL
- - - - - ROAD
- - - - - STREAM CENTER LINE
- (A) - LESSORS
- (1) - SURFACE OWNERS


GAS WELLS

- - EXISTING WELLS
- - PLUGGED WELLS

BHL is located on topo map 8,292 feet west of Longitude: 80 ° 40 ' 00 "
SHL is located on topo map 5,968 feet west of Longitude: 80 ° 40 ' 00 "



**AS DRILLED
PLAT**

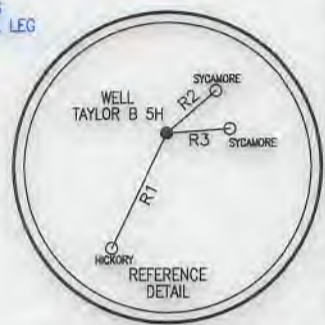

LINE	BEARING	DISTANCE
R1	S 25°58'21" W	264.61'
R2	N 49°06'57" E	135.24'
R3	N 86°03'27" E	131.59'
R4	N 68°39'59" W	993.10'
R5	S 43°24'04" W	740.51'
R6	S 05°12'33" E	1080.59'

SEE PAGE 2 FOR SURFACE OWNERS AND LESSORS


Blue Mountain Inc.
11023 MASON DIXON HIGHWAY
BURTON, WV 26562
PHONE: (304) 662-6486

**PERMITTED
SURFACE HOLE LOCATION (SHL)**
UTM 17-NAD83(M)
N:4411916.44
E:526694.11
NAD 83, WV NORTH
N:496415.80
E:1635019.95
LAT/LON DATUM-NAD83
LAT:39.856856
LON:-80.687925

**AS-DRILLED
SURFACE HOLE LOCATION (SHL)**
UTM 17-NAD83(M)
N:4411916.44
E:526694.11
NAD 83, WV NORTH
N:496415.80
E:1635019.95
LAT/LON DATUM-NAD83
LAT:39.856856
LON:-80.687925

**PERMITTED
APPROX. LANDING POINT**
UTM 17-NAD83(M)
N:4412313.11
E:526802.89
NAD 83, WV NORTH
N:497711.51
E:1635398.67
LAT/LON DATUM-NAD83
LAT:39.860428
LON:-80.688639

**AS-DRILLED
APPROX. LANDING POINT**
UTM 17-NAD83(M)
N:4412312.31
E:526804.14
NAD 83, WV NORTH
N:497708.82
E:1635402.74
LAT/LON DATUM-NAD83
LAT:39.860419
LON:-80.688622

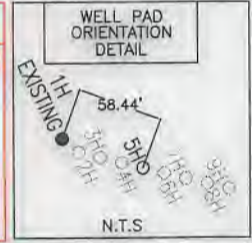

FILE #: TAYLOR B 5H - AS-DRILLED
DRAWING #: TAYLOR B 5H - AS-DRILLED
SCALE: 1" = 2000'
MINIMUM DEGREE OF ACCURACY: 1/2500
PROVEN SOURCE OF ELEVATION: U.S.G.S. MONUMENT THOMAS 1498.81'

I, THE UNDERSIGNED, HEREBY CERTIFY THAT THIS PLAT IS CORRECT TO THE BEST OF MY KNOWLEDGE AND BELIEF AND SHOWS ALL THE INFORMATION REQUIRED BY LAW AND THE REGULATIONS ISSUED AND PRESCRIBED BY THE DEPARTMENT OF ENVIRONMENTAL PROTECTION.

Signed: *George D. Six*

R.P.E.: _____ L.L.S.: P.S. No. 2000



(+) DENOTES LOCATION OF WELL ON UNITED STATES TOPOGRAPHIC MAPS WVDEP
OFFICE OF OIL & GAS
601 57TH STREET
CHARLESTON, WV 25304



DATE: MARCH 12, 2018
OPERATOR'S WELL #: TAYLOR B 5H - AS-DRILLED
API WELL #: 47 51 01823
STATE COUNTY PERMIT

Well Type: Oil Waste Disposal Production Deep Gas Liquid Injection Storage Shallow

WATERSHED: MIDDLE GRAVE CREEK-GRAVE CREEK ELEVATION: 1222.00'

COUNTY/DISTRICT: MARSHALL / CLAY QUADRANGLE: GLEN EASTON, WV 7.5'

SURFACE OWNER: WILLIAMS OHIO VALLEY MIDSTREAM LLC ACREAGE: 91.93±

OIL & GAS ROYALTY OWNER: LEE R. & SHERRI L. TAYLOR ACREAGE: 637.717±

DRILL CONVERT DRILL DEEPER REDRILL FRACTURE OR STIMULATE PLUG OFF OLD FORMATION
PERFORATE NEW FORMATION PLUG & ABANDON CLEAN OUT & REPLUG OTHER CHANGE

(SPECIFY): TARGET FORMATION: MARCELLUS ESTIMATED DEPTH: TVD: 6,533'± TMD: 11,830.88'±

WELL OPERATOR CHEVRON APPALACHIA, LLC DESIGNATED AGENT KENNETH E. TAWNEY
Address 700 CHERRINGTON PARKWAY Address 500 LEE STREET, EAST SUITE 1600
City CORAOPOLIS State PA Zip Code 15108 City CHARLESTON State WV Zip Code 25301-3202

**AS DRILLED
PLAT**

**TAYLOR B
5H
PAGE 2 OF 2**

03/29/2019

	SURFACE OWNER	DIST-TM/PAR
1	WILLIAMS OHIO VALLEY MIDSTREAM LLC	4-10/20
2	JAMES D. RULONG	4-9/20
3	LEE R. TAYLOR ET UX	4-10/21
4	KENNETH L. McCRACKEN ET UX	4-9/23.5
5	WILLIAM R. STANDIFORD ET UX	4-9/23.3
6	DONALD E. VAN SCYOC ET UX	4-9/23.2
7	WILLIAMS OHIO VALLEY MIDSTREAM	4-9/25
8	WILLIAM R. STANDIFORD ET UX	4-9/5.1
9	RONALD A. HILL	4-9/5

	LESSOR
A	LEE R. & SHERRI L. TAYLOR
B	CLARENCE RULONG
C	LEE R. & SHERRI L. TAYLOR
D	KENNETH L. & SHIRLEY J. MCCRACKEN
E	WILLIAM ROGER STANDIFORD
F	DONALD E. VAN SCYOC
G	DONALD E. VAN SCYOC
H	WILLIAM ROGER STANDIFORD
J	RONALD A. HILL, ET AL

PERMITTED SURFACE HOLE LOCATION (SHL)
UTM 17-NAD83(M) N:4411916.44 E:526694.11 NAD 83, WV NORTH N:496415.80 E:1635019.95 LAT/LON DATUM-NAD83 LAT:39.856856 LON:-80.687925

PERMITTED APPROX. LANDING POINT
UTM 17-NAD83(M) N:4412313.11 E:526802.89 NAD 83, WV NORTH N:497711.51 E:1635398.67 LAT/LON DATUM-NAD83 LAT:39.860428 LON:-80.686639

PERMITTED BOTTOM HOLE LOCATION (BHL)
UTM 17-NAD83(M) N:4413306.21 E:525980.92 NAD 83, WV NORTH N:501015.46 E:1632755.88 LAT/LON DATUM-NAD83 LAT:39.869400 LON:-80.696208

AS-DRILLED SURFACE HOLE LOCATION (SHL)
UTM 17-NAD83(M) N:4411916.44 E:526694.11 NAD 83, WV NORTH N:496415.80 E:1635019.95 LAT/LON DATUM-NAD83 LAT:39.856856 LON:-80.687925

AS-DRILLED APPROX. LANDING POINT
UTM 17-NAD83(M) N:4412312.31 E:526804.14 NAD 83, WV NORTH N:497708.82 E:1635402.74 LAT/LON DATUM-NAD83 LAT:39.860419 LON:-80.686622

AS-DRILLED BOTTOM HOLE LOCATION (BHL)
UTM 17-NAD83(M) N:4413301.72 E:525975.50 NAD 83, WV NORTH N:501001.01 E:1632737.84 LAT/LON DATUM-NAD83 LAT:39.869361 LON:-80.696272