

BHL is located on topo map 8,797 feet south of Latitude: 39° 55' 00"
 SHL is located on topo map 1,207 feet south of Latitude: 39° 52' 30"


SEE PAGE 2 AND 3 FOR SURFACE OWNERS AND LESSORS



AS DRILLED PLAT

NOTES:

- There are no water wells or developed springs within 250' of proposed well.
- Proposed well is greater than 100' from perennial stream, wetland, pond, reservoir or lake.
- There are no native trout streams within 300' of proposed well.
- Proposed well is greater than 1000' from surface groundwater intake or public water supply.
- It is not the purpose or intention of this plat to represent surveyed locations of the surface or mineral parcels depicted hereon. The location of the boundary lines, as shown, are based on record deed descriptions, field evidence found and/or tax map position, unless otherwise noted.
- There are no existing buildings within 625' of proposed well.

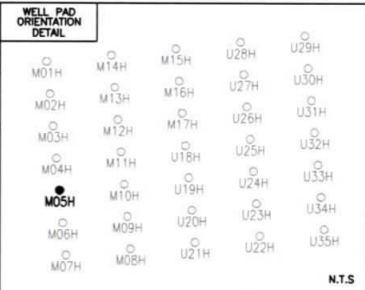

LEGEND

- TOPO MAP POINT
- WELL
- ALL ARE POINTS UNLESS OTHERWISE NOTED.
- MINERAL TRACT
- BOUNDARY - PARCEL LINES
- WELL REFERENCE
- AS-DRILLED LATERAL
- PROPOSED HORIZONTAL WELL
- ROAD
- STREAM CENTER LINE
- LESSORS
- SURFACE OWNERS
- GAS WELLS**
- EXISTING WELLS
- PLUGGED WELLS

PERMITTED
BOTTOM HOLE LOCATION (BHL)
UTM 17-NAD83(M)
N:4415855.58
E:520648.80
NAD83, WV NORTH
N:509673.681
E:1615398.330
LAT/LON-NAD83
LAT:39°53'33.06"
LON:80°45'30.51"

AS DRILLED
BOTTOM HOLE LOCATION (BHL)
UTM 17-NAD83(M)
N:4415857.64
E:520651.17
NAD83, WV NORTH
N:509680.310
E:1615406.230
LAT/LON-NAD83
LAT:39°53'33.125"
LON:80°45'30.410"

PERMITTED
APPROX. LANDING POINT
UTM 17-NAD83(M)
N:4413310.97
E:523223.48
NAD83, WV NORTH
N:501182.302
E:1623707.591
LAT/LON-NAD83
LAT:39°52'10.28"
LON:80°43'42.42"

AS DRILLED
APPROX. LANDING POINT
UTM 17-NAD83(M)
N:4413311.97
E:523217.29
NAD83, WV NORTH
N:501185.940
E:1623687.330
LAT/LON-NAD83
LAT:39°52'10.315"
LON:80°43'42.681"

LINE	BEARING	DISTANCE
R1	N 45°01'13" E	193.51'
R2	N 23°26'37" E	148.00'
R3	N 10°13'33" W	147.12'
R4	N 13°30'58" W	1333.16'
R5	N 37°29'14" E	1110.96'
R6	S 00°41'31" W	1099.05'

THRASHER

CIVIL • ENVIRONMENTAL • CONSULTING • FIELD SERVICES
 600 WHITE OAKS BOULEVARD, BRIDGEPORT, WV 26330
 PHONE (304) 624-4108 FAX (304) 624-7831

FILE #: HICKS M05H-AS DRILLED
 DRAWING #: HICKS M05H-AS DRILLED
 SCALE: 1" = 2000'
 MINIMUM DEGREE OF ACCURACY: 1/2500
 PROVEN SOURCE OF ELEVATION: U.S.G.S. MONUMENT THOMAS 1498.81'

I, THE UNDERSIGNED, HEREBY CERTIFY THAT THIS PLAT IS CORRECT TO THE BEST OF MY KNOWLEDGE AND BELIEF AND SHOWS ALL THE INFORMATION REQUIRED BY LAW AND THE REGULATIONS ISSUED AND PRESCRIBED BY THE DEPARTMENT OF ENVIRONMENTAL PROTECTION.

Signed: *George D. Six*

R.P.E.: _____ L.L.S.: P.S. No. 2000



PLACE SEAL HERE

(+) DENOTES LOCATION OF WELL ON UNITED STATES TOPOGRAPHIC MAPS WVDEP
 OFFICE OF OIL & GAS
 601 57TH STREET
 CHARLESTON, WV 25304



DATE: JANUARY 31, 2020
 OPERATOR'S WELL #: HICKS M05H-AS DRILLED
 API WELL #: 47 51 01913
 STATE COUNTY PERMIT

Well Type: Oil Waste Disposal Production Deep Gas Liquid Injection Storage Shallow

WATERSHED: MIDDLE GRAVE CREEK-GRAVE CREEK ELEVATION: 1178.56'

COUNTY/DISTRICT: MARSHALL / CLAY QUADRANGLE: GLEN EASTON, WV 7.5'

SURFACE OWNER: THOMAS E. HICKS ACREAGE: 172.100±

OIL & GAS ROYALTY OWNER: CHRISTA DAWN HICKS, ET AL ACREAGE: 876.401±

DRILL CONVERT DRILL DEEPER REDRILL FRACTURE OR STIMULATE PLUG OFF OLD FORMATION
 PERFORATE NEW FORMATION PLUG & ABANDON CLEAN OUT & REPLUG OTHER CHANGE

(SPECIFY): AS DRILLED

TARGET FORMATION: MARCELLUS ESTIMATED DEPTH: TVD: 6,600'± TMD: 20,256.76'±

WELL OPERATOR CHEVRON APPALACHIA, LLC DESIGNATED AGENT KENNETH E. TAWNEY
 Address 800 MOUNTAIN VIEW DRIVE Address 500 LEE STREET, EAST SUITE 1600
 City SMITHFIELD State PA Zip Code 15478 City CHARLESTON State WV Zip Code 25301-3202

BHL is located on topo map 2,378 feet west of Longitude: 80° 42' 30"
 SHL is located on topo map 2,784 feet west of Longitude: 80° 42' 30"



HICKS M05H PAGE 2 OF 3 AS DRILLED PLAT

	SURFACE OWNER	DIST-TM/PAR
1	THOMAS E. HICKS	4-8/37
2	LILLIE LAVERN GAREY	4-8/36
3	VICKIE L. & SIDNEY P. POND	4-8/36.1
4	CONSOLIDATION COAL COMPANY/MURRAY ENERGY C/O LAND DEPT	4-12/25
5	SIDNEY P. POND ET UX	4-8/36.2
6	MABEL JUANITA WILLIAMS	4-8/23
7	HENRY W. & LINDA M. ASTON - LIFE	4-8/19
8	BONAR FAMILY IRREVOCABLE TR	4-8/18
9	HENRY W. & LINDA M. ASTON - LIFE	4-8/17
10	CAROL ANN JORDAN	4-8/15
11	CHARLES W. JR. & JUDY MERCER	4-8/16
12	MARY E. & JANET C. PERSINGER	4-5/54.1
13	MARSHALL CO AIRPORT AUTHORITY	4-5/54.3
14	BRADLEY C. RINE	4-5/52
15	BRENDA FAYE RINE	4-5/52.1
16	BRENDA FAYE RINE	4-5/52.2
17	GREGORY E. & SUELYNN E. HOWE	4-5/51.1
18	ETHEL FAYE HOWE	4-5/51
19	BRADLEY C. RINE	4-5/50.5
20	GEOFFREY ERIC HOWE	4-5/50
21	ROBERT P. CARNAHAN ET UX	4-5/50.4
22	SARAH J. KNABENSHUE ET AL	4-5/56
23	CLEMENT R. & NANCY L. SHUTLER	4-5/56.3
24	SETH C. WEEKLY	4-5/57.1
25	HALI R. & JASON R. PORTER	4-5/57
26	*WANDA BLAKE - LIFE	4-5B/1
27	CURTIS W. ALLEN ET UX	4-5/26.1
28	JAMES COFER ET UX	4-5/25
29	LOREN F. CECIL ET UX - LIFE	4-5/24
30	LOREN F. CECIL ET UX - LIFE	4-5/21
31	*ROSALIE G. UTTER	4-5/20
32	WYNN T. MURPHY ET UX	4-2/29.2
33	WYNN T. MURPHY ET UX	4-2/29.4
34	*NORMA LEE CHAMBERS	4-2/29.8
35	JOSEPH L. & CHRISTEN R. BLAKE	4-2/27
36	*DONNIE K MASTERS ET UX	4-2/28
37	ALLEN NORMAN	4-2/27.1

PERMITTED SURFACE HOLE LOCATION (SHL)
UTM 17-NAD83(M)
N:4413553.919
E:524094.936
NAD83, WV NORTH
N:501931.752
E:1626580.602
LAT/LON-NAD83
LAT:39°52'18.075"
LON:80°43'05.706"

PERMITTED APPROX. LANDING POINT
UTM 17-NAD83(M)
N:4413310.97
E:523223.48
NAD83, WV NORTH
N:501182.302
E:1623707.591
LAT/LON-NAD83
LAT:39°52'10.28"
LON:80°43'42.42"

PERMITTED BOTTOM HOLE LOCATION (BHL)
UTM 17-NAD83(M)
N:4415855.58
E:520648.80
NAD83, WV NORTH
N:509673.681
E:1615398.330
LAT/LON-NAD83
LAT:39°53'33.06"
LON:80°45'30.51"

AS DRILLED SURFACE HOLE LOCATION (SHL)
UTM 17-NAD83(M)
N:4413553.92
E:524094.93
NAD83, WV NORTH
N:501931.770
E:1626580.570
LAT/LON-NAD83
LAT:39°52'18.075"
LON:80°43'05.706"

AS DRILLED APPROX. LANDING POINT
UTM 17-NAD83(M)
N:4413311.97
E:523217.29
NAD83, WV NORTH
N:501185.940
E:1623687.330
LAT/LON-NAD83
LAT:39°52'10.315"
LON:80°43'42.681"

AS DRILLED BOTTOM HOLE LOCATION (BHL)
UTM 17-NAD83(M)
N:4415857.64
E:520651.17
NAD83, WV NORTH
N:509680.310
E:1615406.230
LAT/LON-NAD83
LAT:39°53'33.125"
LON:80°45'30.410"

* - DENOTES PARCEL WITHIN 30 FEET OF PLANNED WELL BORE

JANUARY 31, 2020

RECEIVED
Office of Oil and Gas

MAR 16 2020

WV Department of
Environmental Protection

THRASHER

AS DRILLED PLAT

HICKS

M05H

PAGE 3 OF 3

	LESSOR	DIST-TM/PAR
A	CHRISTA DAWN HICKS, ET AL.	4-8/37
B	LILLIE LAVERN GAREY	4-8/36
C	SIDNEY P. POND, ET UX.	4-8/36.1
D	CNX GAS COMPANY, LLC.	4-12/25
E	SIDNEY P. POND, ET UX.	4-8/36.2
F	MABEL J. WILLIAMS	4-8/23
G	HENRY ASTON, ET UX.	4-8/19
H	BONAR FAMILY IREV TRST DTD 2/12/2009	4-8/18
J	HENRY ASTON, ET UX.	4-8/17
	LEO GAMBLE	
	BILLIE D. BRENNAN	
	BARBARA RIGGLE	
	NOREEN G. MILLER, ET VIR.	
	ANNE LONG HAND, ET VIR.	
	JOHN M. GAMBLE	
	MARGARET M. VERRALL	
	LARRY MCCULLOUGH	
	MARK CARTER GAMBLE	
	CHARLES PAUL GAMBLE, ET UX.	
	CLARICE BURT	
	DONALD CARMICHAEL	
	JANE ANN DAY	
	PEGGY FILLMORE	
	BILLIE JO GARNER	
	ARDITH HOLMES	
	ELEANOR HOLMES	
	GENE LAWSON HOLMES	
	JANICE A. HOLMES	
	MARY HOLMES	
	MITCHELL R. HOLMES	
	RONALD LEMOYNE HOLMES	
	TIM HOLMES	
	VIRGINIA HOLMES	
	MYRNA LOUANN HOLSTINE	
	LYLA LORRAINE HUBBS	
	BONNIE LIBRIZZI	
	MARY LOUISE LIPSKY	
	KAREN V. MAAS	
	VERA MARIE MIDCAP	
	MAVARENE L. REDD	
	EULA RICHARDS BY AIF CAROYLN THOMPSON	
	HELEN M. RINE	
	MARILYN LAVONDA RULONG	
	VIOLET P. STANDIFORD	
	CHRISTINE A. CIOCCIA	
	SHIRLEY DULANEY	
	WILLIAM EARNEST	
	JANE ANN GAMBLE	
	JULIA GAMBLE BY AIF MARY JO DOMBROWSKI	
	HOWARD MCCARDLE	
	JOAN MILLIKEN	
	SHERWIN LEE RUCKMAN	
	BOBBI JO STARK	
	BELINDA S. WEST	
	MARY ELLEN WHIPKEY	
	ROBIN WILLIAMS	
	LLOYD ELWOOD HOLMES	
K	CAROL JORDAN	4-8/15
L	SANDRA KAY WARNER	4-8/16
	PATSY SUE BAYHA	
	HALLIE LU PETERSON	
	LUCRETIA LEE	
	DELLA K. BOONE	
	DENNIS PARSONS	
	DR. CASPER E. CLINE	
	CHARLOTTE L. STROMSLAND	
M	JOHN L. FOX	4-5/54.1
	KAREN M. FOX	
	CHRISTI F. PRESTON	
	JOHN L. FOX II	
	CYNTHIA S. HAMILTON	
	DOROTHY A. ARGENTA	
	JOAN E. KRESS	
	WILLIAM P. ARGENTA	
	PAUL T. ARGENTA	
	MARY E. PERSINGER	
	JANET C. HUNNELL	
	MICHAEL PERSINGER	
	BETH BLAKE	
	KAREN FOX EVANS	
	WILLIAM B. FOX	
	LINDA SMITH	
	ANN MILLER	

	LESSOR	DIST-TM/PAR
N	JOHN LEONARD FOX	4-5/54.3
	KAREN M. FOX	
	CHRISTI F. PRESTON	
	JOHN L. FOX II	
	CYNTHIA S. HAMILTON	
	DOROTHY A. ARGENTA	
	JOAN E. KRESS	
	WILLIAM P. ARGENTA	
	PAUL T. ARGENTA	
	MARY E. PERSINGER	
	JANET C. HUNNELL	
	MICHAEL PERSINGER	
	BETH BLAKE	
	KAREN FOX EVANS	
	BRAD FOX	
	LINDA S. SMITH	
	ANN MILLER	
P	LINDSEY E. RACKLEY	4-5/52
	ERIC HATHAWAY, ET UX.	
	ERINE HATHAWAY	
	NANCY D. RACKLEY, ET VIR.	
	KIMBERLY HATHAWAY GOBLE, ET VIR.	
	GARY LEE HATHAWAY, ET UX.	
	JUDITH KULL TRST DTD 7/31/1985	
	ELIZABETH G. KULL REV TRST DTD 10/21/1997	
	DOROTHY SEDOSKY	
	GENE DAKAN, ET UX.	
	DOLLYE GUZEK, ET VIR.	
Q	LINDSEY E. RACKLEY	4-5/51.1
	ERIC HATHAWAY, ET UX.	
	ERINE HATHAWAY	
	NANCY D. RACKLEY, ET VIR.	
	KIMBERLY HATHAWAY GOBLE, ET VIR.	
	GARY LEE HATHAWAY, ET UX.	
	JUDITH KULL TRST DTD 7/31/1985	
	ELIZABETH G. KULL REV TRST DTD 10/21/1997	
	DOROTHY SEDOSKY	
	GENE DAKAN, ET UX.	
	DOLLYE GUZEK, ET VIR.	
R	LINDSEY E. RACKLEY	4-5/51
	ERIC HATHAWAY, ET UX.	
	ERINE HATHAWAY	
	NANCY D. RACKLEY, ET VIR.	
	KIMBERLY HATHAWAY GOBLE, ET VIR.	
	GARY LEE HATHAWAY, ET UX.	
	JUDITH KULL TRST DTD 7/31/1985	
	ELIZABETH G. KULL REV TRST DTD 10/21/1997	
	DOROTHY SEDOSKY	
	GENE DAKAN, ET UX.	
	DOLLYE GUZEK, ET VIR.	
S	LINDSEY E. RACKLEY	4-5/50.5
	ERIC HATHAWAY, ET UX.	
	ERINE HATHAWAY	
	NANCY D. RACKLEY, ET VIR.	
	KIMBERLY HATHAWAY GOBLE, ET VIR.	
	GARY LEE HATHAWAY, ET UX.	
	JUDITH KULL TRST DTD 7/31/1985	
	ELIZABETH G. KULL REV TRST DTD 10/21/1997	
	DOROTHY SEDOSKY	
	GENE DAKAN, ET UX.	
	DOLLYE GUZEK, ET VIR.	
T	LINDSEY E. RACKLEY	4-5/50
	ERIC HATHAWAY, ET UX.	
	ERINE HATHAWAY	
	NANCY D. RACKLEY, ET VIR.	
	KIMBERLY HATHAWAY GOBLE, ET VIR.	
	GARY LEE HATHAWAY, ET UX.	
	JUDITH KULL TRST DTD 7/31/1985	
	ELIZABETH G. KULL REV TRST DTD 10/21/1997	
	DOROTHY SEDOSKY	
	GENE DAKAN, ET UX.	
	DOLLYE GUZEK, ET VIR.	
U	LINDSEY E. RACKLEY	4-5/50.4
	ERIC HATHAWAY, ET UX.	
	ERINE HATHAWAY	
	NANCY D. RACKLEY, ET VIR.	
	KIMBERLY HATHAWAY GOBLE, ET VIR.	
	GARY LEE HATHAWAY, ET UX.	
	JUDITH KULL TRST DTD 7/31/1985	
	ELIZABETH G. KULL REV TRST DTD 10/21/1997	
	DOROTHY SEDOSKY	
	GENE DAKAN, ET UX.	
	DOLLYE GUZEK, ET VIR.	
V	HOWARD E. CONNER, ET AL.	4-5/56
W	CLEMENT R. SHUTLER, ET UX.	4-5/56.3
X	SETH C. WEEKLY, ET UX.	4-5/57.1
Y	HILDA A. BLAKE	4-5/57
Z	*GAREN BLAKE, ET UX.	4-5B/1
AA	CURTIS ALLEN, ET UX.	4-5/26.1
BB	JAMES COFER, ET UX.	4-5/25
CC	LOREN CECIL, ET AL.	4-5/24
DD	LOREN CECIL, ET AL.	4-5/21
EE	*ROSALIE G. UTTER	4-5/20
FF	WYNN MURPHY	4-2/29.2
GG	WYNN MURPHY	4-2/29.4
HH	NORMA LEE CHAMBERS	4-2/29.8
JJ	JOSEPH BLAKE, ET UX.	4-2/27
KK	*DONNIE K. MASTERS	4-2/28

RECEIVED
Office of Oil and Gas

MAR 16 2020

WV Department of
Environmental Protection

* - DENOTES PARCEL WITHIN 30 FEET OF PLANNED WELL BORE

JANUARY 31, 2020